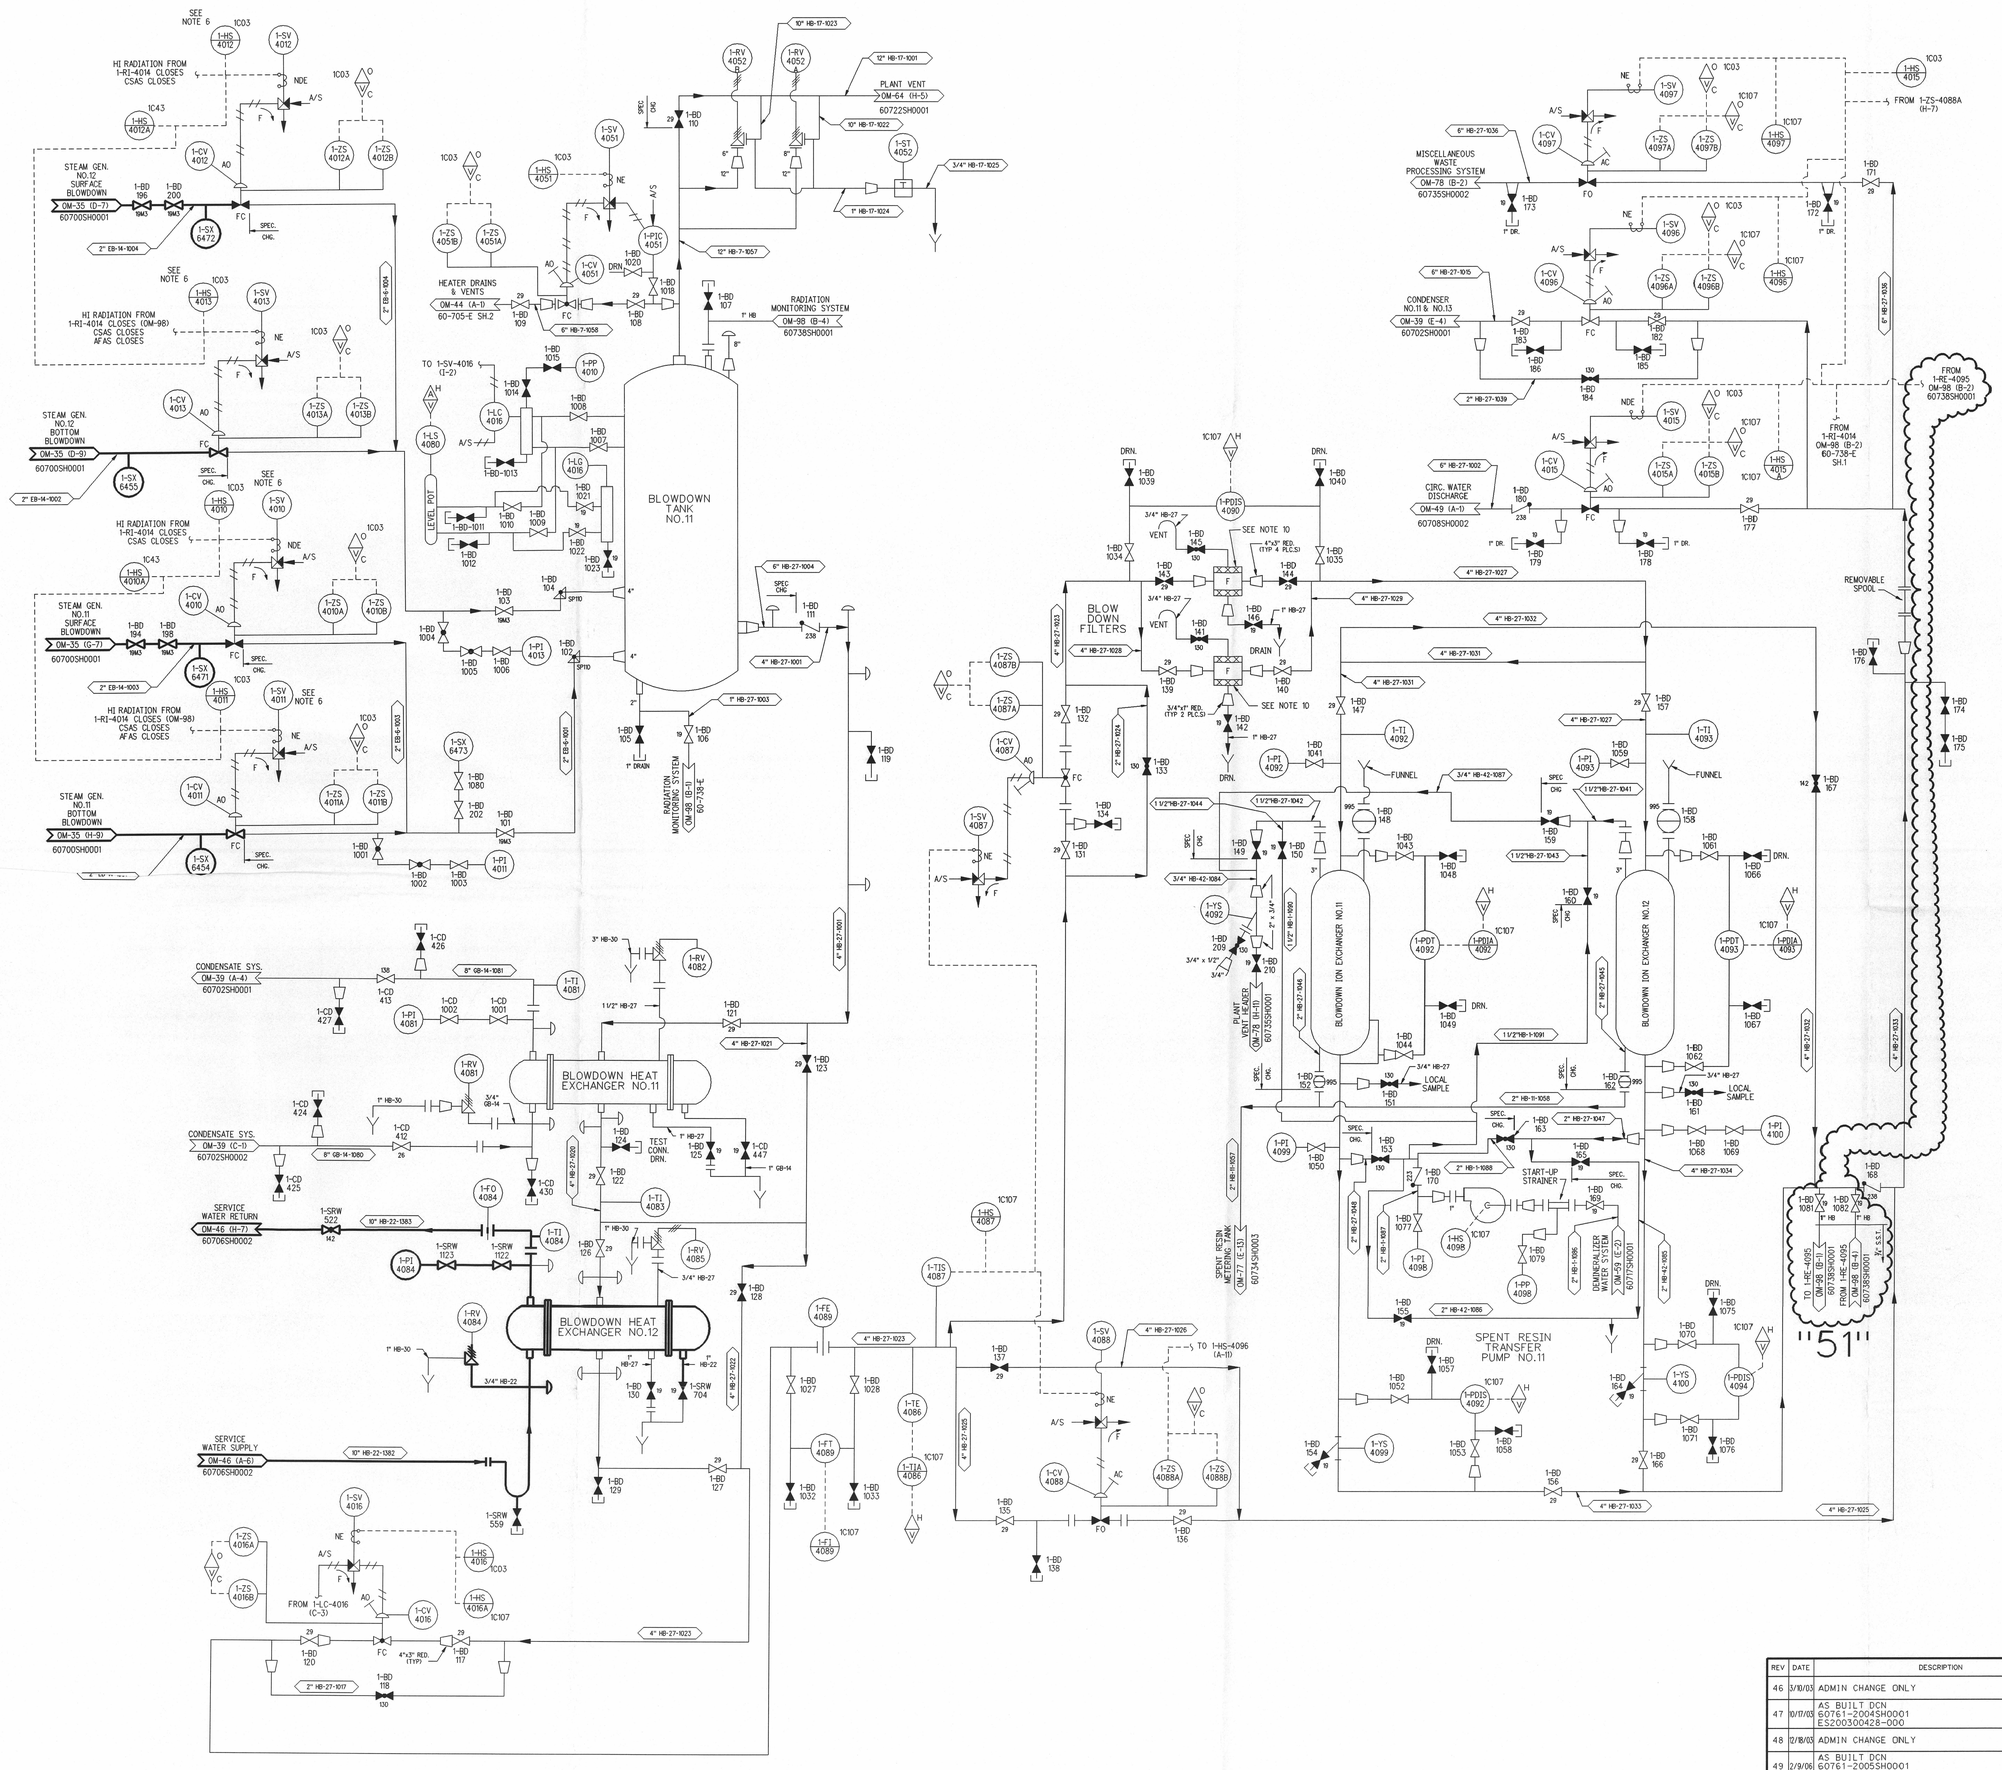

GENERAL NOTES

1. FOR P. & I.D. LEGEND SEE DRAWING 6750-M-80 (B.G. & E. NO.60-263-E).
2. FOR INSTRUMENT DATA SHEETS SEE 6750-M-500, (B.G. & E. NO.92-401-A THRU 92-422-B).
3. FOR EQUIPMENT LIST SEE 6750-M-603, (B.G. & E. NO.92-722-A).
4. EQUIPMENT NUMBERS FOR UNIT NO.1 ARE PREFIXED BY THE NUMBER 1 (EXAMPLE NO.11, 12, 13, ETC.).
   EQUIPMENT NUMBERS FOR UNIT NO.2 ARE PREFIXED BY THE NUMBER 2 (EXAMPLE NO.21, 22, 23, ETC.).
   EQUIPMENT COMMON TO BOTH UNITS IS NUMBERED AS FOR UNIT NO.1.
5. FOR DEFINITION OF LINE DESIGNATIONS SEE PIPING CLASS AND SUMMARY SHEETS 6750-M-600, 601.
6. "RAD TRIP OVERRIDE" POSITION ON HAND SWITCH PERMITS OPENING CV WITH HIGH RADIATION SIGNAL PRESENT FROM RE-4014.
7. THE Q-LIST INFORMATION PROVIDED ON THIS DRAWING IDENTIFIES THE SAFETY RELATED PRESSURE BOUNDARIES (SR-PB). EQUIPMENT WITHIN THE BOUNDARIES IS ALSO CLASSIFIED SR-PB, AS A MINIMUM. THE NUCLEIS MASTER EQUIPMENT LIST MUST BE USED FOR IDENTIFYING SPECIFIC OR ADDITIONAL SAFETY CLASSIFICATION INFORMATION, INCLUDING COMPONENT CLASSIFICATIONS AND ASSOCIATED REQUIREMENTS.
8. PIPING WHICH CONTINUES BEYOND THE SAFETY RELATED (SR-PB) BOUNDARY INDICATED ON THIS DRAWING, IS CLASSIFIED SR-PB UP TO AND INCLUDING THE FIRST SEISMIC ANCHOR.
9. ——— DENOTES SAFETY RELATED PRESSURE BOUNDARIES.
   ——— DENOTES NON-SAFETY RELATED PRESSURE BOUNDARIES.
10. INSTALLATION OF S/G BLOWDOWN ION EXCHANGER FILTERS IS OPTIONAL PER ES199501723

THIS DRAWING CREATED FROM OPERATIONS DRAWING 60-761-E (OM-464), REV. 33, DATED 03-17-1994 & P&ID 60-760-E (M-464), REV. 25, DATED 03-08-1993.

REV	DATE	DESCRIPTION	DWN	DSGN	DE	IR	APPROVED
46	3/10/03	ADMIN CHANGE ONLY	WHR RKL	—	—	—	RKL
47	10/17/03	AS BUILT DCN 60761-2004SH0001 ES200300428-000	WHR RKL	—	—	—	RKL
48	12/18/03	ADMIN CHANGE ONLY	WHR RKL	—	—	—	RKL
49	2/9/06	AS BUILT DCN 60761-2005SH0001 ES200400740-000	WHR RKL	—	—	—	RKL
50	9/25/06	ADMIN CHANGE ONLY	WB RKL	—	—	—	RKL
51	2/20/07	AS BUILT DCN 60761-2006SH0001 ES200500477-001	KWJ	—	—	—	KWJ

STEAM GENERATOR BLOWDOWN RECOVERY SYSTEM

CALVERT CLIFFS NUCLEAR POWER PLANT
ENGINEERING SERVICES DEPARTMENT

CALVERT CLIFFS UNIT 1 — SIZE E — CAT. C

SCALE: NONE — VENDOR DWG. NO. OM-464 — REV. 51

DWG. NO. 60761

D-46