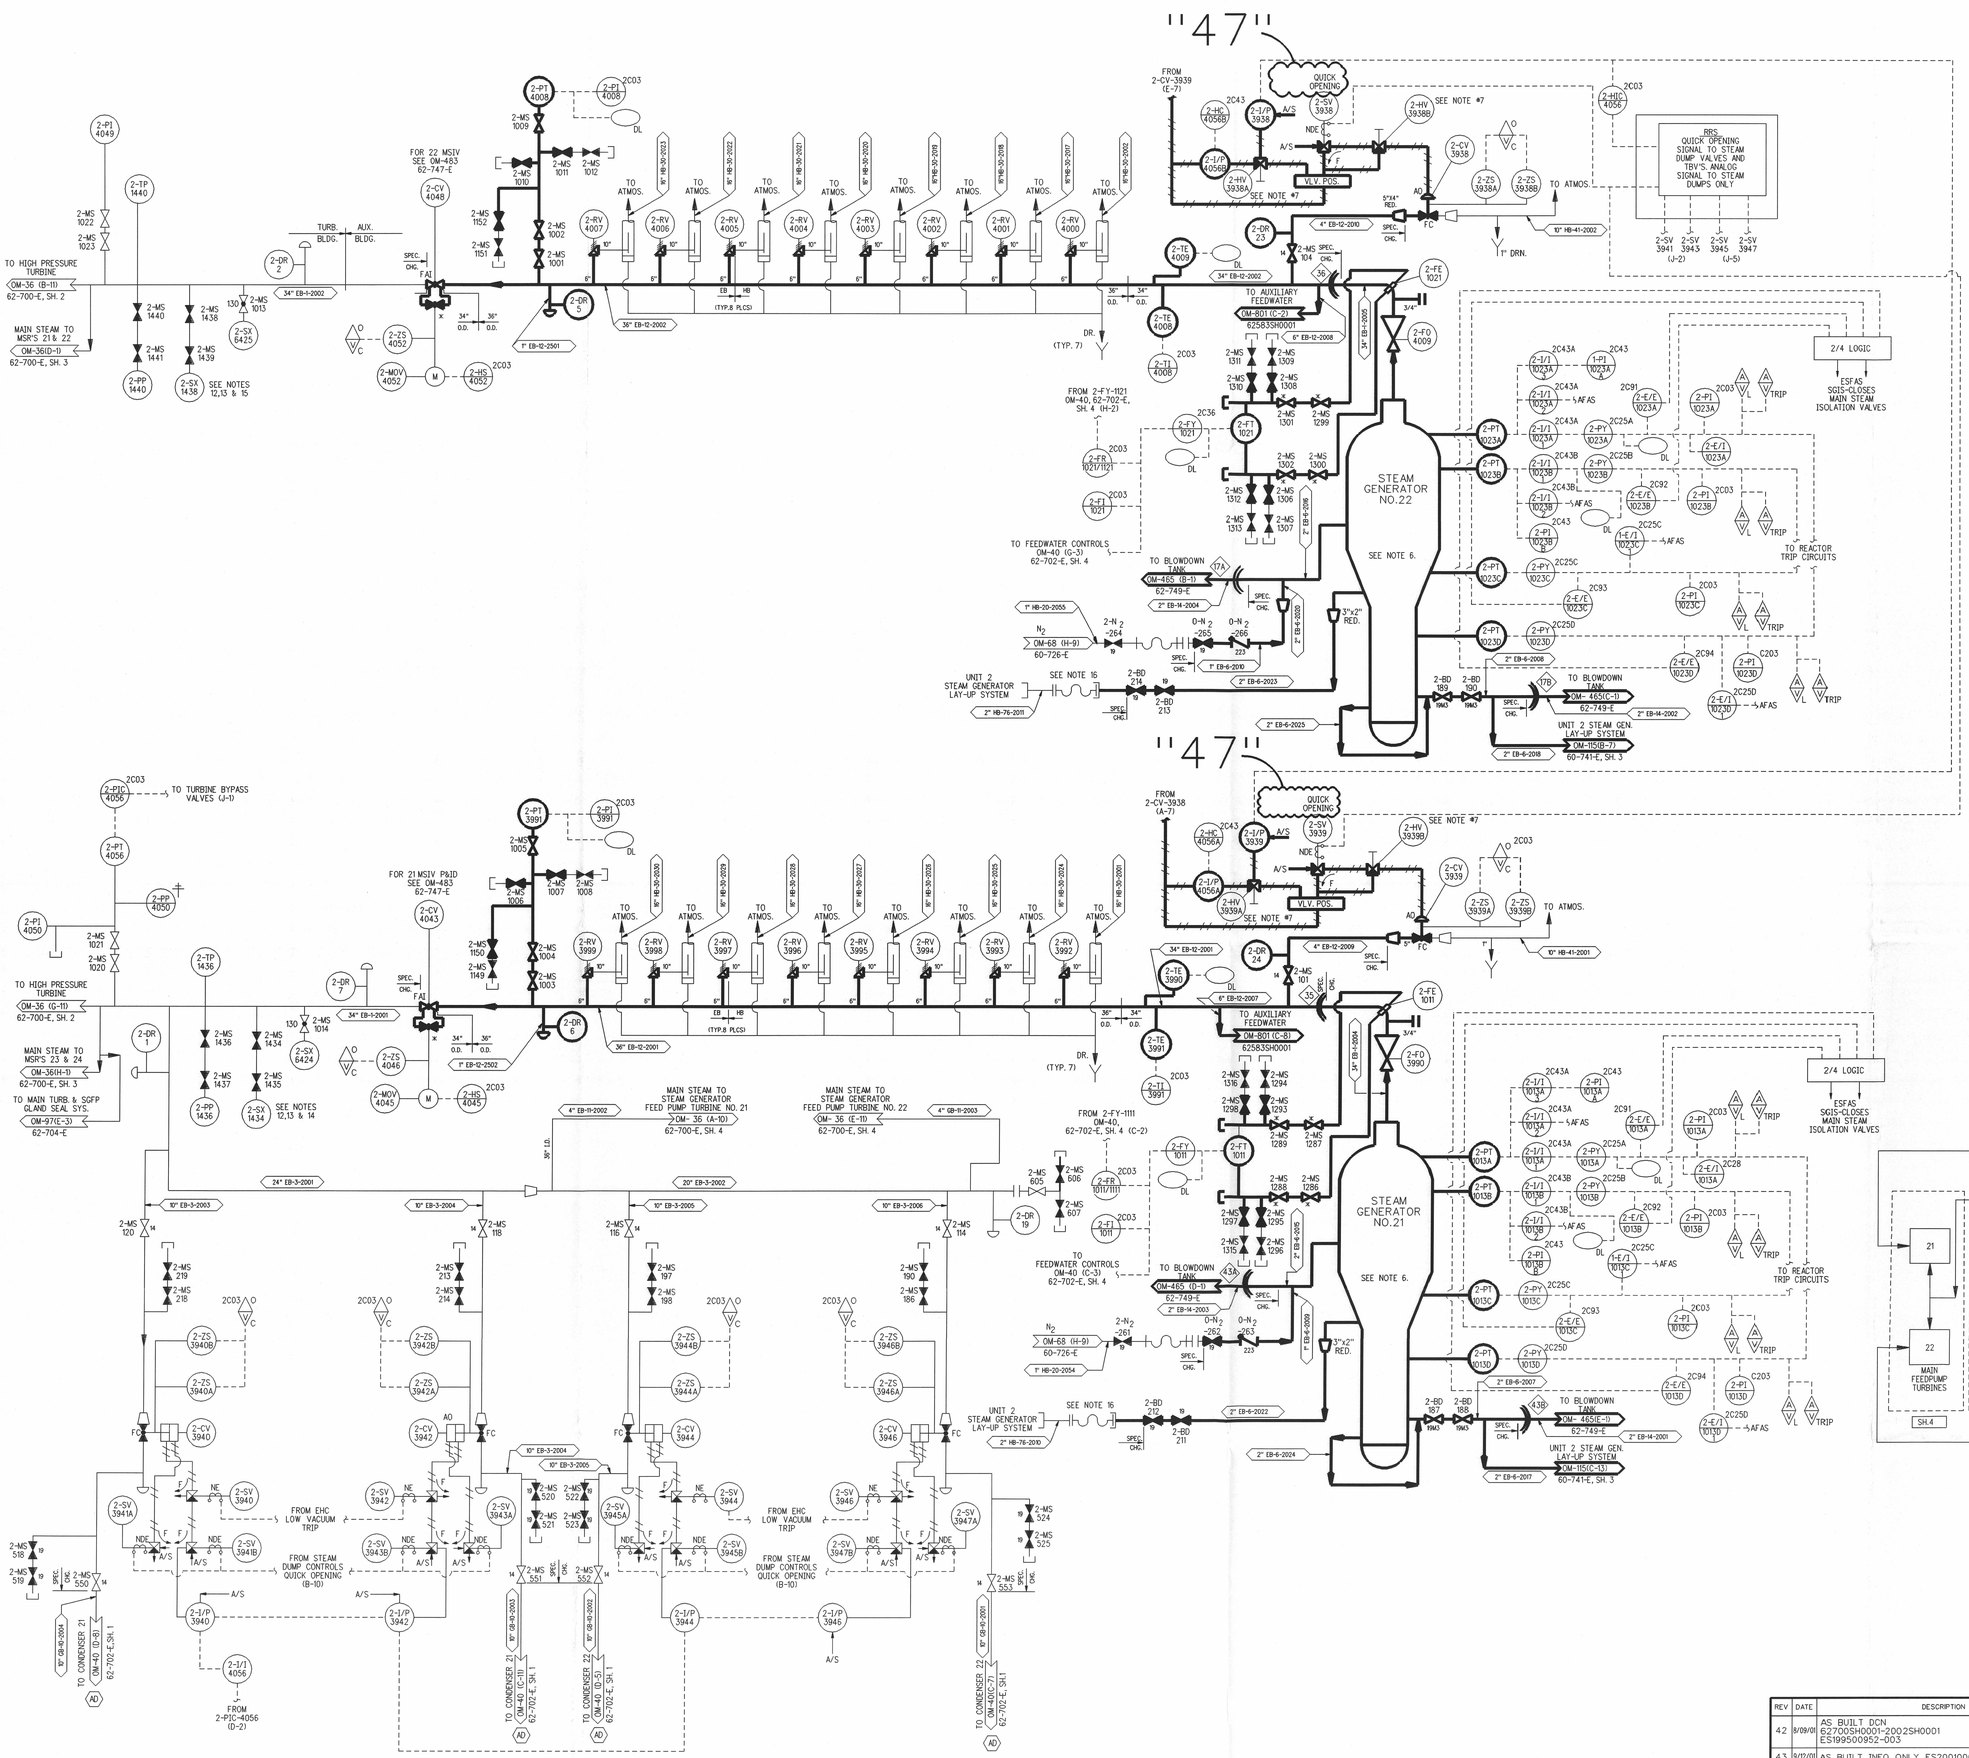

GENERAL NOTES:

1. FOR P&ID LEGEND SEE DRAWING 6750-M-80. (BG&E NO.60-263-E)
2. FOR EQUIPMENT LIST SEE 6750-M-603. (BG&E NO.92-772-A)
3. FOR INSTRUMENT DATA SHEETS SEE 6750-M-500. (BG&E NO.92-401-A THRU 92-422-B)
4. EQUIPMENT NUMBERS FOR UNIT NO.1 ARE PREFIXED BY THE NUMBER 1 (EXAMPLE: NO.11, 12, 13, ETC.). EQUIPMENT NUMBERS FOR UNIT NO.2 ARE PREFIXED BY THE NUMBER 2 (EXAMPLE: NO.21, 22, 23, ETC.). EQUIPMENT COMMON TO BOTH UNTS IS NUMBERERED AS FOR UNIT NO.1.
5. FOR DRAIN DATA SEE DRAWING 60740, OM-458.
6. REF. OM-040, 60702SH0004 FOR THE PIPING DETAIL OF THE S/G INSTRUMENTS.
7. TRANSFER HANDVALVES 2-HV-3938A & B AND 2-HV-3939A & B ARE LOCATED IN TAMPERPROOF ENCLOSURES WHICH ARE PROVIDED WITH A SECURITY ALARM TO PROVIDE AN ANNUNCIATION ALARM IN THE MAIN CONTROL ROOM.
8. FOR DEFINITION OF LINE DESIGNATIONS SEE PIPING CLASS AND SUMMARY SHTS. 6750-M-600, 6750-M-601.
9. THE Q-LIST INFORMATION PROVIDED ON THIS DRAWING IDENTIFIES THE SAFETY RELATED PRESSURE BOUNDARIES (SR-PB). EQUIPMENT WITHIN THE BOUNDARIES IS ALSO CLASSIFIED SR-PB, AS A MINIMUM. THE NUCLEIS MASTER EQUIPMENT LIST MUST BE USED FOR IDENTIFYING SPECIFIC OR ADDITIONAL SAFETY CLASSIFICATION INFORMATION, INCLUDING COMPONENT CLASSIFICATIONS AND ASSOCIATED REQUIREMENTS.
10. PIPING WHICH CONTINUES BEYOND THE SAFETY RELATED (SR-PB) BOUNDARY INDICATED ON THIS DRAWING, IS CLASSIFIED SR-PB UP TO AND INCLUDING THE FIRST SEISMIC ANCHOR.
11. ——— DENOTES SAFETY RELATED PRESSURE BOUNDARIES.
    ——— DENOTES NON-SAFETY RELATED PRESSURE BOUNDARIES.
12. STEAM SAMPLE PROBE MAY BE REMOVED AND A BLIND FLANGE INSTALLED
13. FOR DETAILS SEE DRAWING 13629A-25
14. INSULATION ON 34" LINE IS 7" THICK FROM 68" DOWNSTREAM OF 2-TP-1436 TO 68" UPSTREAM OF 2-SX-1434
15. INSULATION ON 34" LINE IS 7" THICK FROM 68" DOWNSTREAM OF 2-TP-1440 TO 68" UPSTREAM OF 2-SX-1438
16. FLEX HOSE REMOVED DURING NORMAL OPERATIONS.

DRAWING LEGEND

* HERMETICALLY SEALED VALVE REDUCED STEM TRAVEL

THIS DRAWING CREATED FROM OPERATIONS DRAWING 62700SH0001 (OM-36), REV. 34, DATED 08-03-1993 & P&ID 62225SH0001 (M-36), REV. 39, DATED 07-21-1993.

REV	DATE	DESCRIPTION	DWN	DSGN	DE	IR	APPROVED
42	8/09/01	AS BUILT DCN 62700SH0001-2002SH0001 ES199500952-003	JCH	–	–	–	JM
43	9/12/01	AS BUILT INFO ONLY ES200100604-000	JCH	–	–	–	JM
44	1/30/03	ADMIN CHANGE ONLY	–	–	–	–	–
45	4/01/04	AS BUILT DCN'S 62700SH0001-2003SH0001 REV. A ES199601526-211 & 62700SH0001-2004SH0001, REV.A ES199601526-210	RSS	–	–	–	JBW
46	2/22/06	EDITORIAL CHANGE ONLY	WHR [illegible]	–	–	–	[illegible]
47	1/17/06	AS BUILT DCN 62700SH0001-2006SH0001 ES200500648-000	WHR [illegible]	–	–	–	[illegible]

MAIN STEAM AND REHEAT

CALVERT CLIFFS NUCLEAR POWER PLANT
ENGINEERING SERVICES DEPARTMENT
CALVERT CLIFFS UNIT 2 | SIZE E | CAT. C

SCALE: NONE | VENDOR DWG. NO. OM-036SH0001 | REV.
DWG. NO. 62700SH0001 | 47