STOP, THINK, ACT AND REVIEW

GENERAL NOTES

1. FOR P&ID LEGEND SEE DRAWING 6750-M-80 (B.G. & E. NO.60-263-E)
2. FOR DEFINITIONS OF LINE DESIGNATIONS SEE PIPING CLASS AND SUMMARY SHEETS 6750-M-601
3. FOR EQUIPMENT LIST SEE 6750-M-630 (B.G. & E. NO.92-772-A)
4. FOR INSTRUMENT DATA SHEETS SEE 6750-M-500 (B.G. & E. NO.92-401-A TO 92-422-B).
5. EQUIPMENT NUMBERS FOR UNIT NO.1 ARE PREFIXED BY THE NUMBER 1. (EXAMPLE NO.11,12,13, ETC...) EQUIPMENT NUMBERS FOR UNIT NO.2 ARE PREFIXED BY THE NUMBER 2. (EXAMPLE NO.21,22,23, ETC...) EQUIPMENT COMMON TO BOTH UNITS IS NUMBERED AS FOR UNIT NO.1.
6. THE Q-LIST INFORMATION PROVIDED ON THIS DRAWING IDENTIFIES THE SAFETY RELATED PRESSURE BOUNDARIES (SR-PB). EQUIPMENT WITHIN THE BOUNDARIES IS ALSO CLASSIFIED SR-PB, AS A MINIMUM. THE NUCLEIS MASTER EQUIPMENT LIST MUST BE USED FOR IDENTIFYING SPECIFIC OR ADDITIONAL SAFETY CLASSIFICATION INFORMATION, INCLUDING COMPONENT CLASSIFICATIONS AND ASSOCIATED REQUIREMENTS.
7. PIPING WHICH CONTINUES BEYOND THE SAFETY RELATED (SR-PB) BOUNDARY INDICATED ON THIS DRAWING, IS CLASSIFIED SR-PB UP TO AND INCLUDING THE FIRST SEISMIC ANCHOR.
8. ——— DENOTES SAFETY RELATED PRESSURE BOUNDARIES.
   ——— DENOTES NON-SAFETY RELATED PRESSURE BOUNDARIES.

VOLUME CONTROL TANK NO.21

MAKE UP CONTROL

BORIC ACID BATCHING TANK NO.21

RC MAKE-UP PUMPS

CONC. BORIC ACID STORAGE TANK NO.21

CONC. BORIC ACID STORAGE TANK NO.22

BORIC ACID PUMP NO.21

BORIC ACID PUMP NO.22

CHEMICAL ADDITION TANK NO.21

METERED CHEMICAL INJECTION SKID

"79"

DRAWING LEGEND

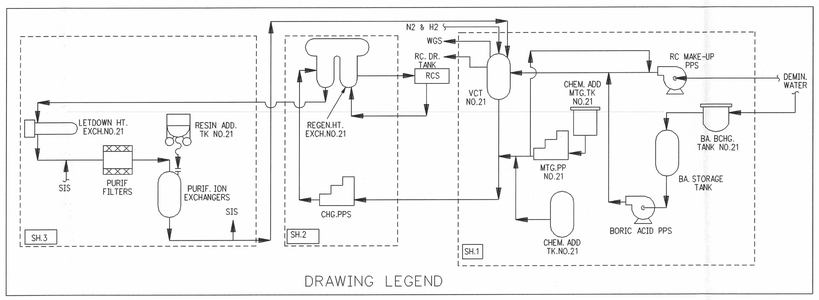

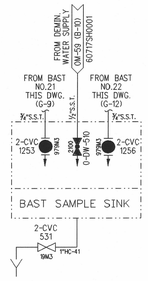

THIS DRAWING CREATED FROM OPERATIONS DRAWING 62-730-E SH.1 (OM-461), REV. 47, DATED 04-08-1994 & P&ID 62-256-E SH.1 (M-461), REV.50, DATED 04-08-1994.

REV	DATE	DESCRIPTION	DWN	DSGN	DE	IR	APPROVED
74	3/9/05	AS BUILT DCN 62730SH0001-2016SH0002 62730SH0001-2016SH0004 ES200300306-001	WHR RKL	—	—	—	RKL
75	5/9/06	EDITORIAL CHANGE ONLY	WHR RKL	—	—	—	RKL
76	8/25/06	AS BUILT DCN 62730SH0001-2018SH0001 ES200500369-000	WB RKL	—	—	—	RKL
77	2/1/07	AS BUILT DCN 62730SH0001-2019SH0002 REV.A ES200200753-000	WB KWJ	—	—	—	KWJ
78	3/25/07	AS BUILT DCN 62730SH0001-2020SH0001 ES200600274-000	WB CPM	—	—	—	CPM
79	6/5/07	AS BUILT DCN 62730SH0001-2019SH0001 REV.C ES200200753-000	KWJ KWJ	—	—	—	KWJ

CHEMICAL AND VOLUME CONTROL SYSTEM

CALVERT CLIFFS NUCLEAR POWER PLANT
ENGINEERING SERVICES DEPARTMENT

CALVERT CLIFFS UNIT 2 | SIZE E | CAT. C

SCALE: NONE | VENDOR DWG. NO. OM-461SH0001 | REV.

DWG. NO. 62730SH0001 | 79

D-15