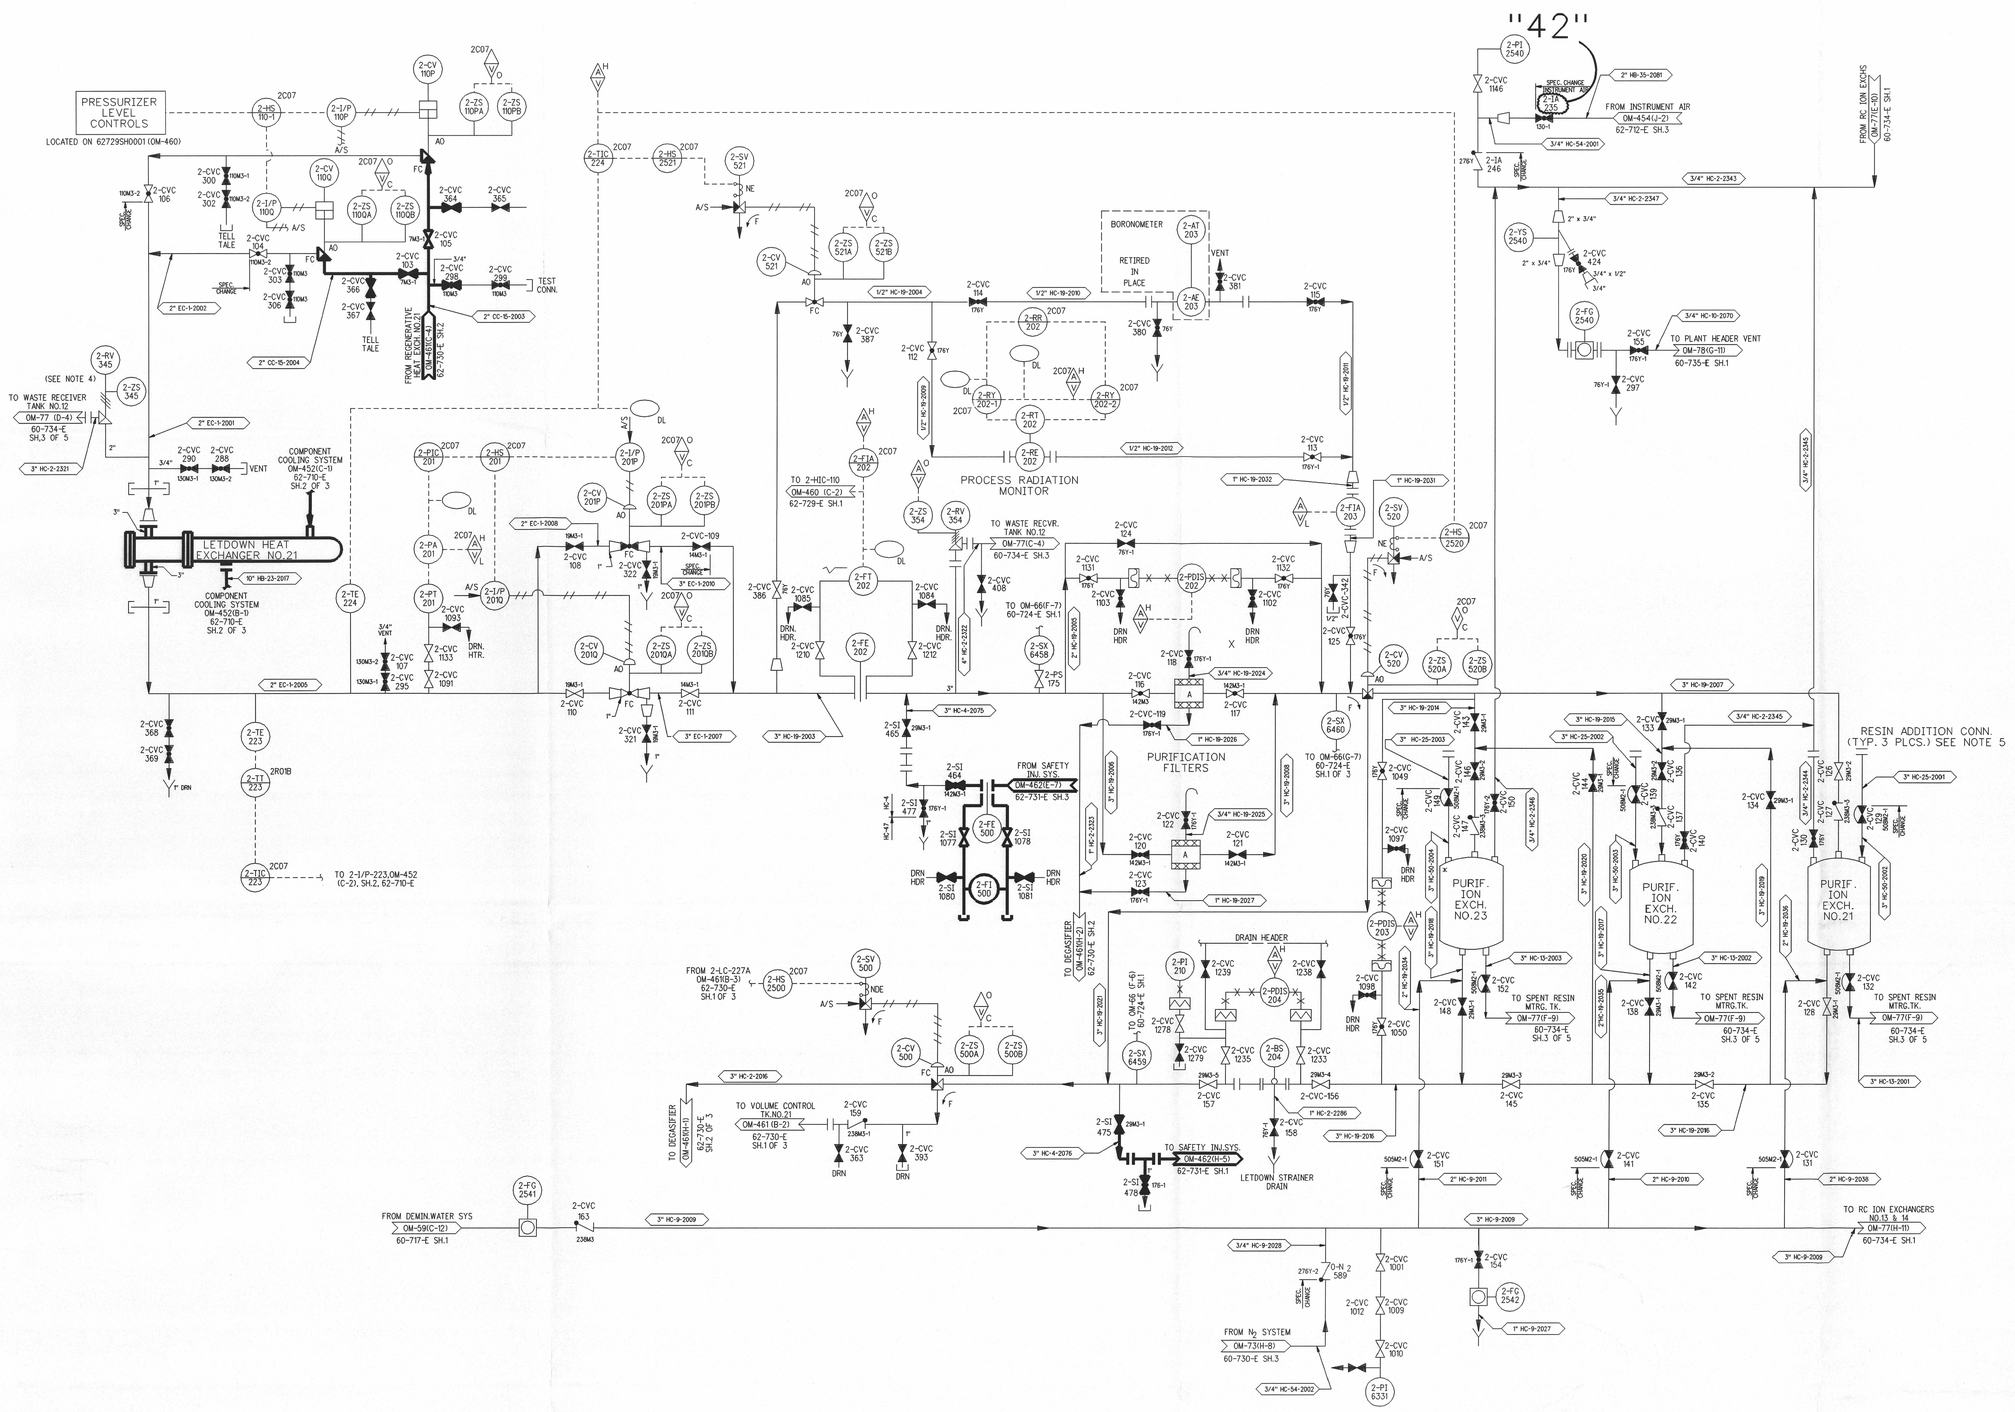

* FORMERLY TITLED DEBORONATING ION EXCHANGER

GENERAL NOTES

REF. SHT.1

DRAWING NOTES

1. THE Q-LIST INFORMATION PROVIDED ON THIS DRAWING IDENTIFIES THE SAFETY RELATED PRESSURE BOUNDARIES (SR-PB). EQUIPMENT WITHIN THE BOUNDARIES IS ALSO CLASSIFIED SR-PB, AS A MINIMUM. THE NUCLEIS MASTER EQUIPMENT LIST MUST BE USED FOR IDENTIFYING SPECIFIC OR ADDITIONAL SAFETY CLASSIFICATION INFORMATION, INCLUDING COMPONENT CLASSIFICATIONS AND ASSOCIATED REQUIREMENTS.
2. PIPING WHICH CONTINUES BEYOND THE SAFETY RELATED (SR-PB) BOUNDARY INDICATED ON THIS DRAWING, IS CLASSIFIED SR-PB UP TO AND INCLUDING THE FIRST SEISMIC ANCHOR.
3. ——— DENOTES SAFETY RELATED PRESSURE BOUNDARIES.
   ——— DENOTES NON-SAFETY RELATED PRESSURE BOUNDARIES.
4. FLANGES MAY BE ADDED TO THE INLET OF 2-RV-345
5. FRESH RESIN IS TRANSFERRED VIA FLEXIBLE CONNECTION FROM A MOVABLE RESIN ADDITION TANK (OTKRESINADD) THAT SERVICES BOTH UNITS. THE RESIN ADD. TANK IS CONNECTED TO THE DEMIN. WATER SYSTEM BY 1 OF 4 HOSE CONNECTIONS ON DWG. 60717SH0001 (C-010).

THIS DRAWING CREATED FROM OPERATIONS DRAWING 62-730-E SH.3 (OM-461), REV.23, DATED 06-02-1993 & P&ID 62-256-E SH.3 (M-461), REV.13, DATED 06-03-1993.

REV	DATE	DESCRIPTION	DWN	DSGN	DE	IR	APPROVED
36		AS BUILT DCN 62730SH0003-2003SH0001 ES199900749-000					
37		AS BUILT INFO. ONLY ES199602205-000					
38	9/14/00	AS BUILT INFO. ONLY ES200000628-000	JCH	—	—	—	JW
39	7/23/01	AS BUILT DCN 62730SH0003-2004SH0001 ES199900807-000	JCH	—	—	—	RKL
40	3/18/03	AS BUILT DCN 62730SH0003-2006SH0001 ES200200135-000	WHR DHE	—	—	—	KWJ
41	10/28/03	AS BUILT DCN 62730SH0003-2007SH0001 ES200101008-000	WHR RKL	—	—	—	RKL
42	11/30/05	AS BUILT DCN 62730SH0003-2008SH0001 ES200100485-000	WHR RKL	—	—	—	RKL

CHEMICAL AND VOLUME CONTROL SYSTEM

CALVERT CLIFFS NUCLEAR POWER PLANT
ENGINEERING SERVICES DEPARTMENT

CALVERT CLIFFS UNIT 2 | SIZE E | CAT. C

SCALE: NONE | VENDOR DWG. NO. OM-461SH0003 | REV. 42

DWG. NO. 62730SH0003

D-12