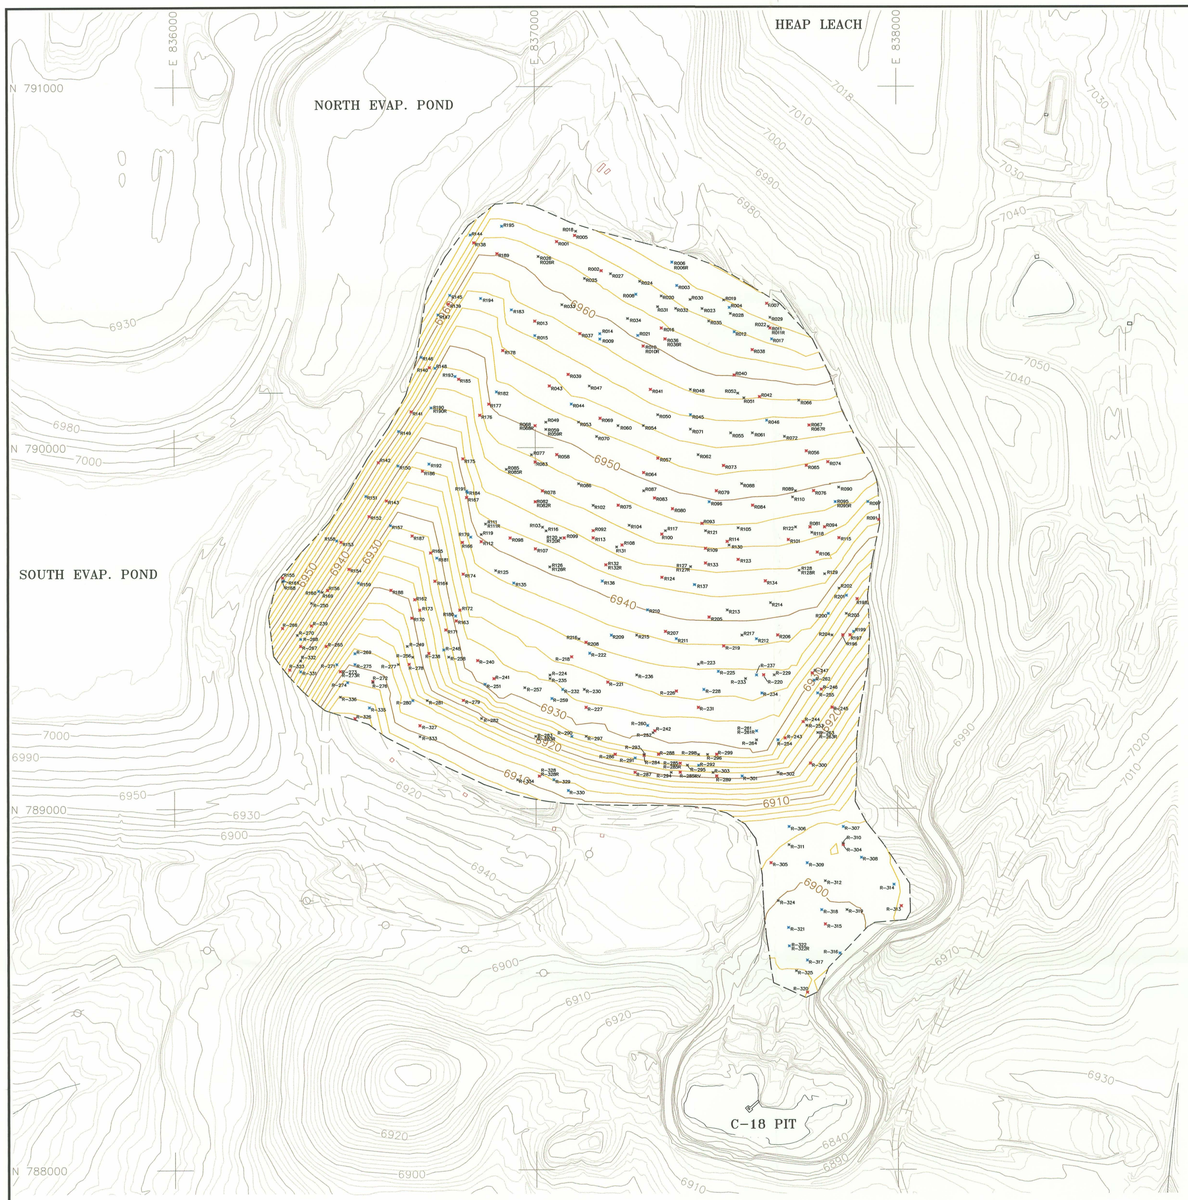


**LEGEND:**

- 7000 — EXISTING 1997 AERIAL TOPOGRAPHY
- DRAINAGE PATH/PONDED WATER
- UN-PAVED ROADS
- N 794,000 — UMETCO 1000' SITE GRID
- 6960 — FINISH GRADE TOPOGRAPHY RADON BARRIER FILL AREA
- LIMIT OF RADON BARRIER SOILS
- R150 — RADON BARRIER FILL COMPACTION TEST LOCATION – FIRST LIFT
- R150 — RADON BARRIER FILL COMPACTION TEST LOCATION – SECOND LIFT
- R150 — RADON BARRIER FILL COMPACTION TEST LOCATION – THIRD LIFT

N

200' 0 200'

SCALE IN FEET

CONTOUR INTERVAL : 2'

Umetco Minerals Corporation
2754 COMPASS DRIVE, SUITE 280, GRAND JUNCTION, CO 81506

AS BUILT

A-9 REPOSITORY
COMPACTION TEST LOCATIONS
RADON BARRIER

GAS HILLS, WYOMING

DATE: JUNE 2007 DWG: GH-A9-06-AB SHEET 6 OF 12

D-04