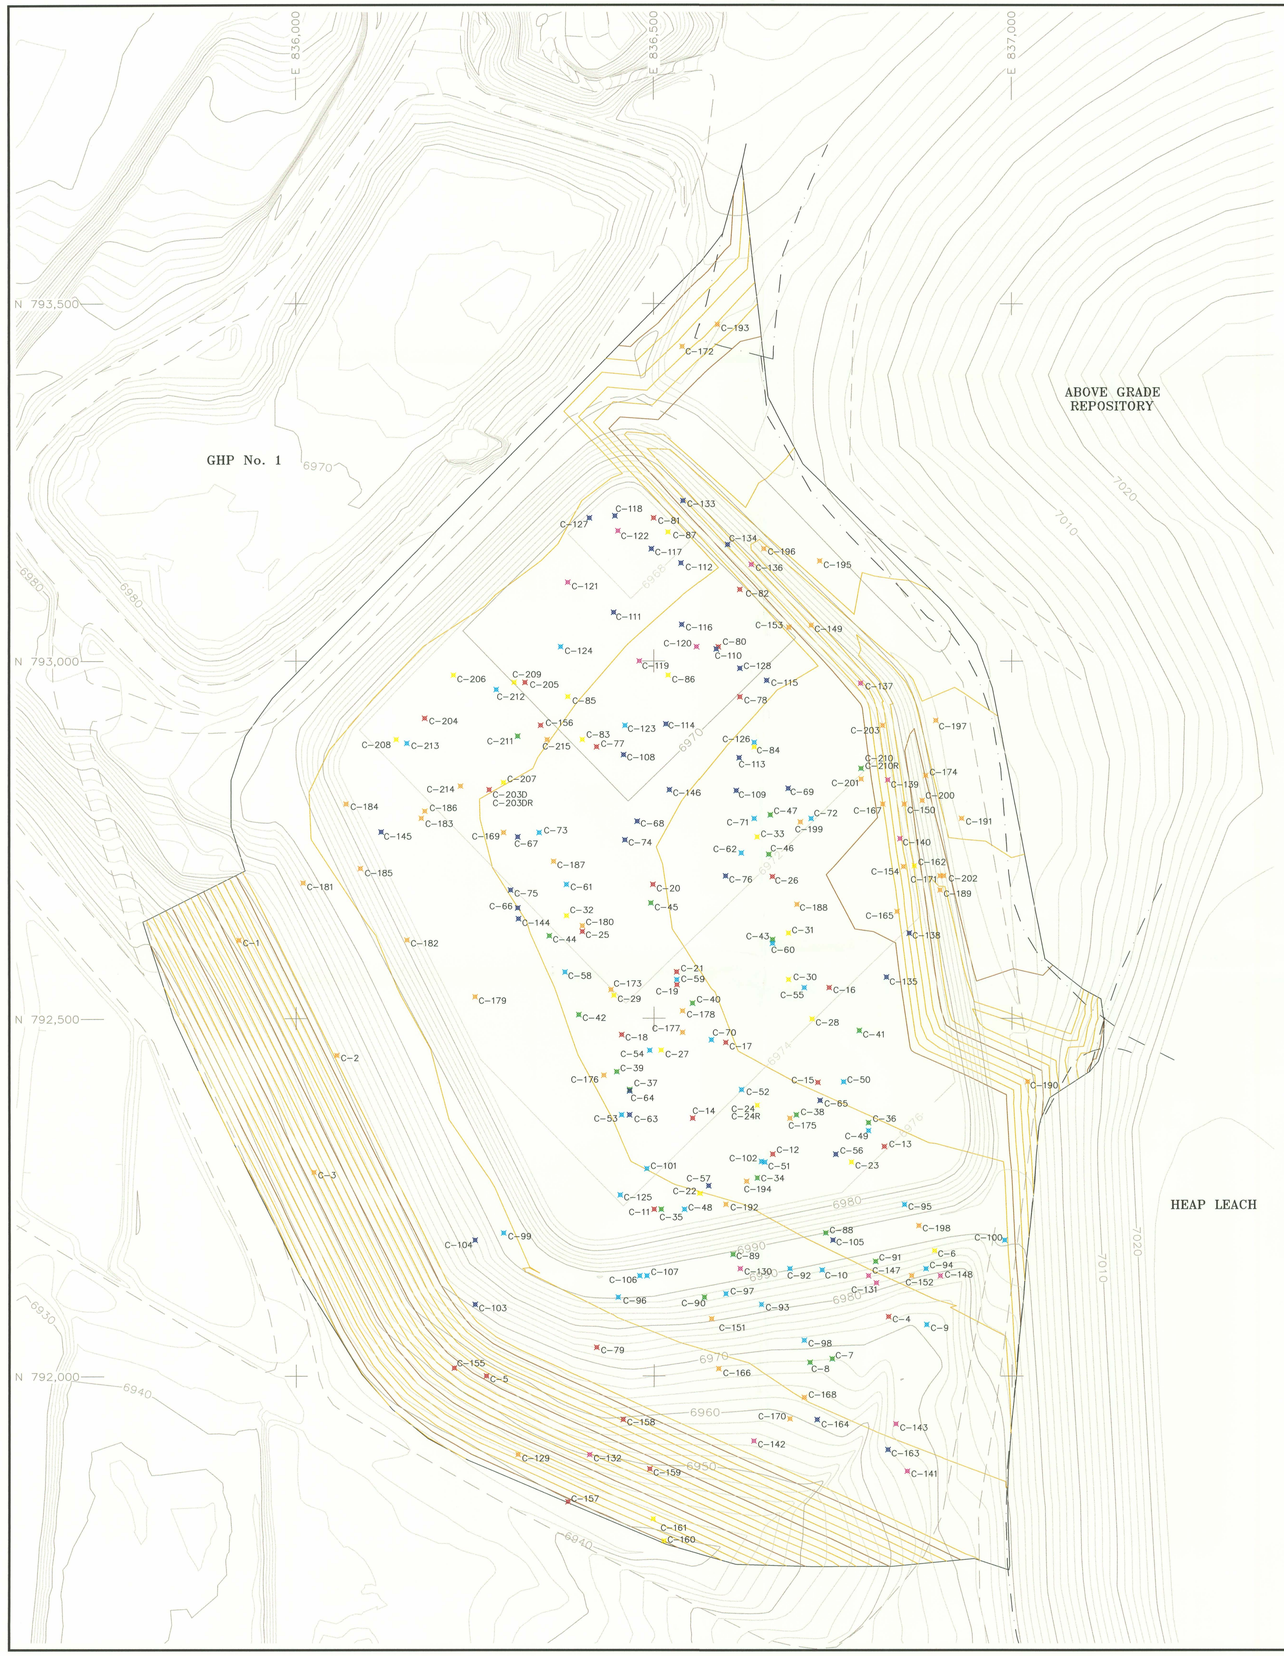

N

100' 0 100'

SCALE IN FEET

CONTOUR INTERVAL : 2'

LEGEND:

7000	2000 AERIAL TOPOGRAPHY UPDATED WITH 2002 SURVEYS
	DRAINAGE PATH/PONDED WATER
	UN-PAVED ROADS
N 794,000	UMETCO 1000' SITE GRID
6960	FINISH GRADE TOPOGRAPHY GHP-2 CONTAMINATED FILL AREA
C-11	CONTAMINATED FILL COMPACTION TEST LOCATION – FIRST LIFT
C-31	CONTAMINATED FILL COMPACTION TEST LOCATION – SECOND LIFT
C-45	CONTAMINATED FILL COMPACTION TEST LOCATION – THIRD LIFT
C-71	CONTAMINATED FILL COMPACTION TEST LOCATION – FOURTH LIFT
C-112	CONTAMINATED FILL COMPACTION TEST LOCATION – FIFTH LIFT
C-140	CONTAMINATED FILL COMPACTION TEST LOCATION – SIXTH LIFT
C-184	CONTAMINATED FILL COMPACTION TEST LOCATION – FINISHED GRADE

Umetco Minerals Corporation
2754 COMPASS DRIVE, SUITE 280, GRAND JUNCTION, CO 81506

AS BUILT

GHP-2 REPOSITORY
COMPACTION TEST LOCATIONS
CONTAMINATED FILL AREA

GAS HILLS, WYOMING

DATE: JUNE 2007 DWG: GH-GHP2-03-AB SHEET 3 OF 13

D-03