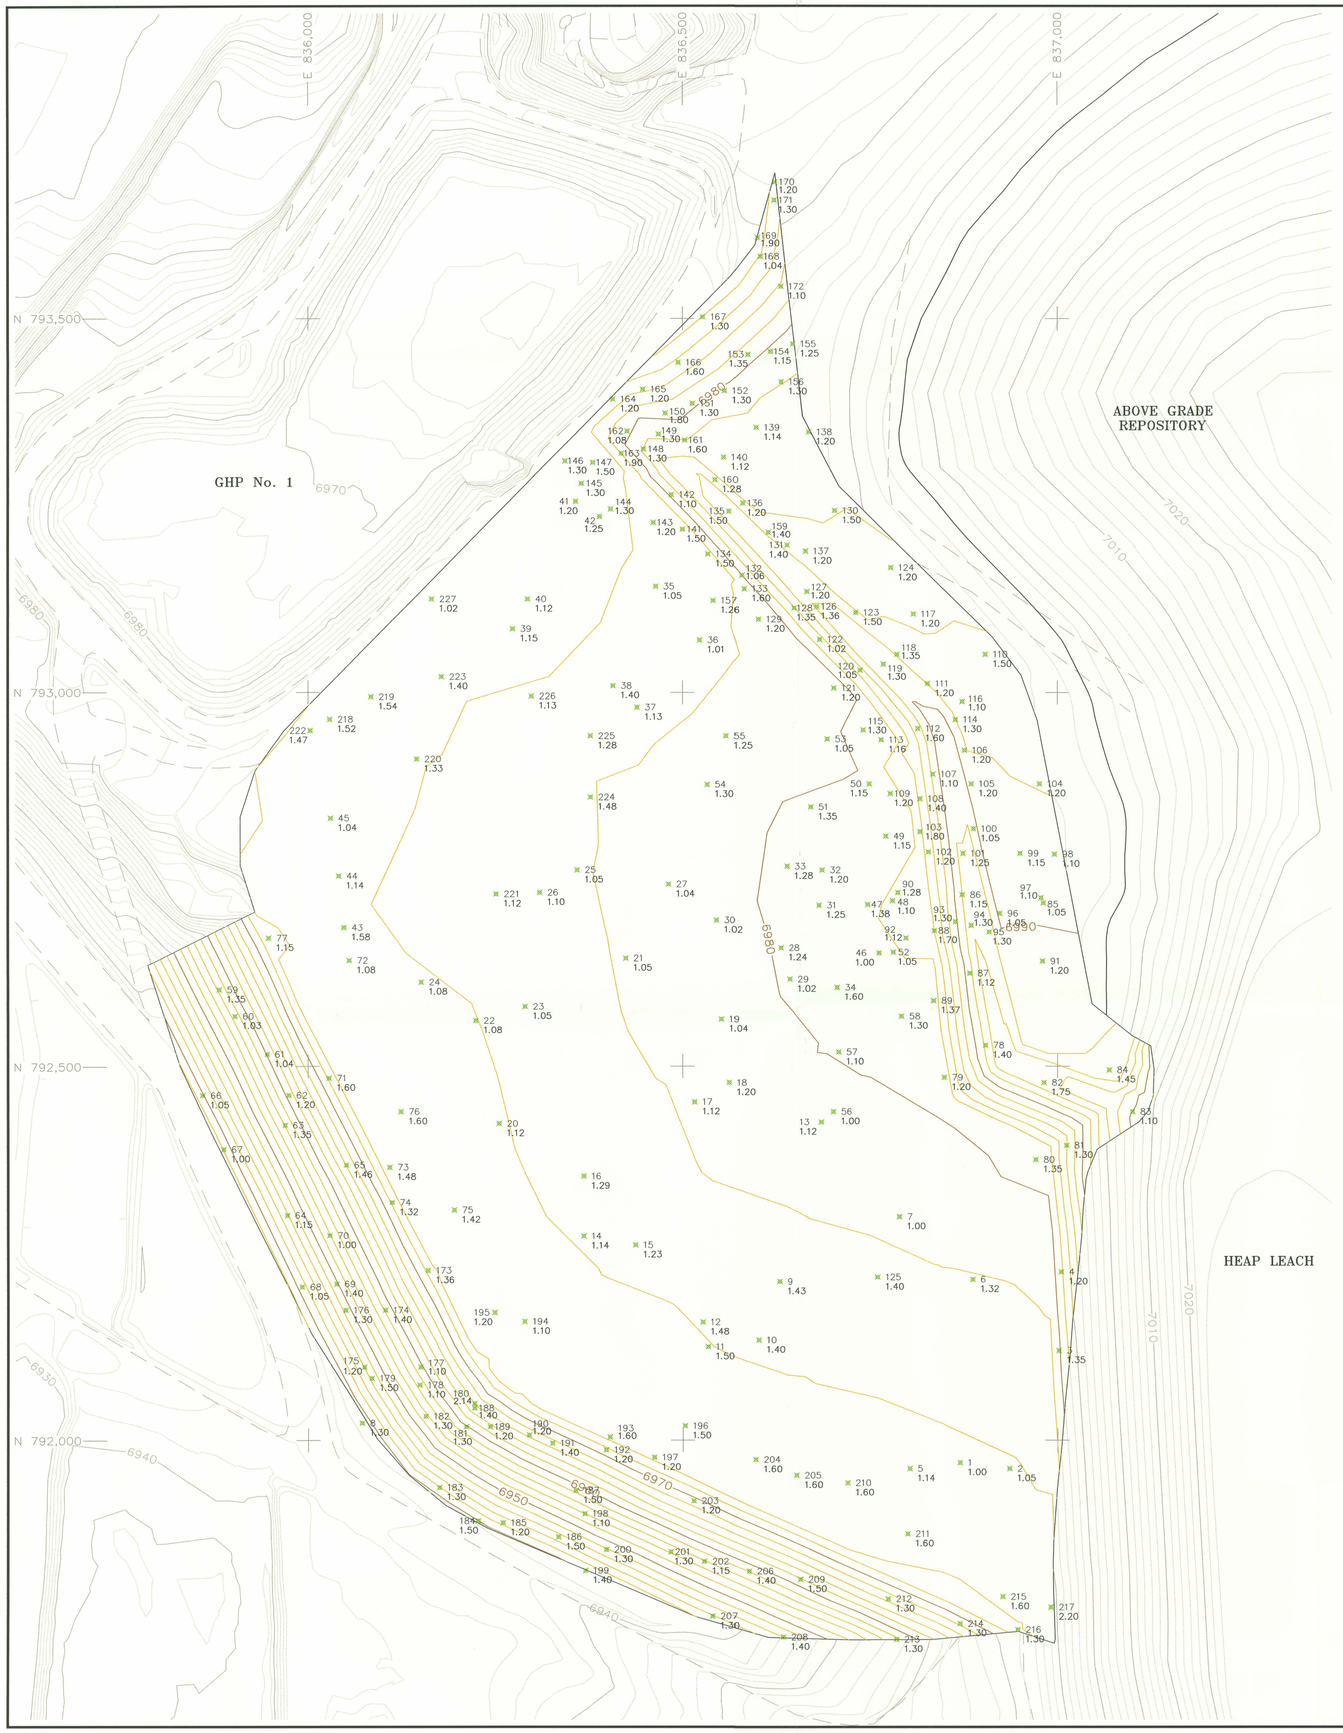

N

100' 0 100'

SCALE IN FEET
CONTOUR INTERVAL : 2'

LEGEND:

7000	2000 AERIAL TOPOGRAPHY UPDATED WITH 2002 SURVEYS
	DRAINAGE PATH/PONDED WATER
	UN-PAVED ROADS
N 794,000	UMETCO 1000' SITE GRID
	EXISTING RADON BARRIER LIMITS FOR THE ABOVE-GRADE AND HEAP LEACH REPOSITORIES
6960	FINISH GRADE TOPOGRAPHY RADON BARRIER FILL AREA
49 1.15	RADON BARRIER FILL VISUAL DEPTH CHECK 49 = TEST LOCATION NUMBER 1.15 = MEASURED THICKNESS

Umetco Minerals Corporation
2754 COMPASS DRIVE, SUITE 280, GRAND JUNCTION, CO 81506

AS BUILT

GHP-2 REPOSITORY
VISUAL DEPTH CHECK LOCATIONS
RADON BARRIER FILL

GAS HILLS, WYOMING

DATE: JUNE 2007 DWG: GH-GHP2-06-AB SHEET 6 OF 13

D-06