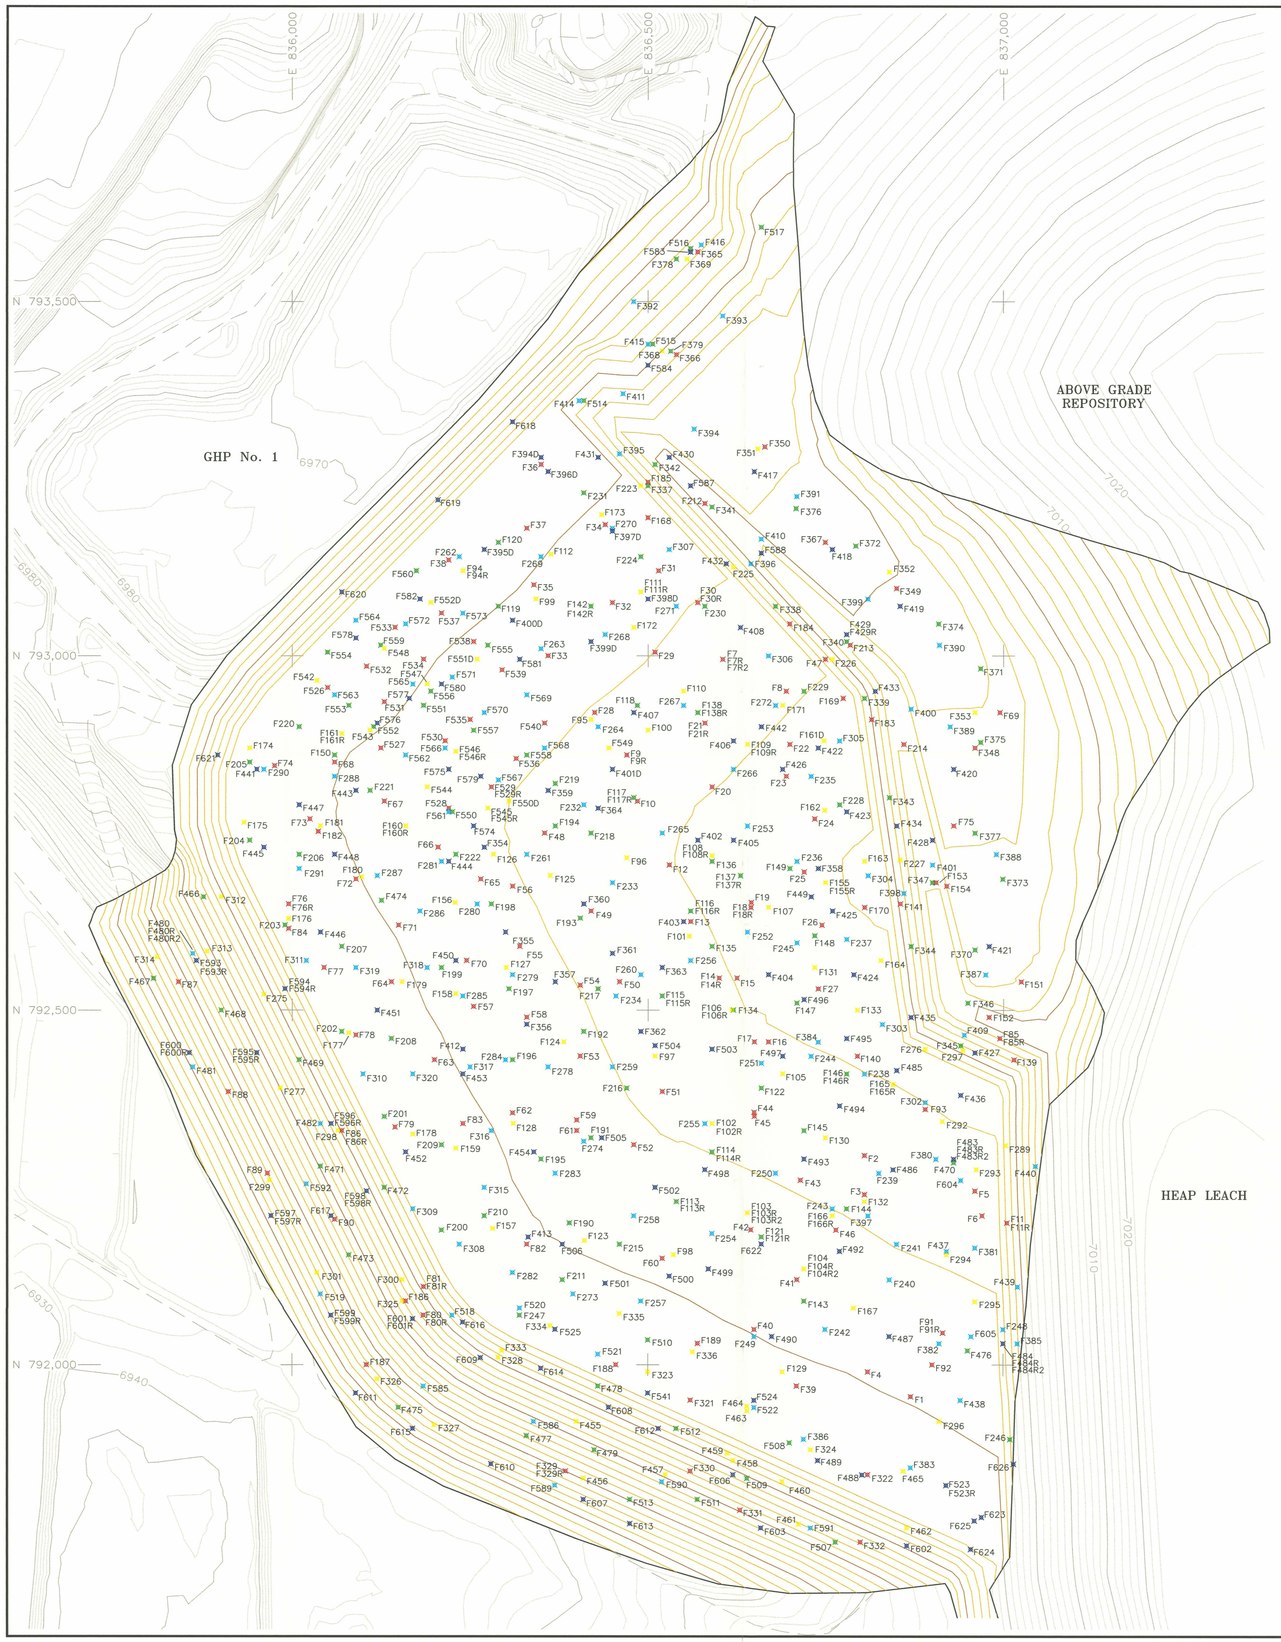

N

100' 0 100'

SCALE IN FEET

CONTOUR INTERVAL : 2'

LEGEND:

7000	2000 AERIAL TOPOGRAPHY UPDATED WITH 2002 SURVEYS
	DRAINAGE PATH/PONDED WATER
	UN–PAVED ROADS
N 794,000	UMETCO 1000' SITE GRID
6960	FINISH GRADE TOPOGRAPHY FROST PROTECTION FILL AND TOE APRON SUBGRADE
F–761	FROST PROTECTION FILL COMPACTION TEST LOCATION – FIRST LIFT
F–772	FROST PROTECTION FILL COMPACTION TEST LOCATION – SECOND LIFT
F–784	FROST PROTECTION FILL COMPACTION TEST LOCATION – THIRD LIFT
F–835	FROST PROTECTION FILL COMPACTION TEST LOCATION – FOURTH LIFT
F–973	FROST PROTECTION FILL COMPACTION TEST LOCATION – FIFTH LIFT

Umetco Minerals Corporation
2754 COMPASS DRIVE, SUITE 280, GRAND JUNCTION, CO 81506

AS BUILT

GHP–2 REPOSITORY
COMPACTION TEST LOCATIONS
FROST PROTECTION FILL AREA

GAS HILLS, WYOMING

DATE: JUNE 2007 DWG: GH–GFHP2–09–AB SHEET 9 OF 13

D-09