5935-C18-55-3

DISTRIBUTION

	COPY	DATE
VENDOR	1	7-22-68
CLIENT	142	
FIELD	1	
CIVIL		
ELECT		
MECH		
LAYOUT		
INSTR		
START-UP		
RECORD	1	

BECHTEL CORP
SAN FRANCISCO

RECEIVED
BECHTEL CORP.
AUG - 7 1968
POWER DIVN
S. F.

1 1-WELDELL 6" SCH40 180° LR ALUM 6061-T6 11#
2 1-PIPE 6" SCH40 X 0'-6 1/2 5454 3#

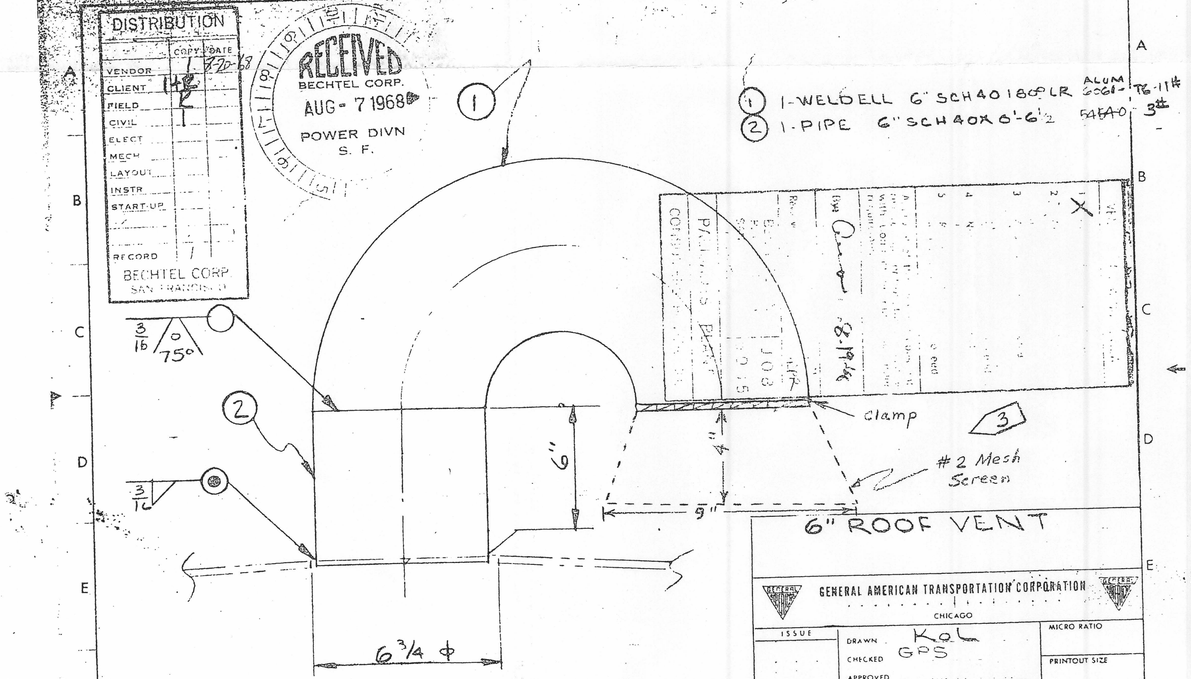

6" ROOF VENT

GENERAL AMERICAN TRANSPORTATION CORPORATION
CHICAGO

ISSUE	DRAWN KOL	MICRO RATIO
	CHECKED GPS	PRINTOUT SIZE
	APPROVED CHIEF ENGR	
	REF DRWGS	
DATE 6-4-68	DWG NO 11D-190	
SCALE		

EP Co	3	3-11-76	As Built	L	ERL	OS App LRH

5935-C18-G50X13-Sh 55

D-02