SCALING RULES

SIZE E

C-50

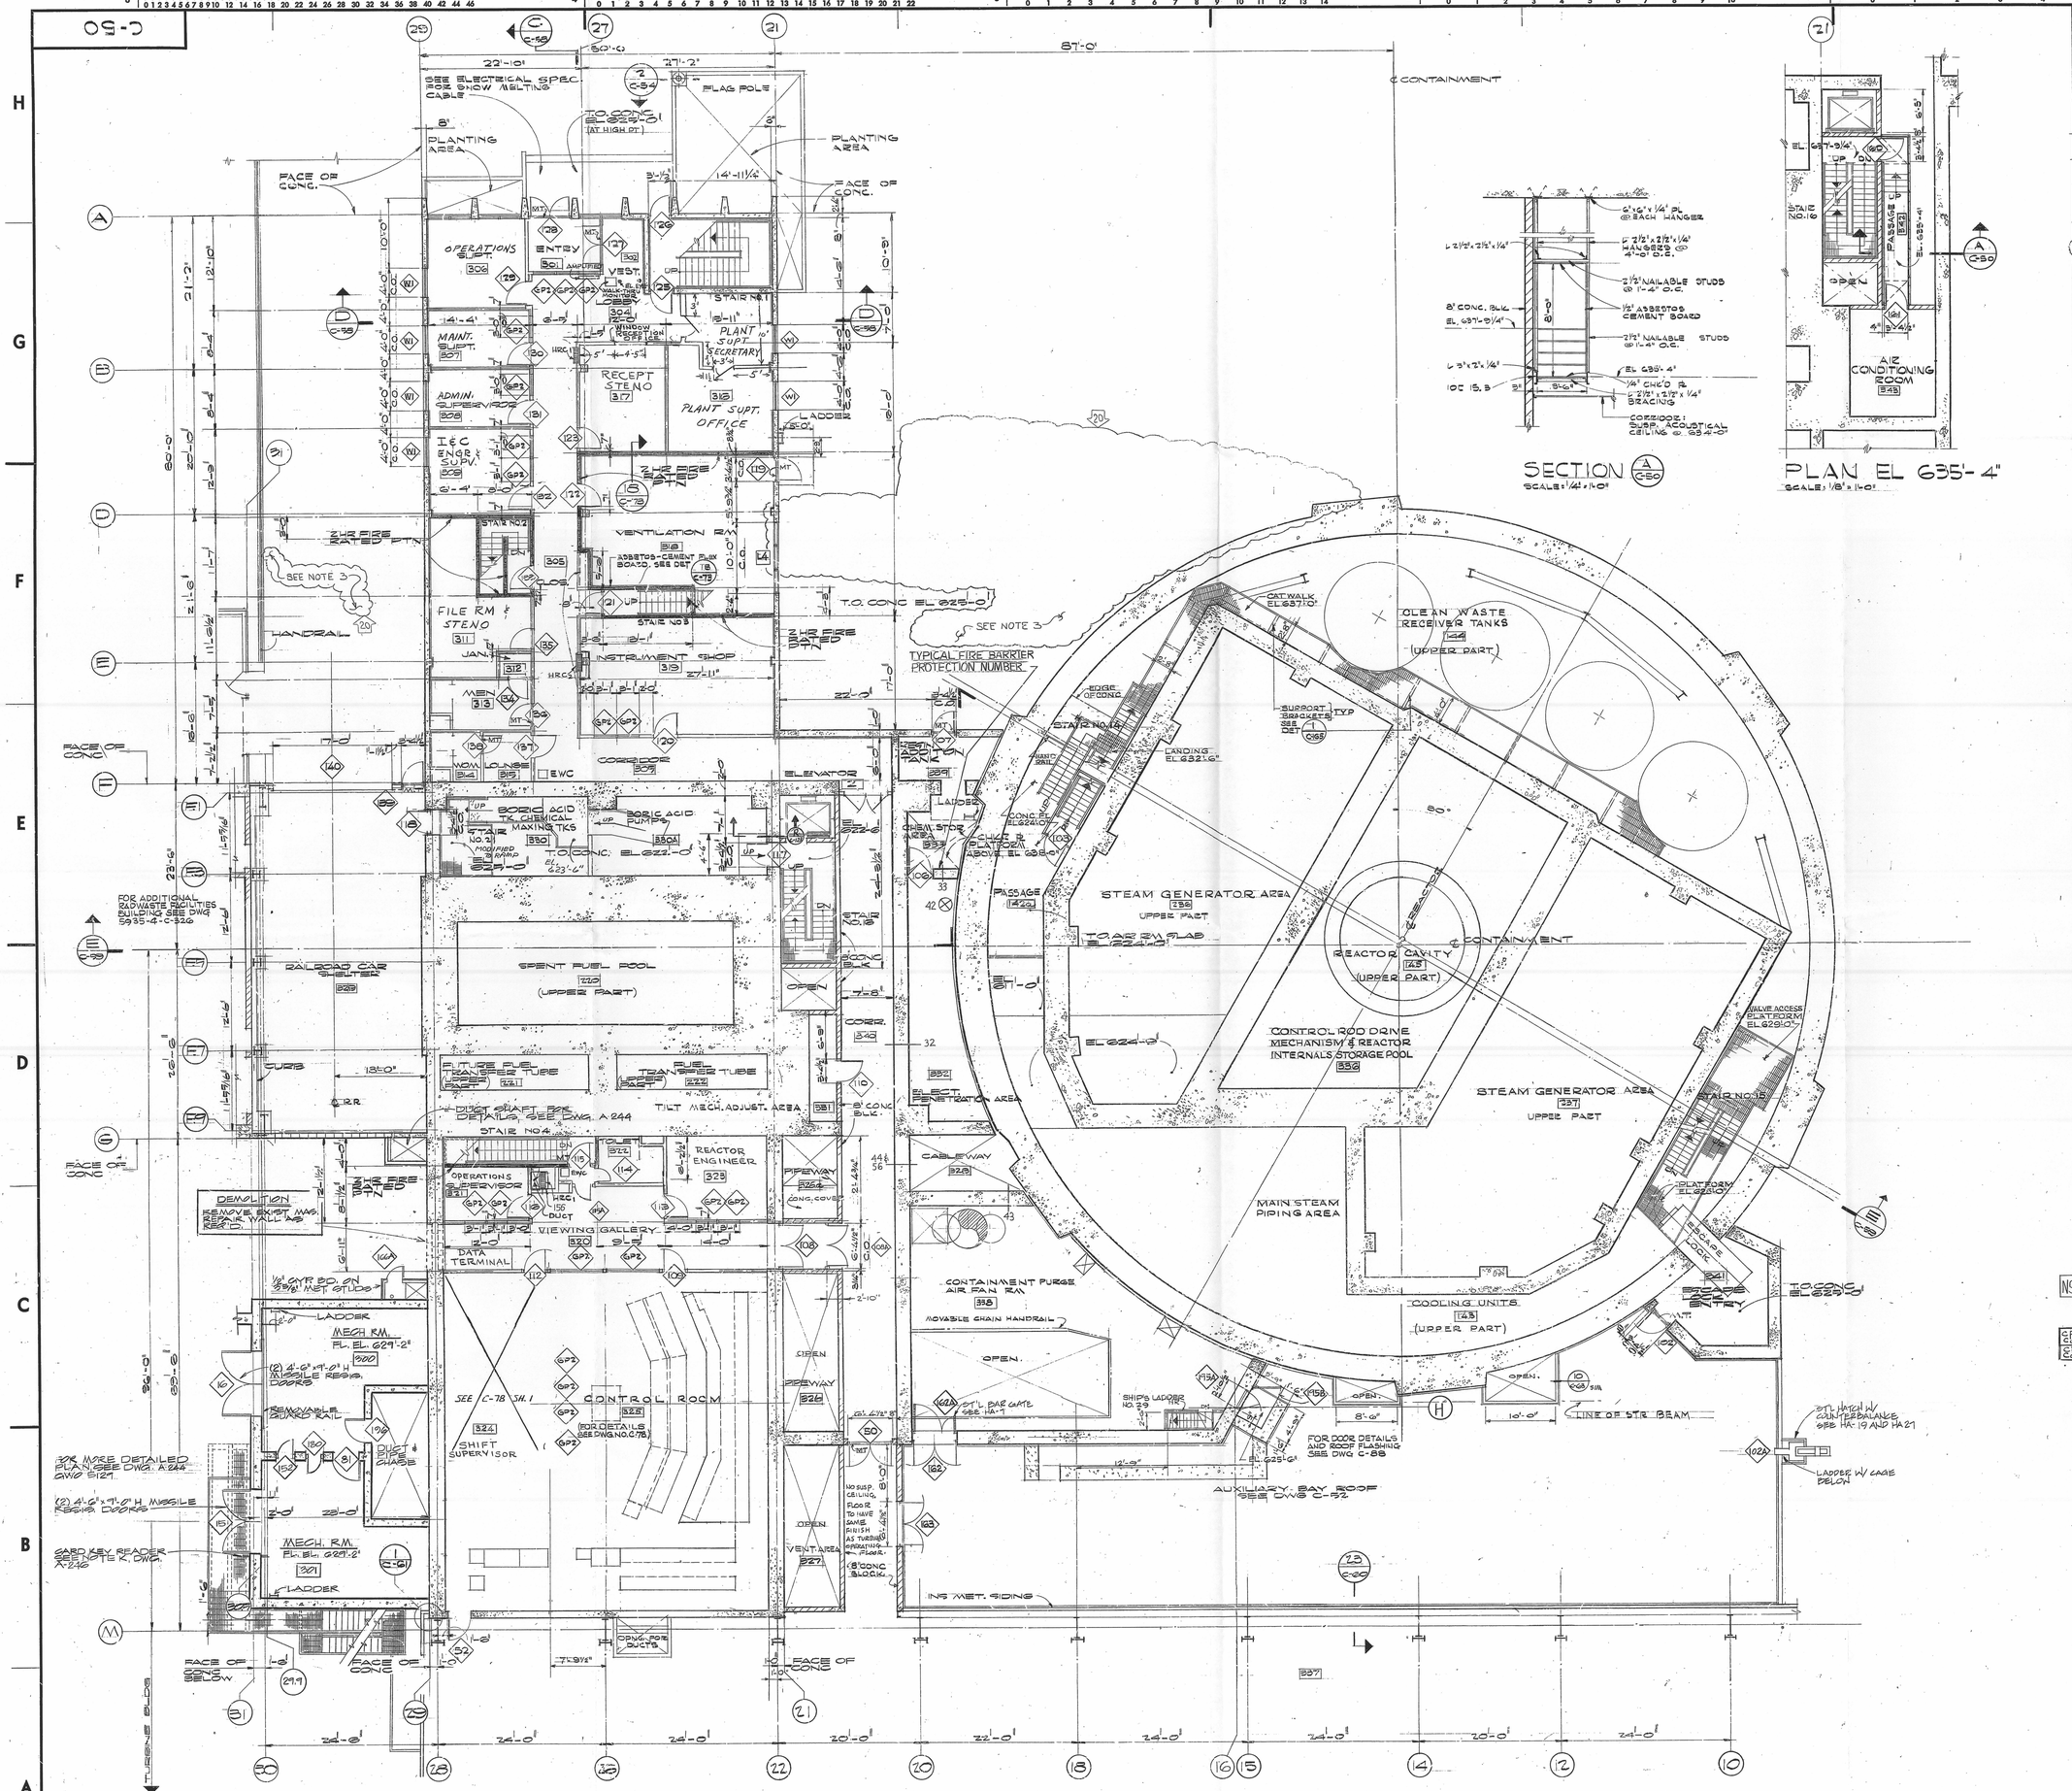

SECTION A/C-50
SCALE: 1/4" = 1'-0"

PLAN EL 635'-4"
SCALE: 1/8" = 1'-0"

NOTES

1. FOR LARGE SCALE DWGS OF EQUIPMENT & EQUIPMENT SUPS SEE DWGS. 5-74 & C-76
2. FOR FIRE HOSE RACK CABINET DETAILS SEE DWG C-49
3. AREAS COATED WITH SIKADUR 22 TO PROTECT FROM WATER INTRUSION PER EAR-96-0334.

20

REV	DATE	DESCRIPTION	BY	DESIGN	CHECK	APP	QA
20	8/25/98	ADDED NOTE 3 PER EAR-96-0334 & DCR-98-100.		MDS		MDS	
19	6-11-97	REVISED CONTROL ROOM PER SC 96-026 AND DCR 97-020		MDS		ST	LR
18	4/8/91	REVISED PIPING, 114, 119, 119A, 120A, ADD. VBL 305, VALVE PER DCR 90-91-354 & STT(MDP)		R			
17	6/1/90	CHG'D. STAIR NO. 21 TO A RAMP PER FC-822, 950-90-271 (KJS)		R		D	BAB
16	11/22/83	ISSUED FOR REVISED FOR TASK OSA GWO 5721		ARJ		RWD	RWD
15	7/11/83	ISSUED FOR REVISED FOR TASK 5721, GWO 5 REVISED TO ISSUED FOR TASK OSA GWO 5721 TO ISSUED		TEAR			

ORIGINAL SENT TO CLIENT
DATE 12-21-79

REV	DATE	DESCRIPTION	BY	DESIGN	CHECK	APP	QA
NSC 14	5-20-82	REVISED PER ECAN 81-218 & DDR-81-090 - FINAL FEM FC-907-13 GWO 5221	CSP			VP	
13	12-21-79	ADDED HATCH HOLES AND ADD. PIPE PER "T O A O" DWGS. ISSUED CHANGED PER "AS-BUILT" ENGINEERS DWG. 5935-4-C-52 & 5935-4-C-53 ISSUED UNDER PROJECT GWO 5221	RS				
C.P.C.O. 12	10-20-76	REMOVED PARTITIONS IN RM. 316. ADDED PARTITIONS IN RM. 316.	L	ERL			
C.P.C.O. 11	12-25-74	RELOCATED SHIFT SUPV. RM. ENGR. & OPERATIONS SUPV. OFFICES	L	ERL			
10	10-28 74	ADDED DOOR NO. 195 & BUILDING WALL, ROOF, OPNGS. 208, 209 PIPE PENETRATION REV. CONTROL ROOM & WALLS COLLINS "S.S." SUIT ADDITIONAL RADWASTE BLDG	MW	AC	ACC		
9	6-13 72	REVISED DUCT, ADDED HEC. AND ROOM 330A, ISSUED FOR AS BUILT. 5935-0	NV	AC	ACC		
8	10-6 69	ADDED AMPLIFIED, ELECTRONIC EYE AND WALK-THRU METTOR AT ROOM 322.	NV	AC	ACC		
7	8-27-68	RELOCATED HOSE RACK CABINET & ADDED NOTE NO. 2	MW	AC	ACC		
6	7-15-68	MOVED DOORWAY 50 IN LINE W/CONC. WALL, ADDED OPENINGS & OFFICES "O" FUTURE CONTROL ROOM. RELEASED HEB-02	NN.D	ARC	ACC		
5	3-20 68	VISION PANEL TYPE, REV. AS NOTED. ADDED H.R.C. & EL 635'-4"	TS	ACC	ACC		
4	2-27-68	DELETED DOOR 151, MOVED DOOR 122, ADDED DOORS 110, 162, 163, REV. STAIRS NO. 14 & 15 & REV. LOCK	N.N.D	ACC	ACC		
3	10-24-67	REV. STRUCT. WITHIN THE CONTAINMENT & REV. CONTROL ROOM 322; CHEM. STOR. 333 DOORS 119 TO RM 318; STAIR NO. 21, IN LINE DIR.	N.N.D	ARC	ACC		
2	7-24 67	REVISED PER NSC 9 REVISED PER NSC 10 REVISED HOLES FOR CABLE	JBD	ACC	ACC		
1	6-16 67	REVISED DOORS & ADDED BOTTLE STORAGE REVISED FLOOR HOLE LINE	JBD	ACC	ACC		
0	5-26 67	ISSUED FOR CONSTR	JBD	ACC	ACC		
No.	DATE	REVISIONS	BY	CHK.	SFTG. SUPVR.	ENG'R	PROJ. ENG'R. CHIEF ENG'R.

SCALE 1/8" = 1'-0" DESIGNED CHEVALIER DRAWN EVANS

BECHTEL COMPANY

PALISADES PLANT
CONSUMERS POWER COMPANY

ARCHITECTURAL
AUXILIARY & REACTOR BUILDINGS
FLOOR PLAN @ EL 625'-0"

BECHTEL	JOB No.	DRAWING No.	REV.
	5935	C-50	20

34 x 44

D-05