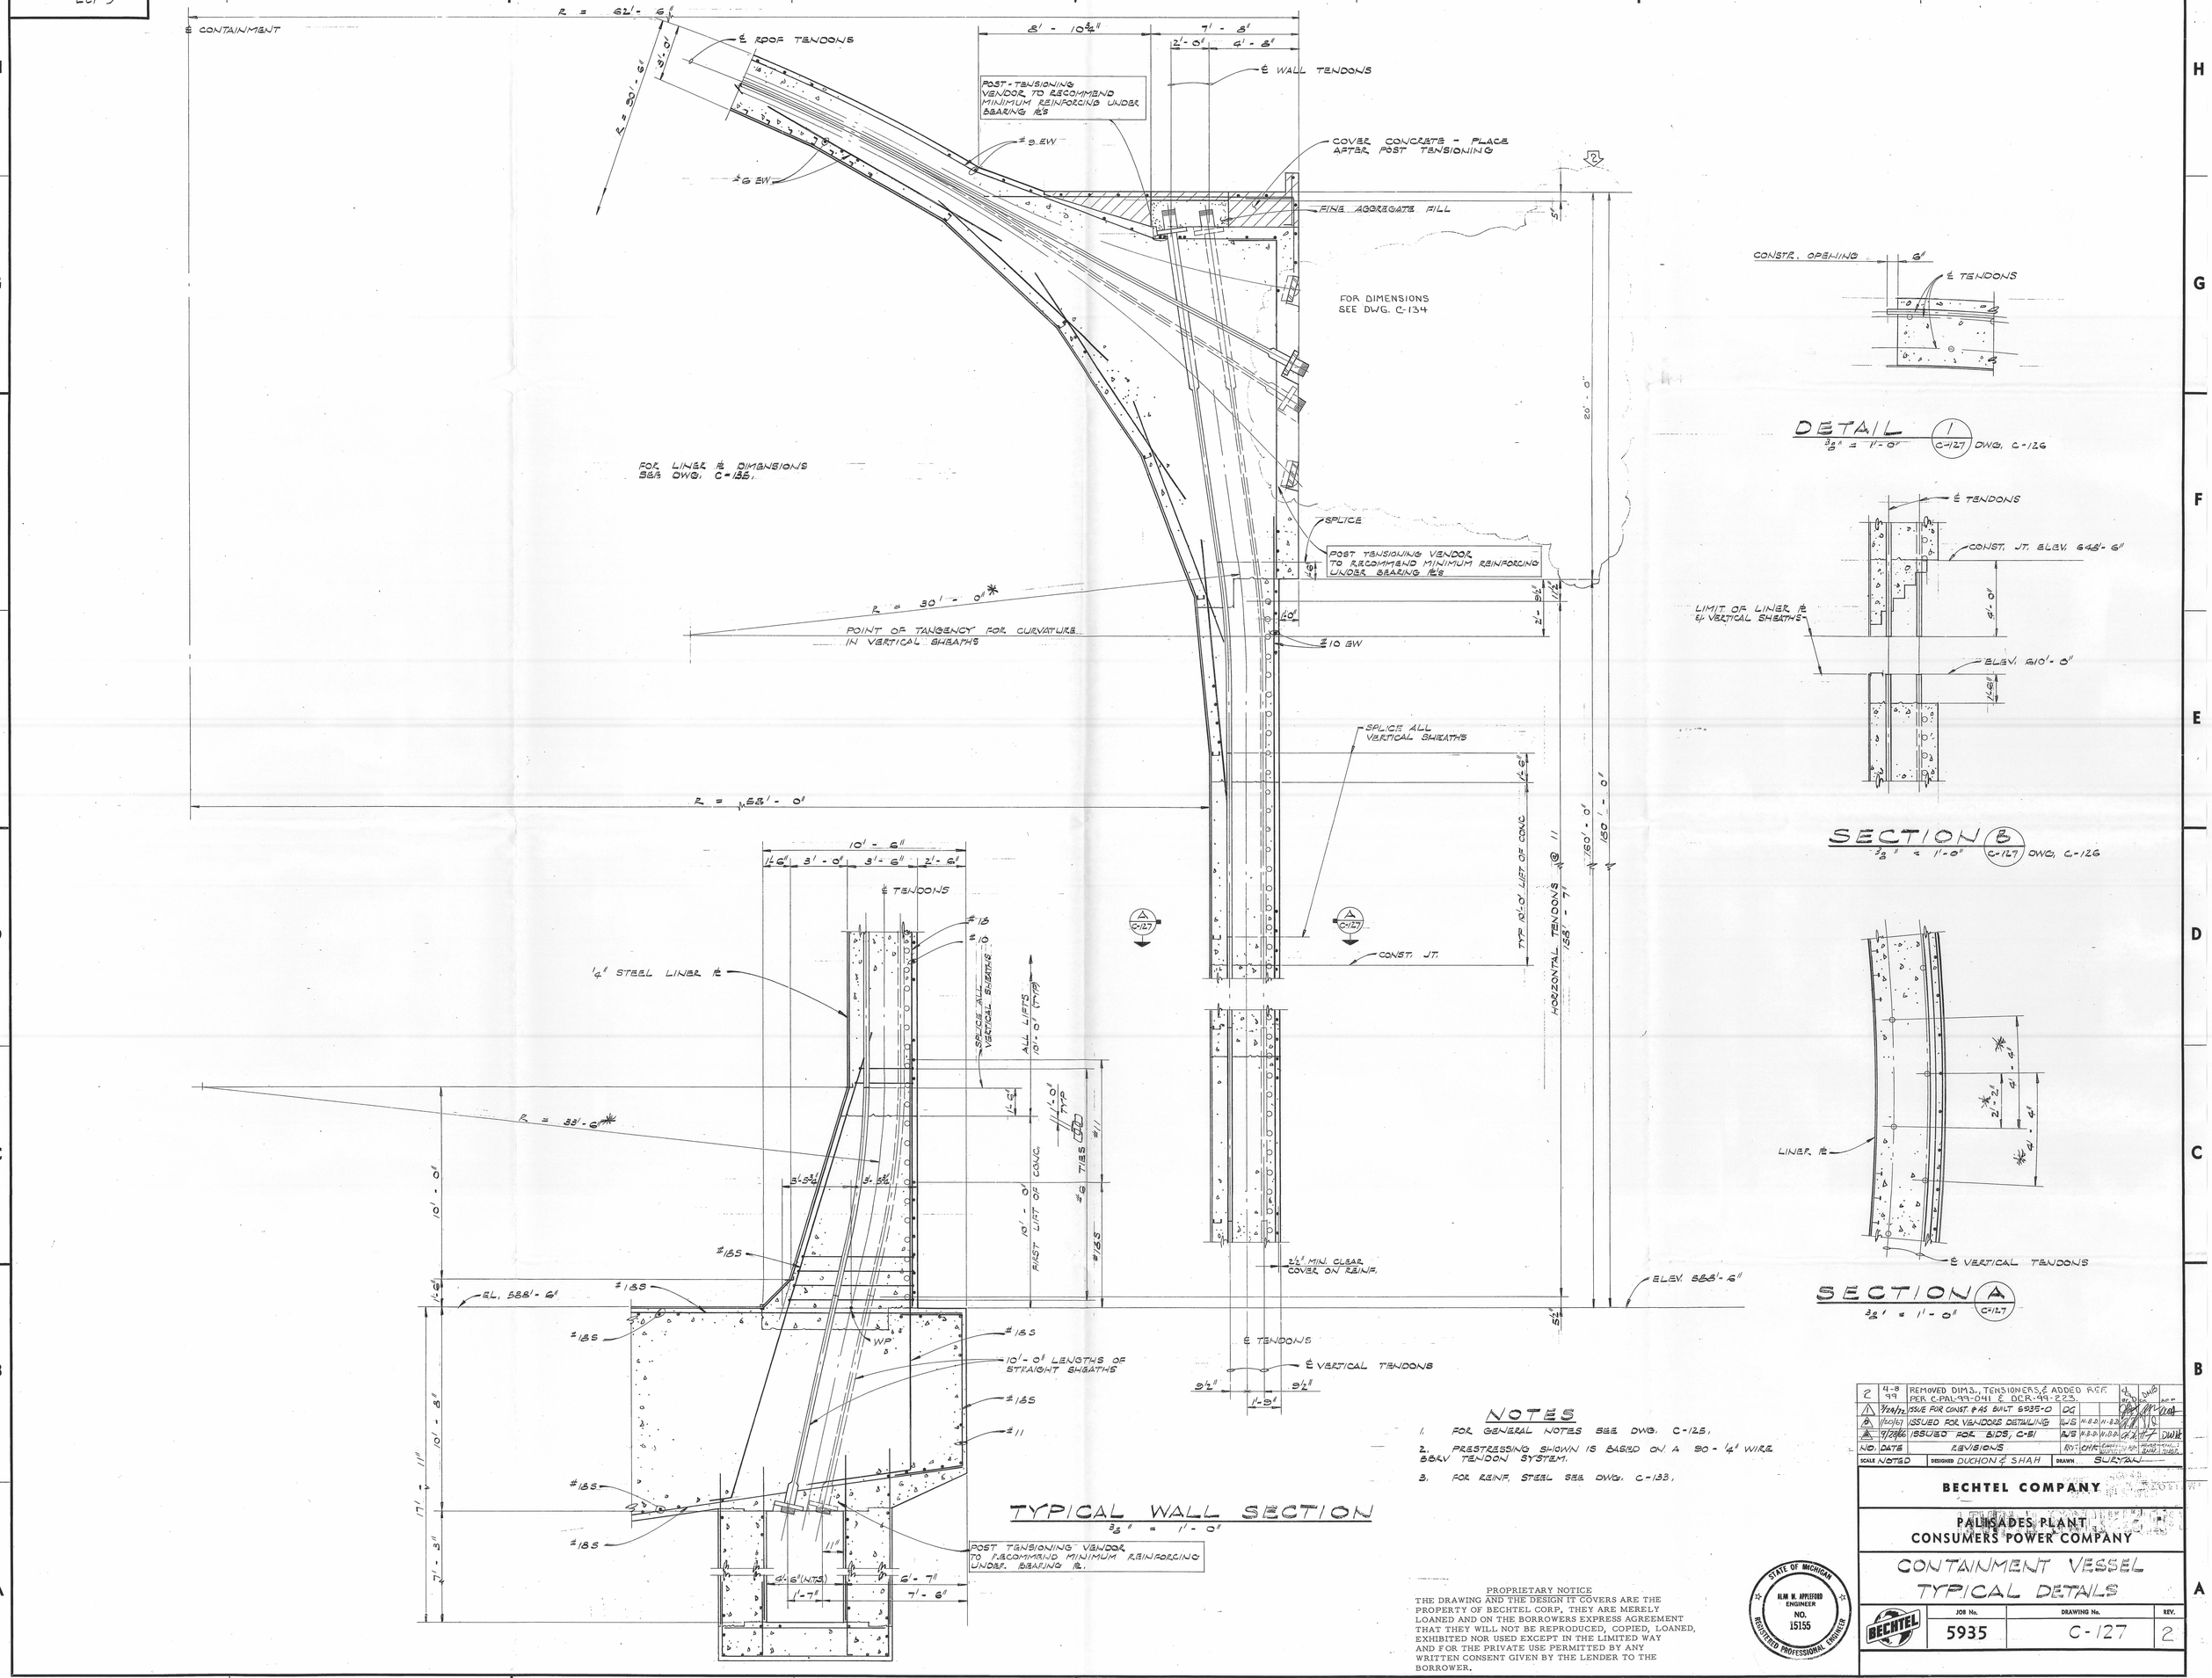

NOTES

1. FOR GENERAL NOTES SEE DWG. C-125.
2. PRESTRESSING SHOWN IS BASED ON A 90 - ¼" WIRE BBRV TENDON SYSTEM.
3. FOR REINF. STEEL SEE DWG. C-133.

PROPRIETARY NOTICE
THE DRAWING AND THE DESIGN IT COVERS ARE THE PROPERTY OF BECHTEL CORP. THEY ARE MERELY LOANED AND ON THE BORROWERS EXPRESS AGREEMENT THAT THEY WILL NOT BE REPRODUCED, COPIED, LOANED, EXHIBITED NOR USED EXCEPT IN THE LIMITED WAY AND FOR THE PRIVATE USE PERMITTED BY ANY WRITTEN CONSENT GIVEN BY THE LENDER TO THE BORROWER.

STATE OF MICHIGAN
ALAN M. APPLEFORD
ENGINEER
NO. 15155
REGISTERED PROFESSIONAL ENGINEER

NO.	DATE	REVISIONS	BY	CHK	CONSTRUCTION	ENGINEERING	DESIGN
2	4-8-99	REMOVED DIMS., TENSIONERS, & ADDED REF. PER C-PAL-99-041 & DCR-99-223.					
1	9/24/92	ISSUE FOR CONST. & AS BUILT 5935-0	DG				
B	12/2/91	ISSUED FOR VENDORS DETAILING	R.S	W.B.D	W.B.D		
A	9/23/90	ISSUED FOR BIDS, C-51	R.S	W.B.D	W.B.D		

SCALE NOTED | DESIGNED DUCHON & SHAH | DRAWN SUETAN

BECHTEL COMPANY

PALISADES PLANT
CONSUMERS POWER COMPANY

CONTAINMENT VESSEL
TYPICAL DETAILS

JOB No.	DRAWING No.	REV.
5935	C-127	2

SIZE E