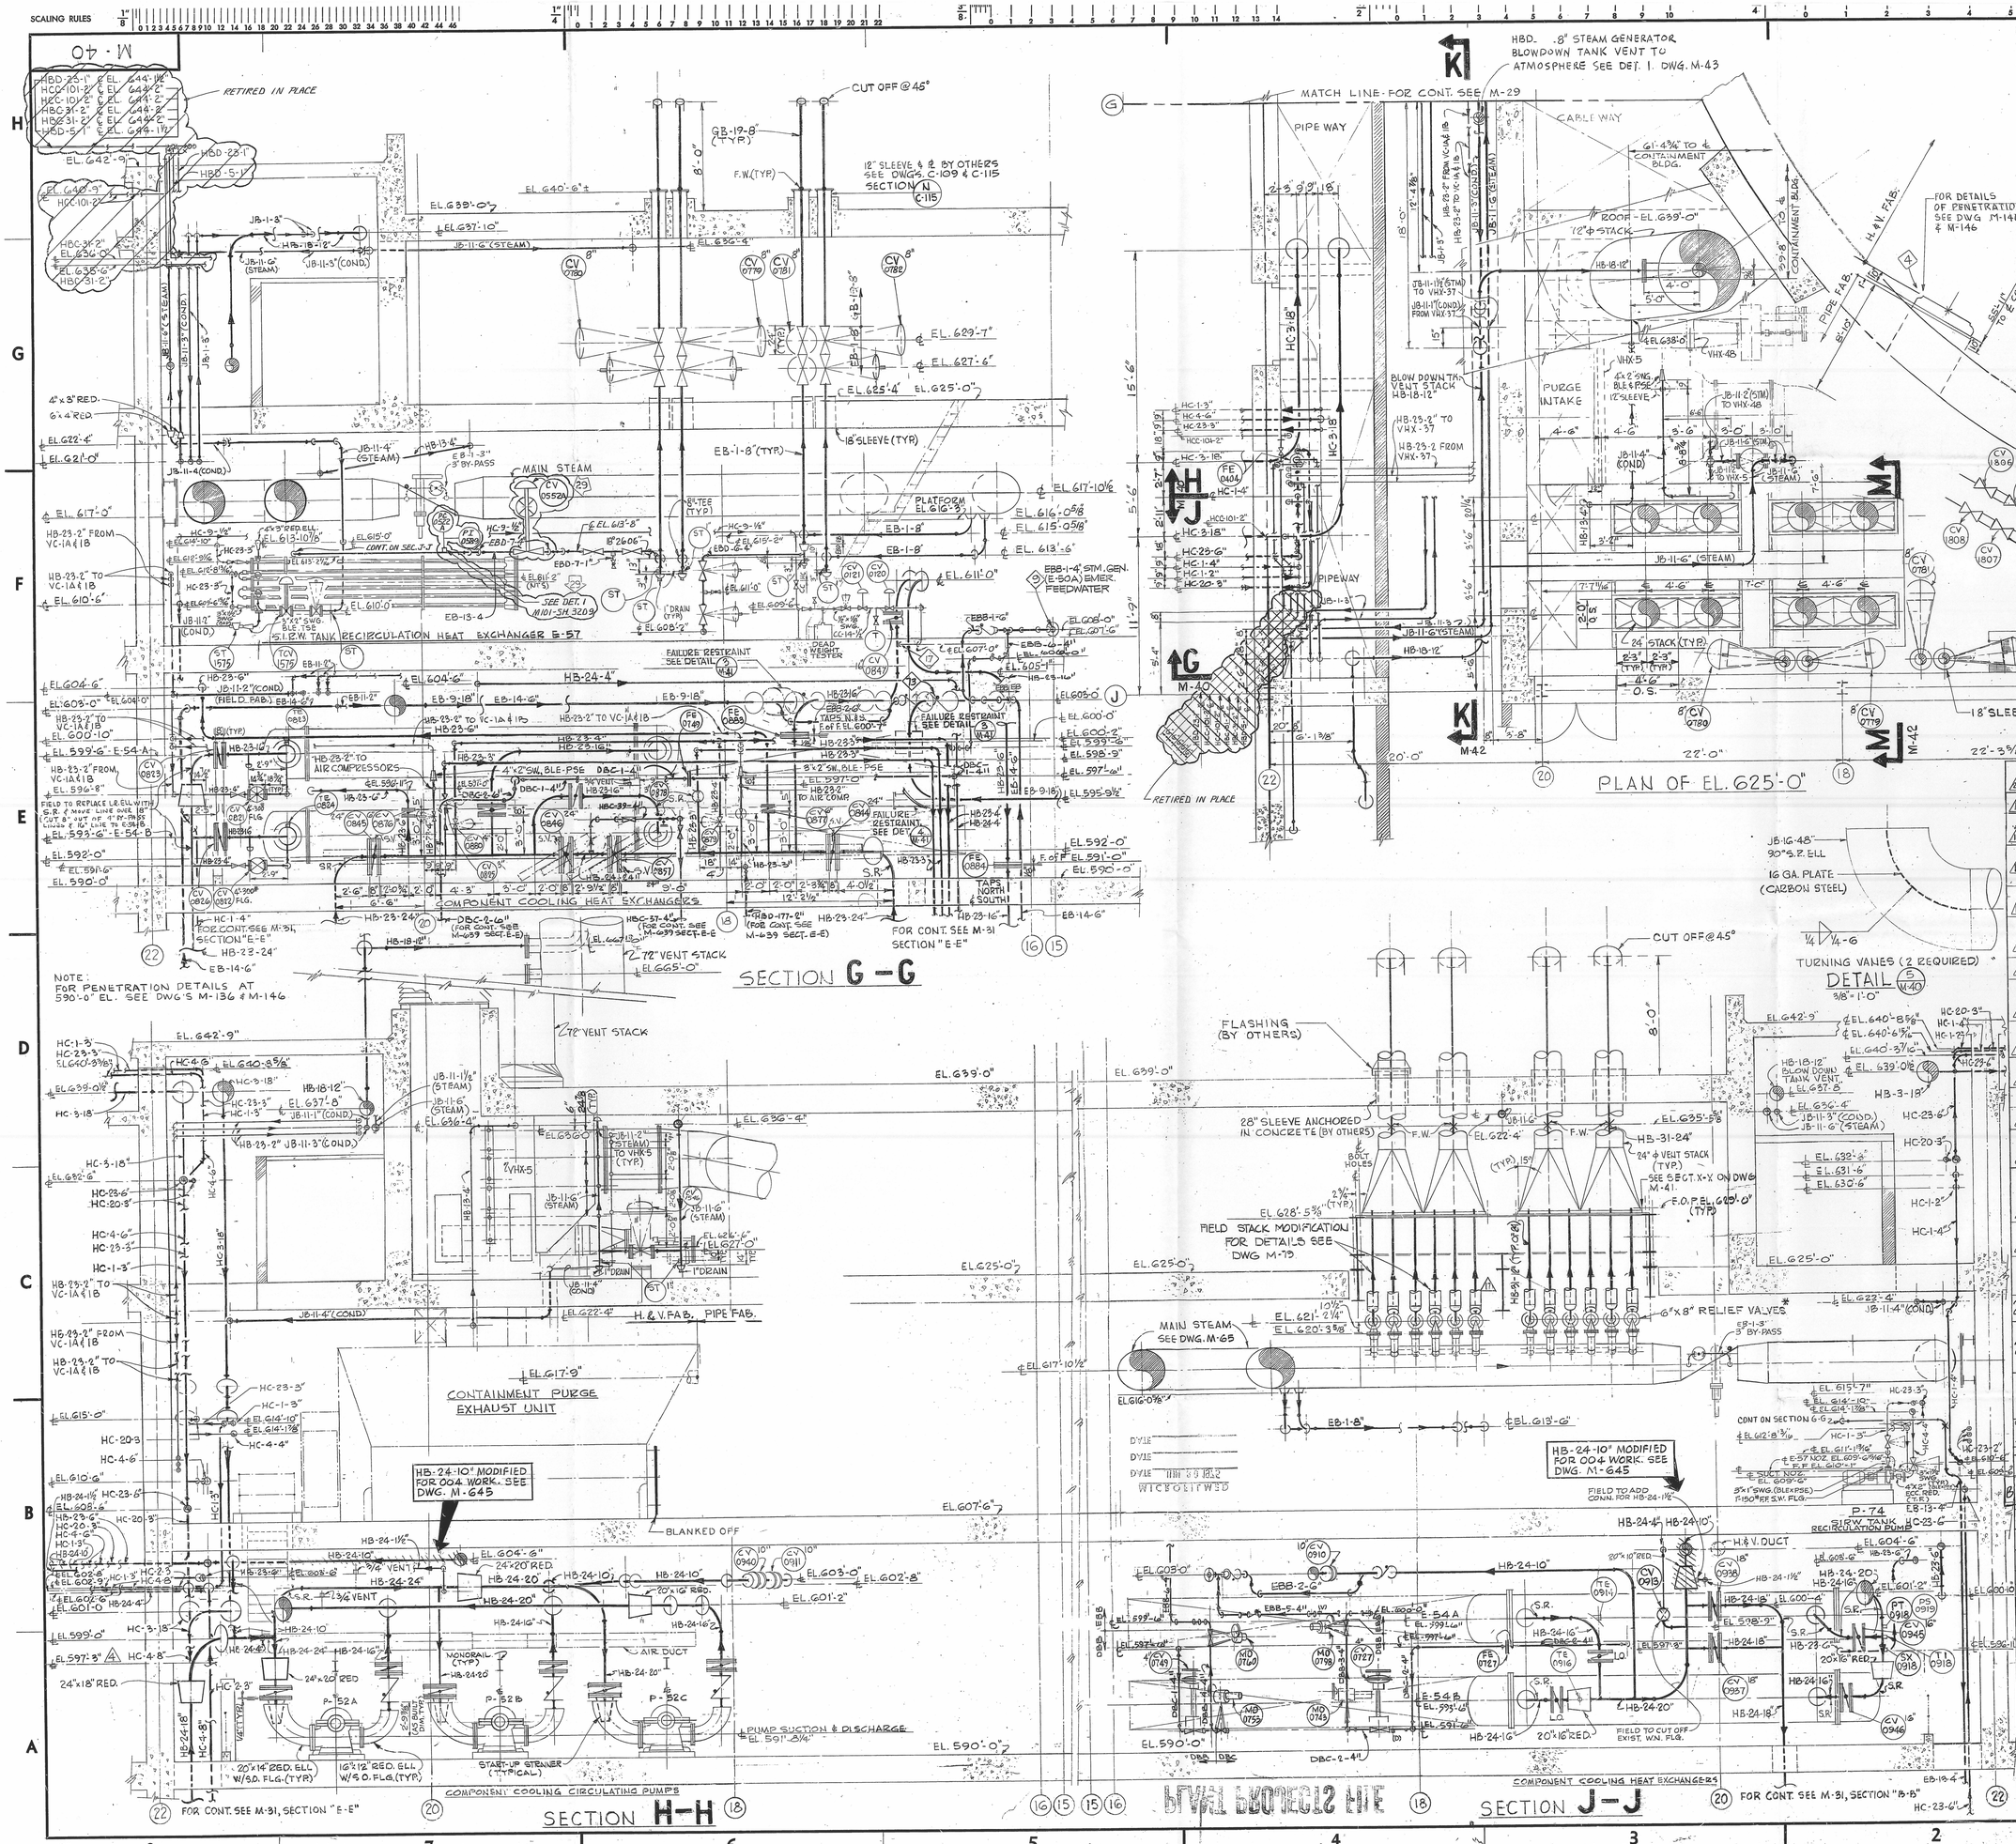

No.	DATE	REVISIONS	BY	CHK	DFTG. SUPVR.	ENGR	PROJ. ENGR	CHIEF ENGR
30	10/22/74	REV. HBD-31 & JB-11 REROUTED EBD-7-4" & PARTIALLY REMOVED EB-13-4" ISSUED AS BUILT	RS LM	AW RS		AW		
19	11-20-73	DELETED LINE EB-45-4 & ADDED LINE EBD-7-4" & EBD-6-4"	RS	JTA				
18	10/30/72	PUNCH LIST ITEM # 27 REVISED STEAM GEN. BLOWDOWN TANK VENT @ H-3 FIELD FAB.	GL			—		
17	9-14-72	MU. STEAM RV. STACK MODIFICATION ISSUED FOR FIELD CONSTRUCTION ADDED HB-13-4" @ F-3, F-7 & C-7 (AS BUILT)	DR GL					
16	4/13/71	REVISED EB-13-4" PER "AS BUILT" @ C-2, AND HB-23-4" @ E-8 PER FSK-M-600 (AS BUILT)	G.L					
15	1/5/71	REVISED PIPING HB-23-4" RELOCATED GATE VALVES AND ADDED CV-0821 AND CV-0822 @ E-8	G.L					
14	4-3-70	HOLD ON NaOH, HC-45-4" PIPING	F.S.C					
13	12/12/69	ADDED HC-45-4" REROUTED HB-23-6" @ SECT. G-G, SECT. H-H & SECT. J-J (BY FIELD) RELEASED HOLD ON EB-1-3" (BYPASS)	F.S.C					
12	8/15/69	REROUTED JB-1-3" & EB-1-8" (BY FIELD REVISED MONORAIL LOCATION OVER P-52A, B & C SECT. J-J FM EL. 635-5⅝ WAS 635'-6	F.S.C					
11	5/5/69	REVISED HB-23-16 (BY FIELD) ADDED MONORAIL OVER PUMPS P52A B & C ADDED ORIFICE FE-0404 IN LINE HC-23-6						
10	3/24/69	REVISED AS FAB: J3-16-48" TO INCORPORATE FLUED HEADS REVISED HB-23-16" & 24", HC-1-4" FIELD TO MODIFY & ADD SEALS	HP					
9	2/27/69	REVISED EB-13-4" @ SECT. J-J. ADDED TEST CONNS. @ JB-16-48" & 12". DELETED P.S. CONNS @ SECT. H-H & ADDED @ SECT. J-J.						
8	11/15/68	ADDED P-74 & PIPING, HB-24-1½", EB-11-2", REVISED E-57 PIPING, ADDED CC-14-½", HC-9-½" DELETED HC-23-1", ADDED HC-23-3", HC-4-4", HC-1-3" & HB-23-2". REVISED JB-11-3" (WAS 4") ADDED JB-11-1½" (STM.) & JB-11-1" (COND.) FOR VHX-37						
7	10/2/68	REVISED HC-1-4" TO CLEAR STUCT. ELEVATION OF MAIN STEAM RELIEF VALVES DISCHARGE HOOD & JB-11-4" (STEAM & CONDENSATE)						
29	2-27 97	REVISED CV-0552A AND ADD PI-0589 & PC-0522A PER FC 966 AND DCR 97-143					MDS	
28	1-18 96	RETIRED IN PLACE (2 PLACES) PER FC-949 & DCR-95-1377					MDS	
	1-4 96	REVISED AT HBC-39 (E-6) PER FC-959 & DCR-95-1173					BY	CK	APR
27	4/23/87	REM. REV. 4 REM FROM - CONTAINMENT PURGE EXHAUST UNIT CV1803 CV1805 CV1806. ADDED TO M-40 CV1805, 1806, 1807, 1808. REV. PER FC-510-5	LH	R/S				DEE	
CPC 26	4/17/86	REVISED PLAN & SECTION G-G PER GWO 6861	JSS						
B 25	3/9/84	INCORPD. JOB 12447-059 PER GWO 8343 (SECT. G-G) & SECT. J(A-3) & ISSUED FOR RECORD	TP			—			
B 24	6/10/82	INCORPD. SUB JOB 12447-051 (EBB-2-6") PER GWO 8355 & ISSUED FOR RECORD	RM			—		PKS	M
23	6-8-79	CORRECTED HB-23-16 AND MOVED CV-0824 TO EL. 582'-4" AS BUILT.	CJV			CEN			
22	5-15-79	REVISED FOR RECORD	CJV	DKP					
21	1-26-79	REV. JB-11-4" PER SFC 78-80.	CJV	BLH					

SCALE 1/4" = 1'-0" DESIGNED M. E. LUDWICK DRAWN M. E. LUDWICK

BECHTEL COMPANY

PALISADES PLANT
CONSUMERS POWER COMPANY

PIPING DRAWING AREA 3
PLAN OF EL. 625'-0" & SECTIONS

JOB No.	DRAWING No.	REV.
5935	M-40	29

D-11