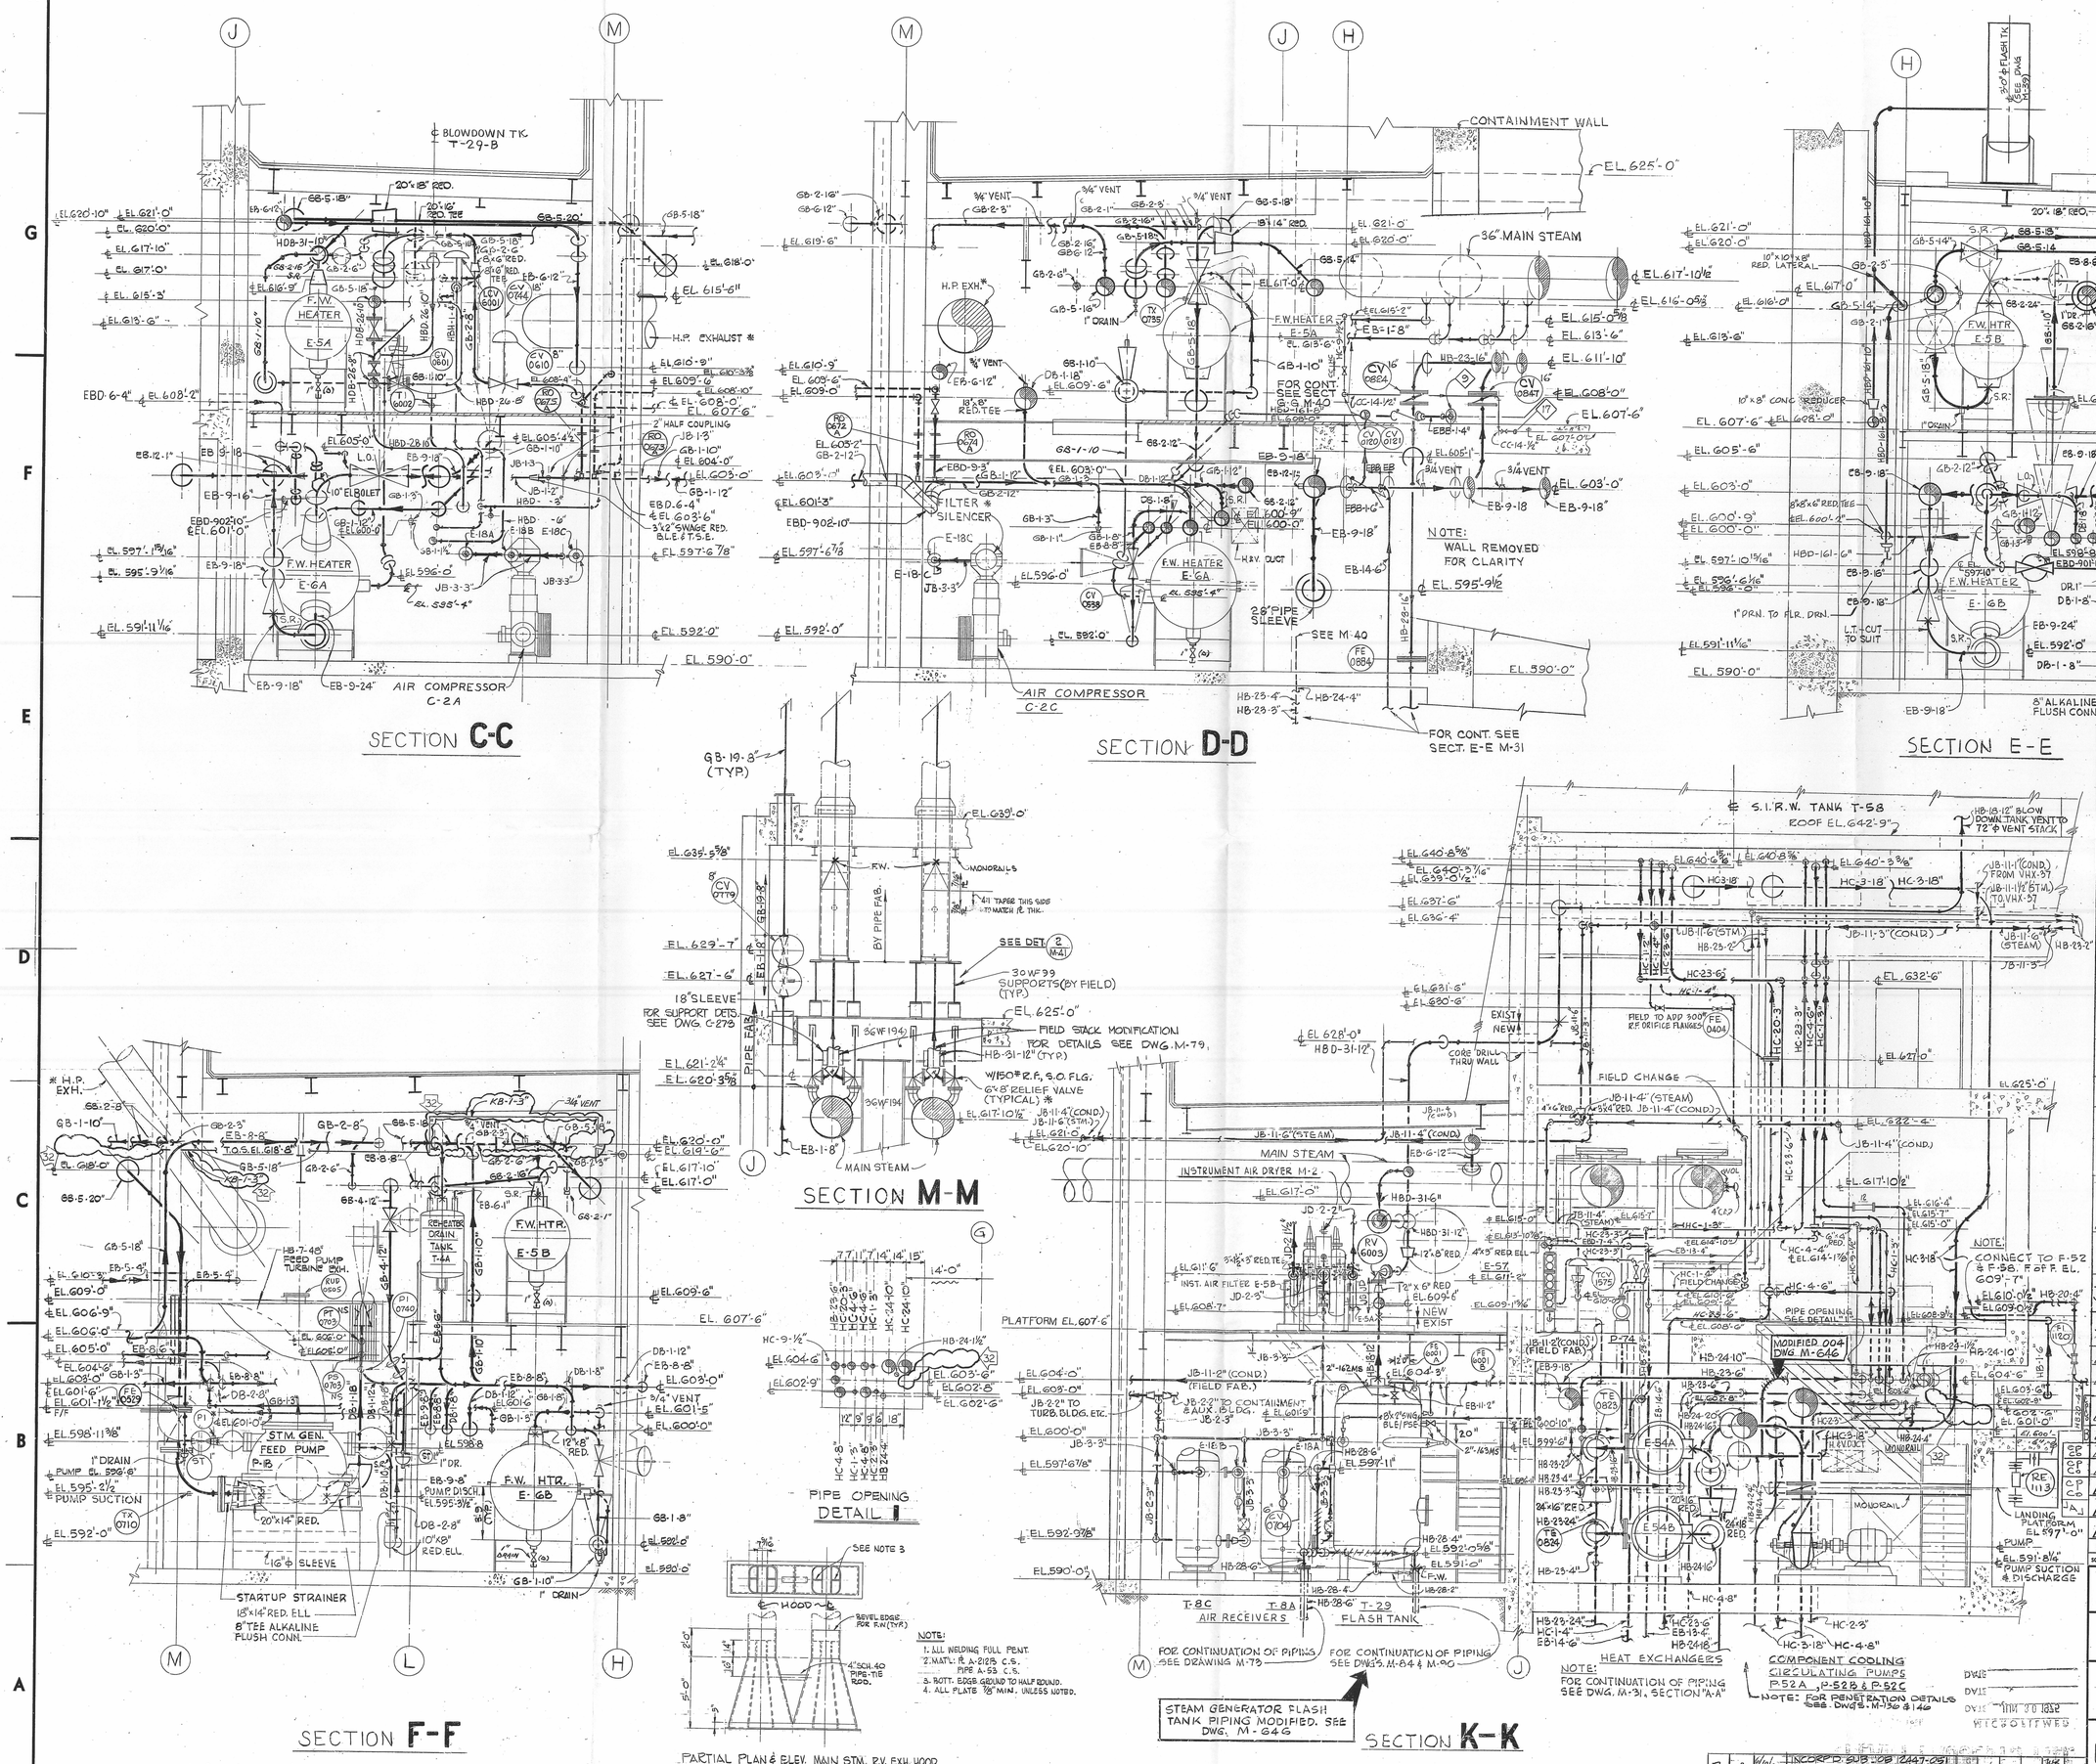

No.	DATE	REVISIONS	BY	CHK	DFTG. SUPVR.	ENGR.	PROJ. ENGR.	CHIEF ENGR.
20A	2/23/79	CHANGED T-29 TO FLASH TK. ADDED BLOWDOWN TK. T-29B & LINES HBD-26, 28 & 31	LHM					
19	11-30-73	DELETED LINE EB-45-4" & ADDED LINE EBD-6-4" @ E-7	GL	JFK				
18	9-14-72	MU STEAM R.V. SIDE MODIFICATION ISSUED FOR FIELD CONSTRUCTION	DR					
17	5/19/72	REPLACED EQUAL VENTS EB-6 WITH EBD1 & EBD-3. ADDED 2-4" NOZZLES ON T-6A	GL					
16	11/1/71	REVISED FEED PUMPS RECIRC. LINES DB-2-8" @ B-B & F-1	GL					
15	8/5/71	CHANGED LINE SIZE FROM 6" TO 8" DB-2-8". F-1 & B-B.	LB					
14	4-30-70	HOLD ON HC04, HC46-4" PIPING	FSC					
13	10/10/69	ADDED HC-45-4" ON SECT. K-K. ADDED HB-28-4" & HB-28-2" @ STM. GEN. BLOWDOWN TANK. REROUTED HB-23-6" @ SECT. K-K. (BY FIELD)	FSC					
12	8/15/69	ADDED PARTIAL PLAN & ELEV. OF MAIN STM. R.V. EXH. HOOD & NOTES ADDED PARTIAL SECTION "Y-Y" REV. SECTION "M-M" REV. MONORAIL LOCATION ON SECT. "K-K"	FSC					
11	5/5/69	REVISED HB-23-16" (BY FIELD) ADDED: MONORAIL OVER PUMPS P-1A, B & ADDED DRIP FE 0404 IN LINE HC-23-6"	HP					
10	3/28/69	REVISED HC-1-4", HC18-3" & HC4-8" FIELD TO MODIFY PIPING AND ADD SEALS.	HP					
9	2/27/69	CHANGED LINE NO. FROM HB-1-4" TO HB-20-4". REVISED EB-13-4" @ SECT. K-K. ADDED TEST CONN. @ JB-16-4" SECT. EL. DELETED KB-1-6" @ SECT. C-C.						
8	11/25/68	ADDED KB-1 FIRE SYSTEM						
7	11/15/68	REVISED E-57 & PIPING. DELETED HC-23-1". ADDED P-74, HC-4-4", HC1-3", HC-23-3", HB-24-1 1/2", HC-9-1/2", CC-14-1/2", EB-11-2", & HB-23-2". REVISED JB-11-3 (WAS 4") ADDED JB-11-1 1/2" (STM.) & JB-11-1 (COND) FOR V.W.S.T. REVISED KB-1-3, BECOMES KB-1-2"						
6	10/2/68	REVISED JB-11-4" (STM. & COND.) HC1-4" INCORPORATED DCN 4". ADDED HB-23-6, HB-28-6", CV-0704 & CV-0778B, EB-1-8" & GB-2-8". REMOVED HOLD FROM INSTRUMENT AIR DRYER & FILTERS.						
32	2-23-96	REMOVE KB-1-2" IN DETAIL 1 & SEC. K-K REVISE KB-1-2" IN SEC. F-F PER DCR-95-1366						
31	4-2-92	ADD RV 6003, E-61, E-58, E-51 AND E-58 PER GMD 0403 / FC 875 / DCR 380-91-382 (MOD)						
30	3/13/90	REVISED SECTION D-D & SECTION E-E PER FC-850 & 850-90 DCN 0484 (MOD)						
29	7/23/87	REMOVED REV 4 DELETED SECTION L-L REVISED PER FC-510-5						
28	7/29/82	ADDED DRAINS EBD-9-3 FROM MSR E-5A, E-6B & E-6A. OD, GMD 0408						
27	8/20/78	THIS DWG. SUPERCEDES M-9042-ISSUED FOR RECORD REMOVED REV. 3						
26	11-10-76	CORRECTED DIMENSION TO 163-MS						
25	10-20-76	REVISED PER FC #272						
24	7-20-76	AS BUILT - ADDED 162-MS & 163-MS PER FC. 322						
23	4-19-76	REROUTE EBD-7-4" GMD 7639						
22	10/22/74	ADDED T1-6002 @ F-7 & REV. EBD-7, HBD-26, 28, 31 & JB-11, ISSUED AS-BUILT						

SCALE 1/4" = 1'-0" DESIGNED M.E. LUDWICK DRAWN M.E. LUDWICK

BECHTEL COMPANY

PALISADES PLANT
CONSUMERS POWER COMPANY

PIPING DRAWING AREA 3
SECTIONS

BECHTEL

JOB No.	DRAWING No.	REV.
5935	M-42	32

NO	DATE	REVISIONS	BY	CHK	DFTG. SUPVR.	ENGR.	PROJ. ENGR.	CHIEF ENGR.
B	8/10/82	INCORP'D SUB-JOB 1247-051 (EBD-1-12) PER GMD 0852 & ISSUED FOR RECORD						

M-42

SIZE E

D-12