Cross Section Locations

FIGURE 2.5.5-201

Rev 0

COMANCHE PEAK NUCLEAR POWER PLANT
UNITS 3 AND 4

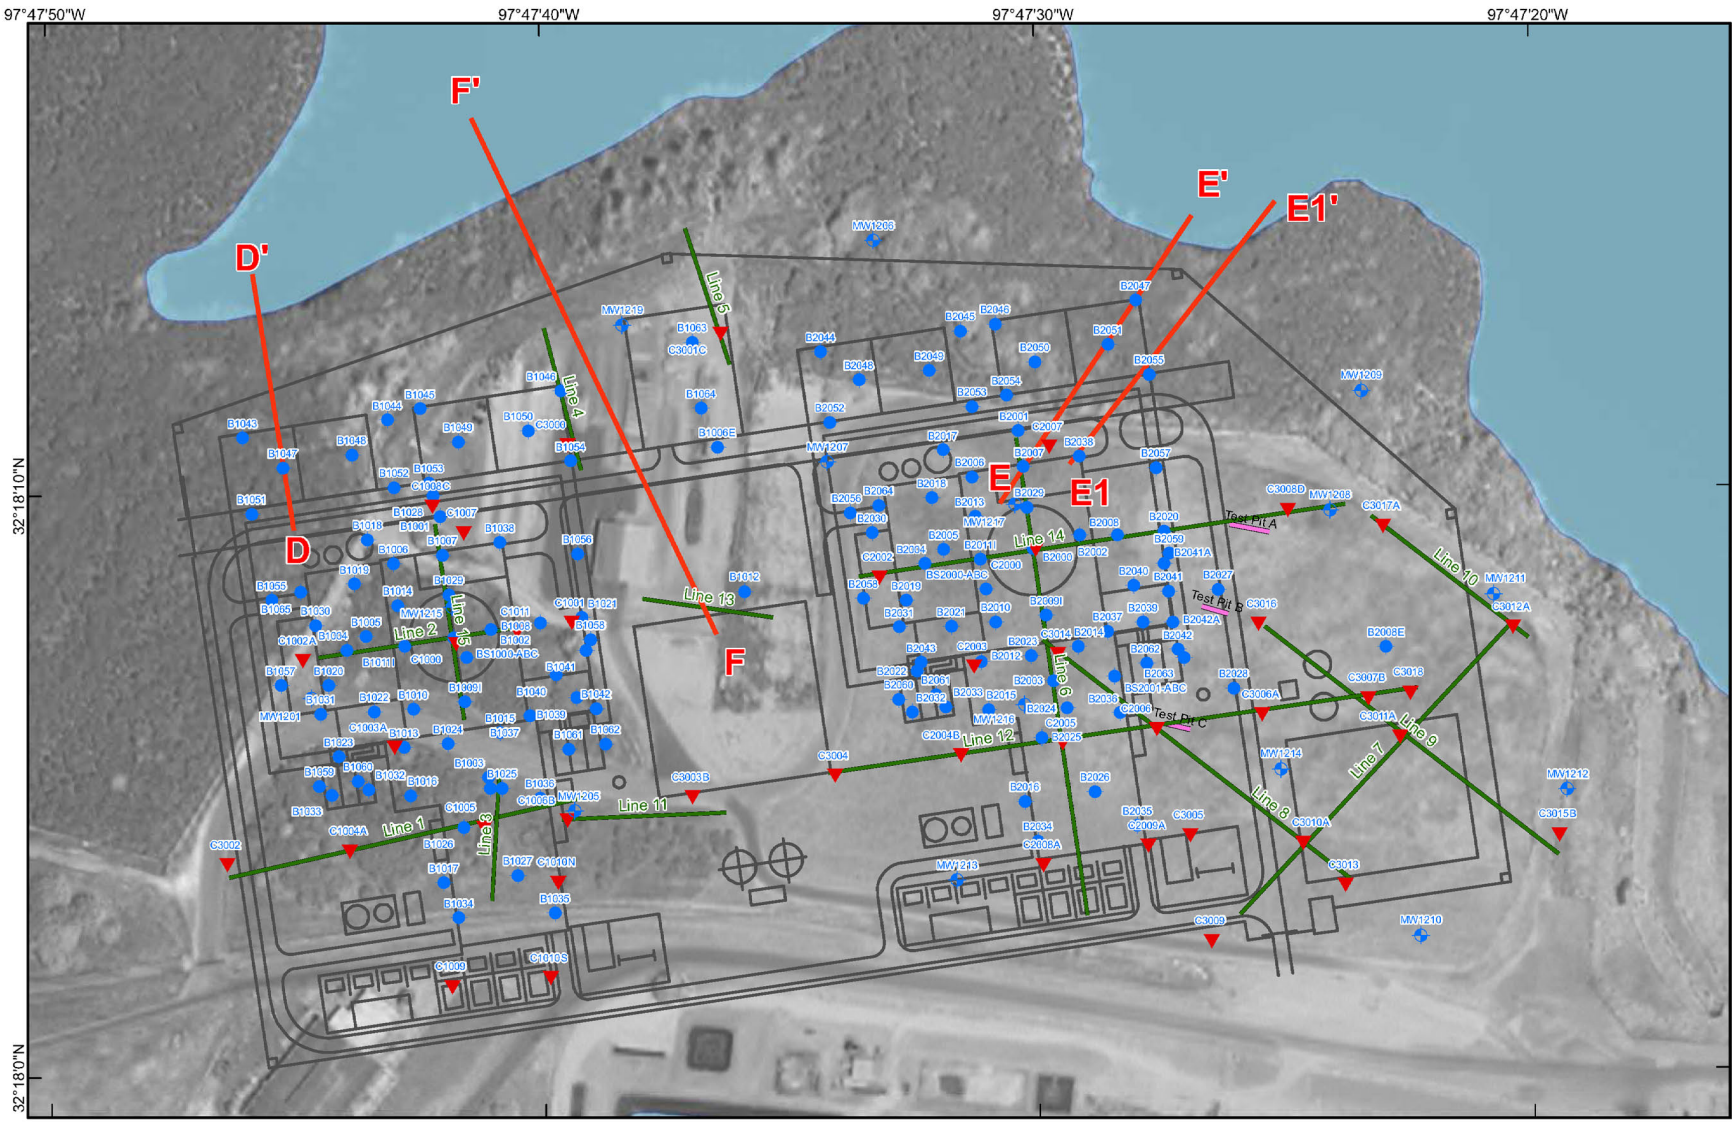

Explanation

2007 Investigation

Type

- Boring
- CPT
- Monitoring Well

- Refraction lines
- Test pits
- Slope Stability Cross Sections
- Units 3 & 4 Layout

Sources: As-built Locations (GDM, 2007)
Test pits & Refraction Lines (WLA, 2007)
Layout (WGI, 2008)

Projection: NAD83 State Plane, Texas North Central (ft)

N

0 300 ft

0 100 m