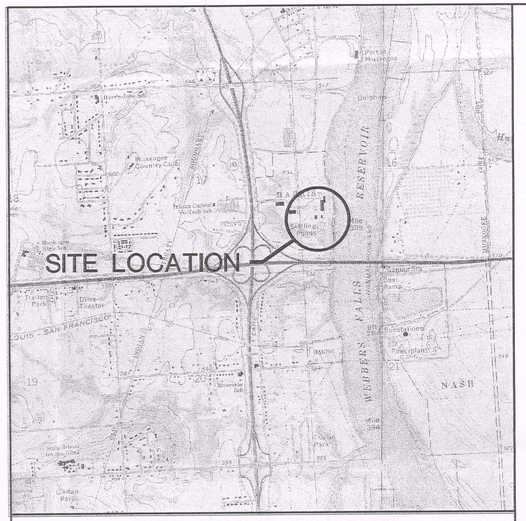

SITE LOCATION MAP

N

SCALE - FEET
0 1000

OKLAHOMA
QUADRANGLE LOCATION

REFERENCE
USGS 7.5-MIN TOPOGRAPHIC QUADRANGLE
STIGLER NE, OKLAHOMA, DATED 1963, PHOTO REVISED 1979.
NORTEAST, OKLAHOMA, DATED 1974.
SCALE 1:24000.

PREPARED FOR

Fansteel, Inc.
Muskogee, Oklahoma

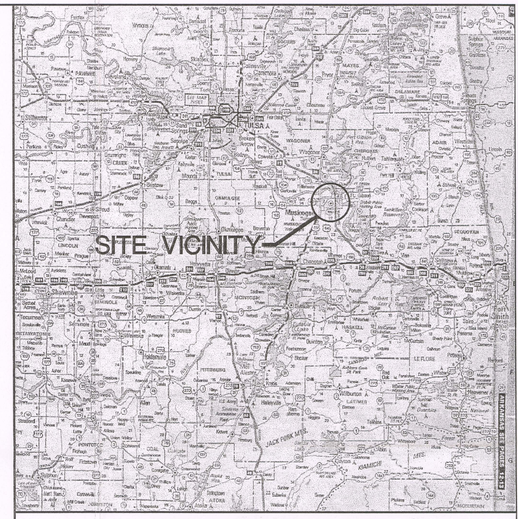

SITE VICINITY MAP

STATE OF
OKLAHOMA
SCALE 1" = 22.2 MILES

REFERENCE
AAA ROAD ATLAS
DATED 1994

EXCAVATION AND ON-SITE MANAGEMENT OF RADIOLOGICALLY AFFECTED SOILS AND GROUNDWATER COLLECTION TRENCH AS-BUILT DRAWING PACKAGE

SHEET NUMBER	DRAWING TITLE
CD-1	TITLE SHEET
CD-2	PRE-CONSTRUCTION CONDITIONS ⚠
CD-3	CONSTRUCTION PLAN
CD-4	TRENCH PROFILE STA. 0+00 - 15+70.00
CD-5	TRENCH PROFILE STA. 15+70.00 - 30+98.71
CD-6	TRENCH DETAILS
CD-7	MISCELLANEOUS DETAILS
CD-8	MISCELLANEOUS DETAILS
CD-9 ⚠	EXCAVATION DETAILS AND CONFIRMATION SAMPLING

PREPARED BY

EARTH SCIENCES CONSULTANTS, INC.
EXPORT, PENNSYLVANIA

REVISION	DATE	DESCRIPTION
⚠	11/18/99	AS-BUILT

CD-1
TITLE SHEET
EXCAVATION AND ON-SITE MANAGEMENT OF RADIOLOGICALLY AFFECTED SOILS AND GROUNDWATER COLLECTION TRENCH
CONTRACT DRAWING PACKAGE
MUSKOGEE, OKLAHOMA
PREPARED FOR
FANSTEEL, INC.
MUSKOGEE, OKLAHOMA

D-01

APPROVED
CHECKED JM 12/15/99
DRAWN WJA/29JAN1998
DRAWING NUMBER
3789500

Earth Sciences Consultants, Inc.