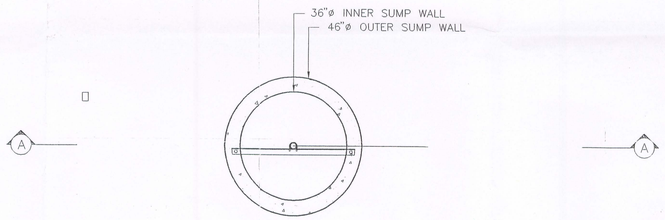

DETAIL CD6-1
PLAN VIEW
SUMP MANHOLE, VALVE AND METER BUILDING
SCALE 1/2" = 1'-0"

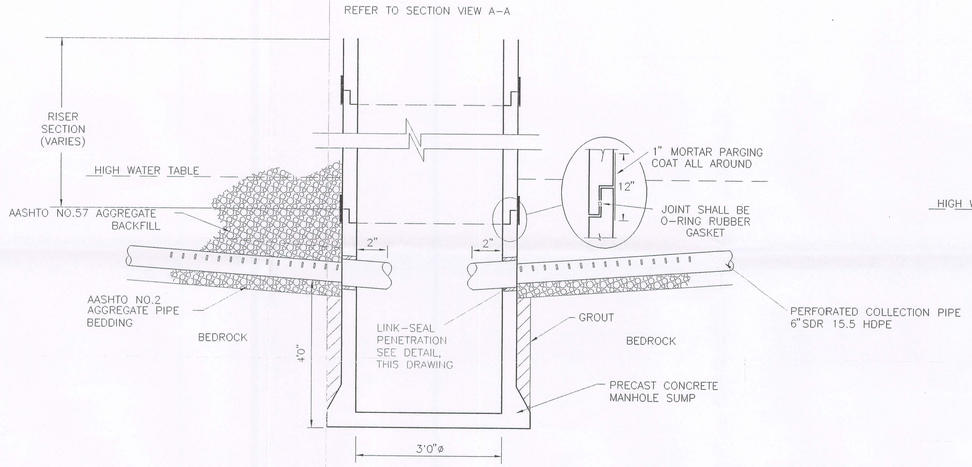

SECTION B
TYPICAL PRECAST CONCRETE MANHOLE SUMP
NOT TO SCALE

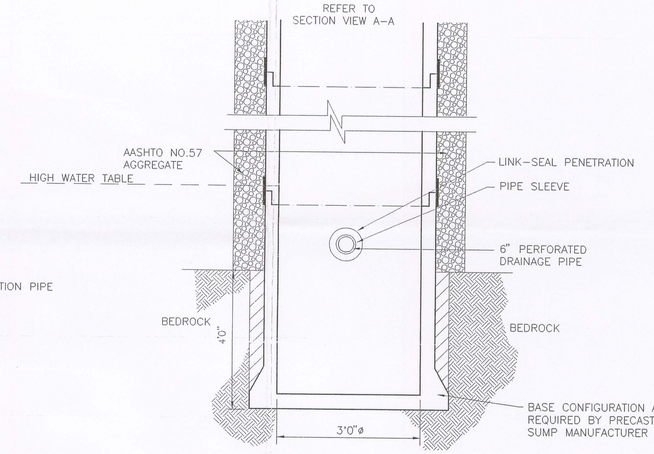

SECTION C
TYPICAL PRECAST CONCRETE MANHOLE SUMP
TRENCH LINE VIEW
NOT TO SCALE

NOTES:
1. ALL SHADED ITEMS ARE TO BE INSTALLED BY OTHERS.
2. THE CONTRACTOR SHALL COORDINATE WORK WITH WASTEWATER TREATMENT FACILITY CONTRACTOR.

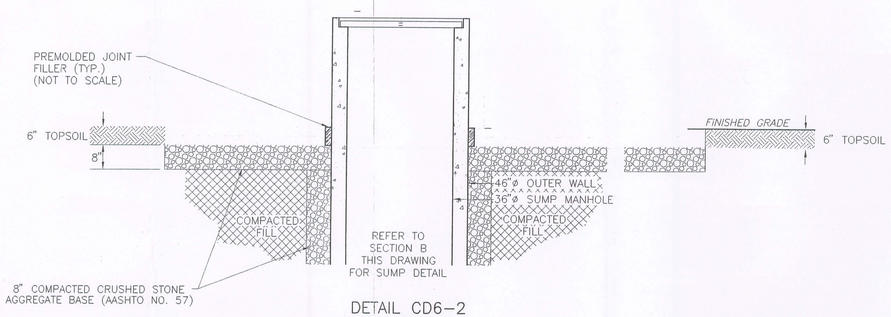

DETAIL CD6-2
SECTION VIEW A-A
MANHOLE, VALVE AND METER BUILDING
SCALE 1/2" = 1'-0"

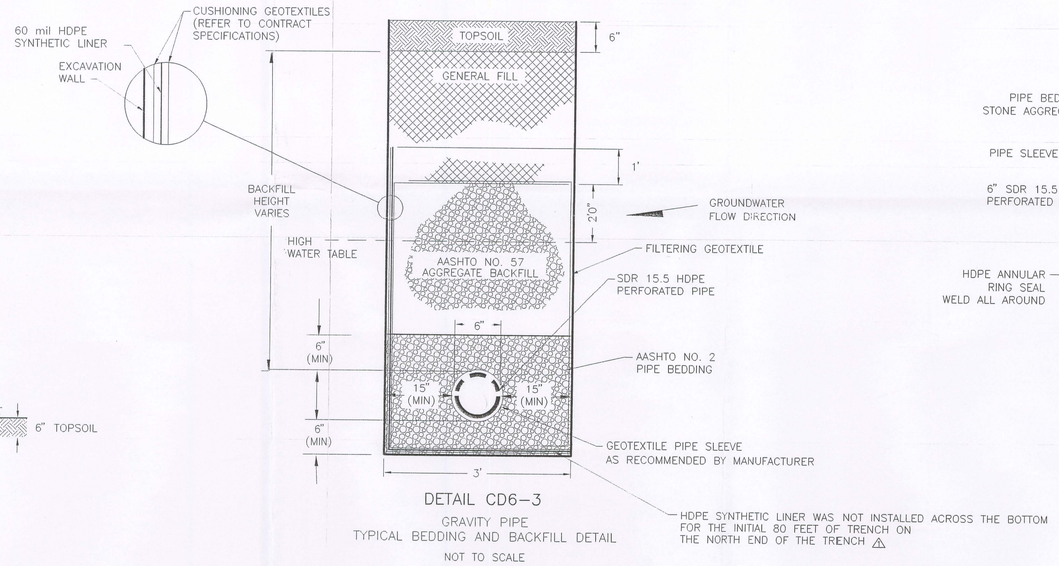

DETAIL CD6-3
GRAVITY PIPE
TYPICAL BEDDING AND BACKFILL DETAIL
NOT TO SCALE

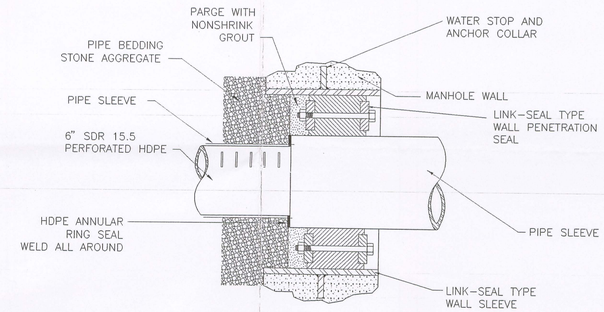

DETAIL CD6-4
TYPICAL LINK-SEAL DETAIL
NOT TO SCALE

REVISION	DATE	DESCRIPTION
△1	11/18/99	AS-BUILT

CD-6
TRENCH DETAILS
EXCAVATION AND ON-SITE MANAGEMENT OF RADIOLOGICALLY AFFECTED SOILS AND GROUNDWATER COLLECTION TRENCH
CONTRACT DRAWING PACKAGE
MUSKOGEE, OKLAHOMA

PREPARED FOR
FANSTEEL, INC.
MUSKOGEE, OKLAHOMA D-06

APPROVED [signature]
CHECKED PM 12/15/99
DRAWN WJA/29JAN1998
DRAWING NUMBER
3789506

Earth Sciences Consultants, Inc.