A200629

INDIAN POINT UNIT NO. 2

PLANT NORTH

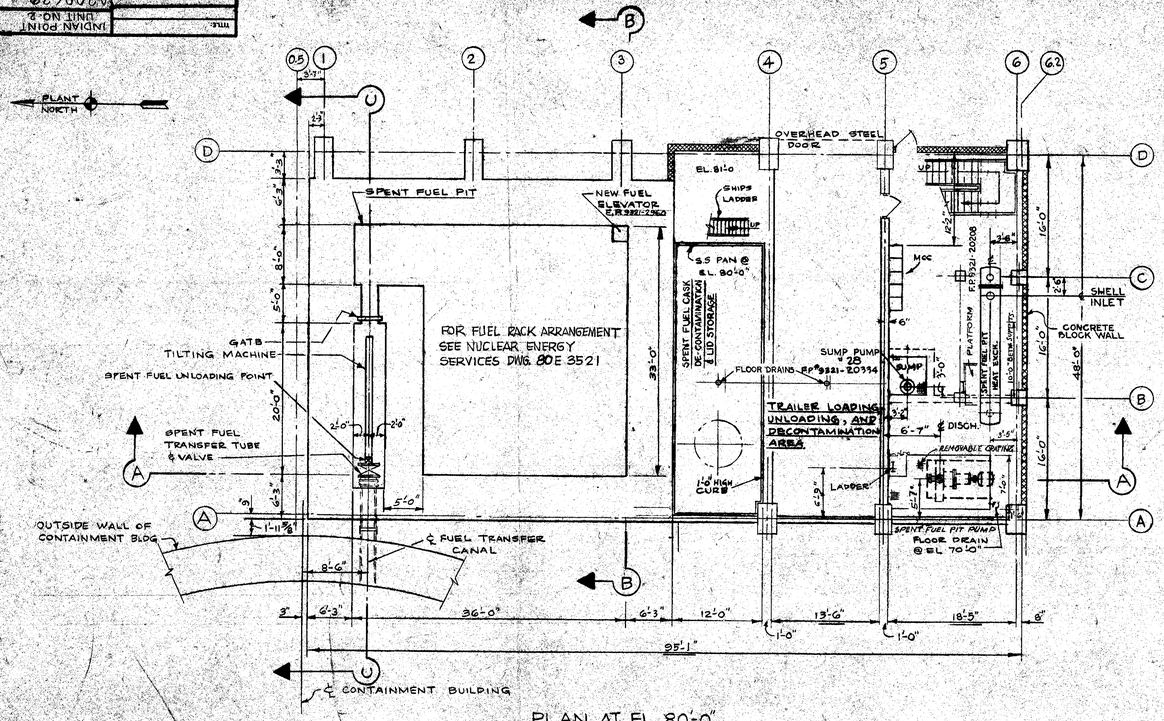

PLAN AT EL. 80'-0"
SCALE - 1/8" = 1'-0"

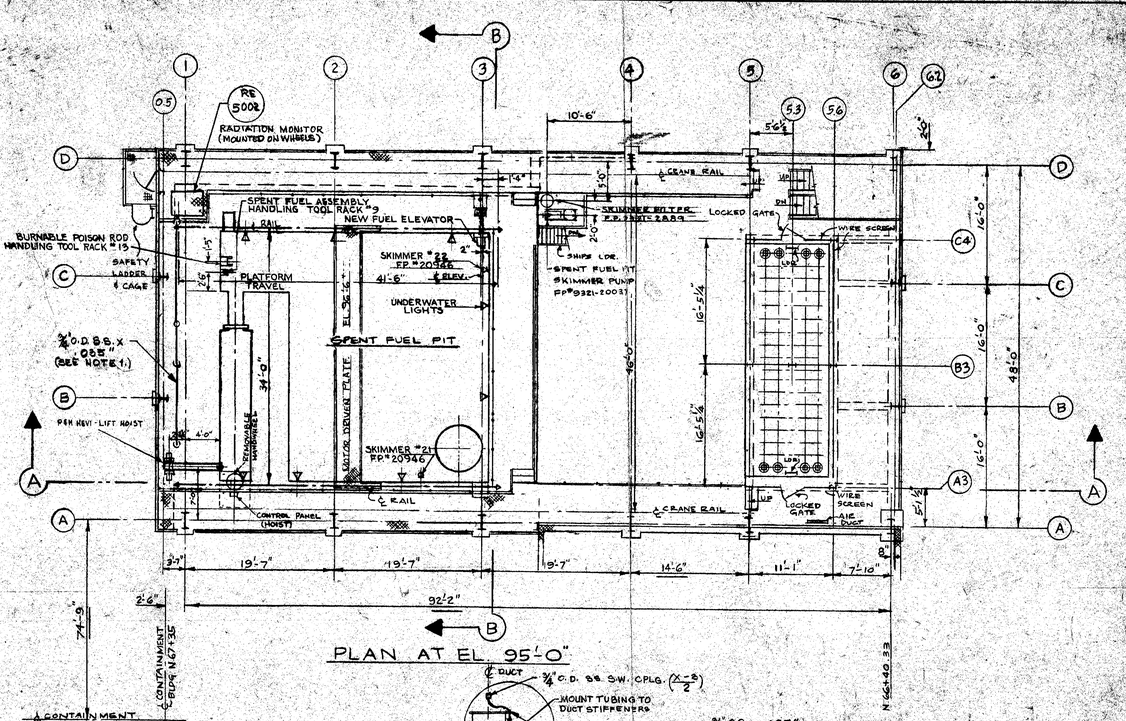

PLAN AT EL. 95'-0"

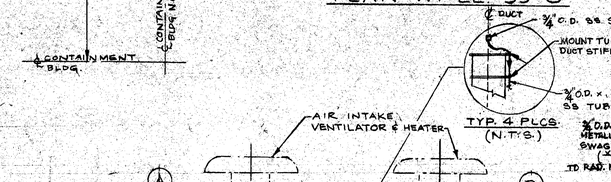

ELEVATION @ SECTION "B-B"

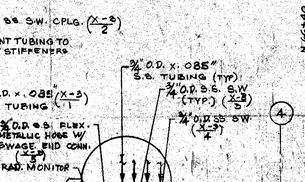

ENLARGED VIEW

ELEVATION @ SECTION "B-B"

SECTION "C-C"

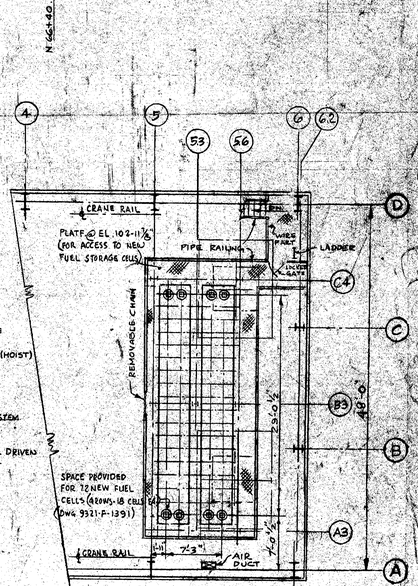

PLAN
(SHOWING PLATFORM @ EL. 102-11 7/8")

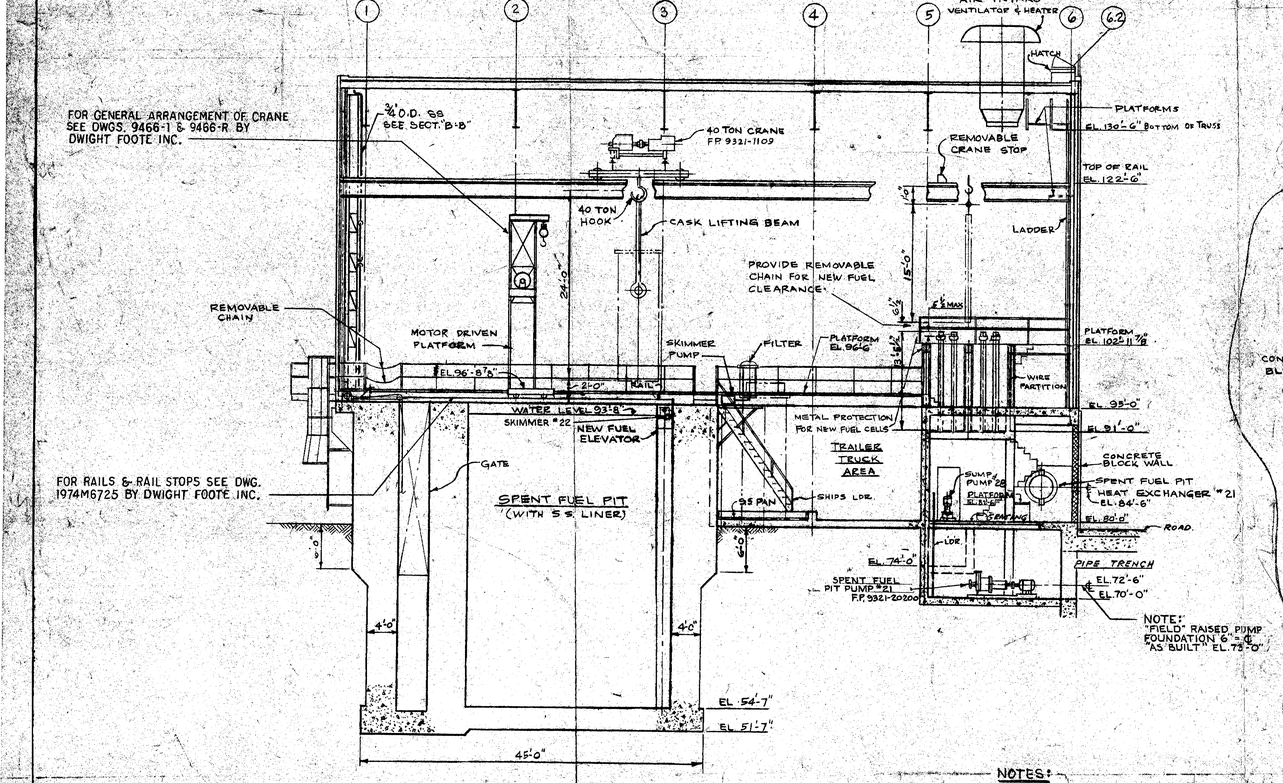

ELEVATION @ SECTION "A-A"

NOTES:

(X-1/1) 'X' - INDICATES MATERIAL LIST. MM 2160827
NO. ABOVE LINE INDICATES "SECTION"
NO. BELOW LINE INDICATES "ITEM"

1. ALL TUBING RUNS TO NEW RE-5002 RADIATION MONITOR MUST BE EQUAL IN LENGTH TO DRAW EQUAL SAMPLES FROM EACH DUCT INLET

REFERENCE DRAWINGS

9321-F-2502 GEN. ARRGT., CONTAINMENT BLDG., PLAN "D-D"
9321-F-1002 PLOT PLAN
9321-F-158 NEW FUEL RACKS
9321-F-2715 FUEL TRANSFER TUBE

REVISIONS				
MICRO FILM	NO.	DATE	DESCRIPTION	BY
(M)	8	10/31/88	FINAL ISSUE	DHR
(M)	7	10/6/88	REVISED SUMP PUMP NO.	DHR
(M)	6	10/4/88	ADDED & RELOCATED TOOL RACKS	DHR
	5	9/19/88	GENERAL REVISIONS	DHR
	4	9/8/88	ADDED SUMP PUMP #2B & ELEV. 80'-0" S SECTION A-A	DHR
(M)	3	10/7/87	GENERAL REVISIONS	DHR
(M)	2	11/5/87	GENERAL REVISION PER CONTAINMENT BLDG. ADDENDUM NO. 1 FOR CONSTRUCTION	DHR
	1	7/10/87	GENERAL REVISION	DHR
	0	1/7/87	FIRST ISSUE	DHR
	NO.	DATE	DESCRIPTION	CHK

ENGINEER
STATE REG.

SEE REV-BOX ABOVE

SCALE - 1/8" = 1'-0"

9002140273 #3

WESTINGHOUSE ELECTRIC CORPORATION
FUEL STORAGE BUILDING
GENERAL ARRANGEMENT
PLANS & ELEVATIONS
FOR
CONSOLIDATED EDISON COMPANY
INDIAN POINT GENERATING STATION
UNIT NO. 2

T.V.A. DRAWING	NUCLEAR POWER GROUP DRAWING
13A725M12	A 200629

SI APERTURE CARD

THIS DRAWING CONTAINS "CLASS A" ITEMS AS DEFINED BY CORPORATE INSTRUCTION CI-240-1

Docket # 50-247
Control # 9002080340
Date 11/4/90 of Document
REGULATORY DOCKET FILE

REVISIONS				
MICRO FILM	NO.	DATE	DESCRIPTION	BY
	9	1/28/88	THIS REVISION CONTAINS CLASS "A" ITEMS INCLUDED IN CHANGED DWGS. DOC. TO REFER TO REVISED DWG. NUMBERS FOR ITEMS CONT. IN LIST OF MATS. ON DWGS. AND NO. MADE. 2-2-88 ON M&S. A.R. 2-2-88	
	10	6/6/88	THIS REV CONTAINS WORK CLASS "A" ITEMS PER CI-240-1 ADDED RAD. MON. AIR DUCTS REVISED FOR REFERENCE CONSTRUCTION SPEC. # MP-78-089 A/W L-7475 DACO: M 9/14/88	
	11	10/31/88	THIS REV. IS CLASS "A" PER CI-240-1 FUEL RACKS INSTALLED WITH MOD PROC CPH 15-2-103 REPLACED BY MOD PROC MNP-80-2-101 RELEASE FOR AS CONSTRUCTED PN 4642 AM 6/19/89	M
	12	7/19/89	THIS REVISION IS CLASS "A" PER CI 240-1 ADDED CRANE & RACK REF. NOTES. RELEASE AS CONST. MOD. PROC. NO CPG-83-91261 PN 91261 PKG 3439 7-19-88 JN/BW	M