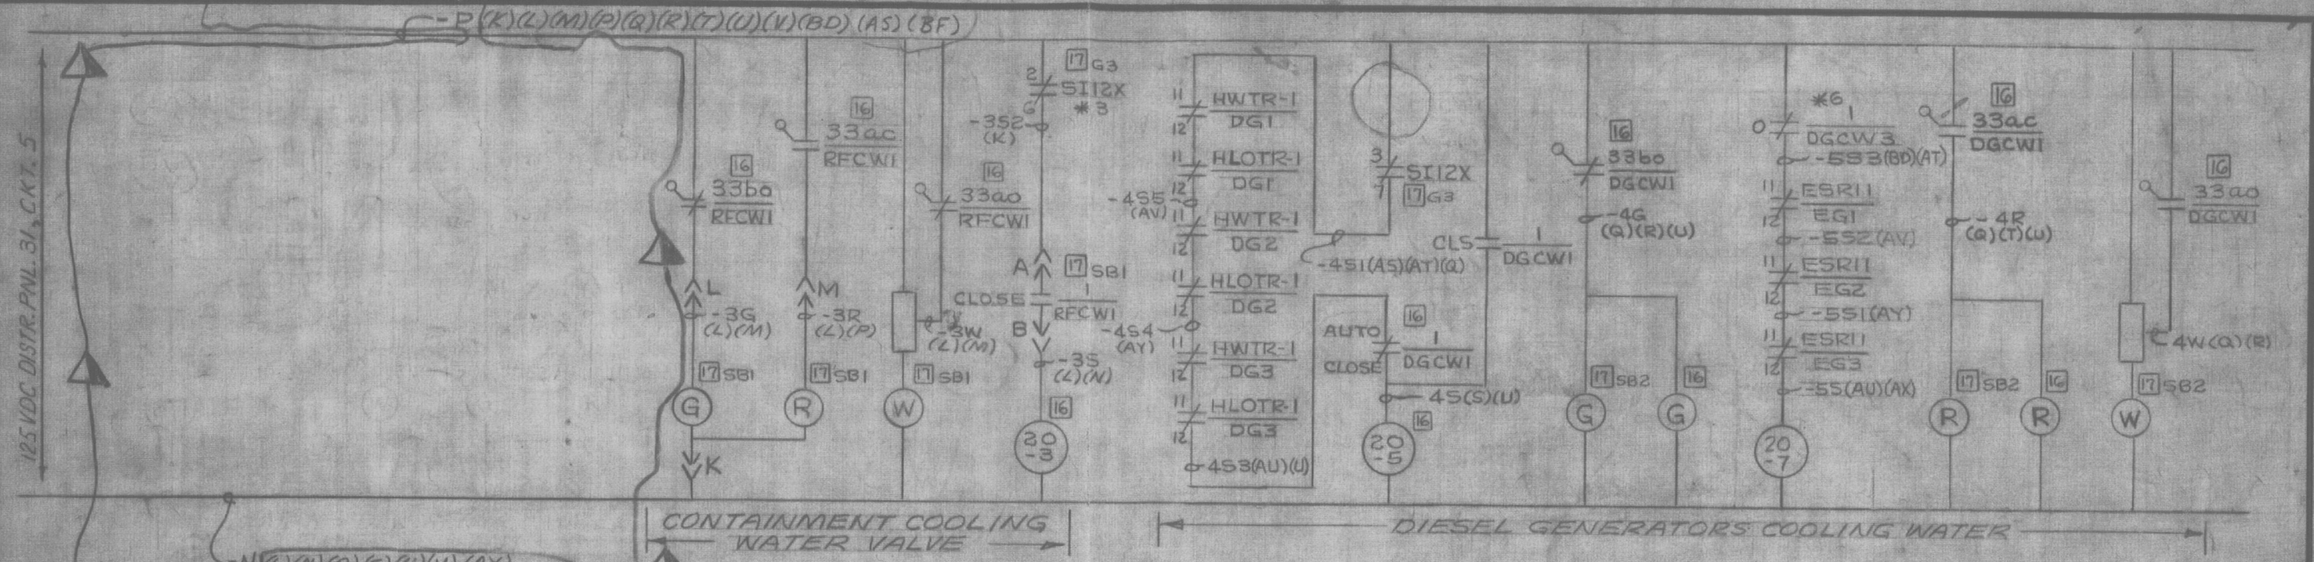

DEVICE	INSTRUMENTATION NUMBER	FUNCTION
20-3	SOV-1170	" " " "
20-5	SOV-1276	" " " "
20-7	SOV-1275	" " " "

NOTES

*1. WIRE DESIGNATIONS ARE TO BE PREFIXED WITH 31DP05-

*2. NUMBERS IN SQUARES REFER TO EQUIPMENT LOCATION. FOR LEGEND SEE SHT. 1.

*3. FOR DEVICE SI12X SEE W DWG 113E303 SHT. 4 (U.E.&C. F.P. 9321-05-3642)

*4. LETTER (A) ETC. REFERS TO CABLE SCHEMATIC 9321-LL-31313, SH. 15B

*5. FOR DEVICE HWTR-1, HLOTR-1 & ESR11 SEE U.E.&C. F.P. 9321-05-3446.

*6. FOR DEVICE 1/DGCW3, SEE 9321-LL-31313, SH. 15A

PER ITEM 1 & 8 OF EUP-367

TYPICAL DEVICE 33

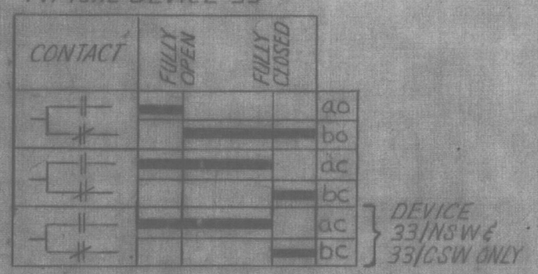

REV. NO.	DATE	DESCRIPTION	ENGR	SUP ENG	W
6	1 17 75	DELETED CONTACT 33bc/DGCW1 PER AS BUILT 681, ADDED CBL LTRS	P.L.P.	WR	
5	2 22 74	REVISED PER ITEM 1 & 8 OF EUP-367	WMCK	WP	
4	9 4 73	33bc CHANGED TO 33bo, REV'D NOTE 6, & ADDED NOTE 7	WMCK	WP	
3	2 16 72	ADD NOTES 5 & 6; CONT'S FOR 1/DGCW3, HWTR-1, HLOTR-1 & ESR11; ADD SOV-1275	JHJ BCH	WR	
2	9 1 71	REV. CABLE DESIG; ADD. PIN MKGS (FOR MODULES) PER W MKD. PRINT	JHJ BCH	WR	
1	2 11 71	REMOVED REF. NOTE TO SH. 9, REMOVED SI21X, CHANGED NOTE 3, ADDED CABLE SCHEM. LTR.	WMCK BCH	WR	
	8 3 70	FIRST ISSUE FOR CONSTRUCTION	JHJ BCH	WR	

ENGINEER William P Robinson

STATE REG. NEW YORK NO. 42453

UNITED ENGINEERS & CONSTRUCTORS INC.

SERVICE WATER CONTROL VALVES

WESTINGHOUSE ELECTRIC CORPORATION
FOR
CONSOLIDATED EDISON COMPANY
INDIAN POINT GENERATING STATION - UNIT NO. 3

SCHEMATIC DIAGRAM
MISC. SOLENOID VALVES

SHEET NO: 15

U.E. & C. DWG. NO.	CON. ED. CO. DWG. NO.
9321-LL-31313	D202367

8111070551

8111070551/14