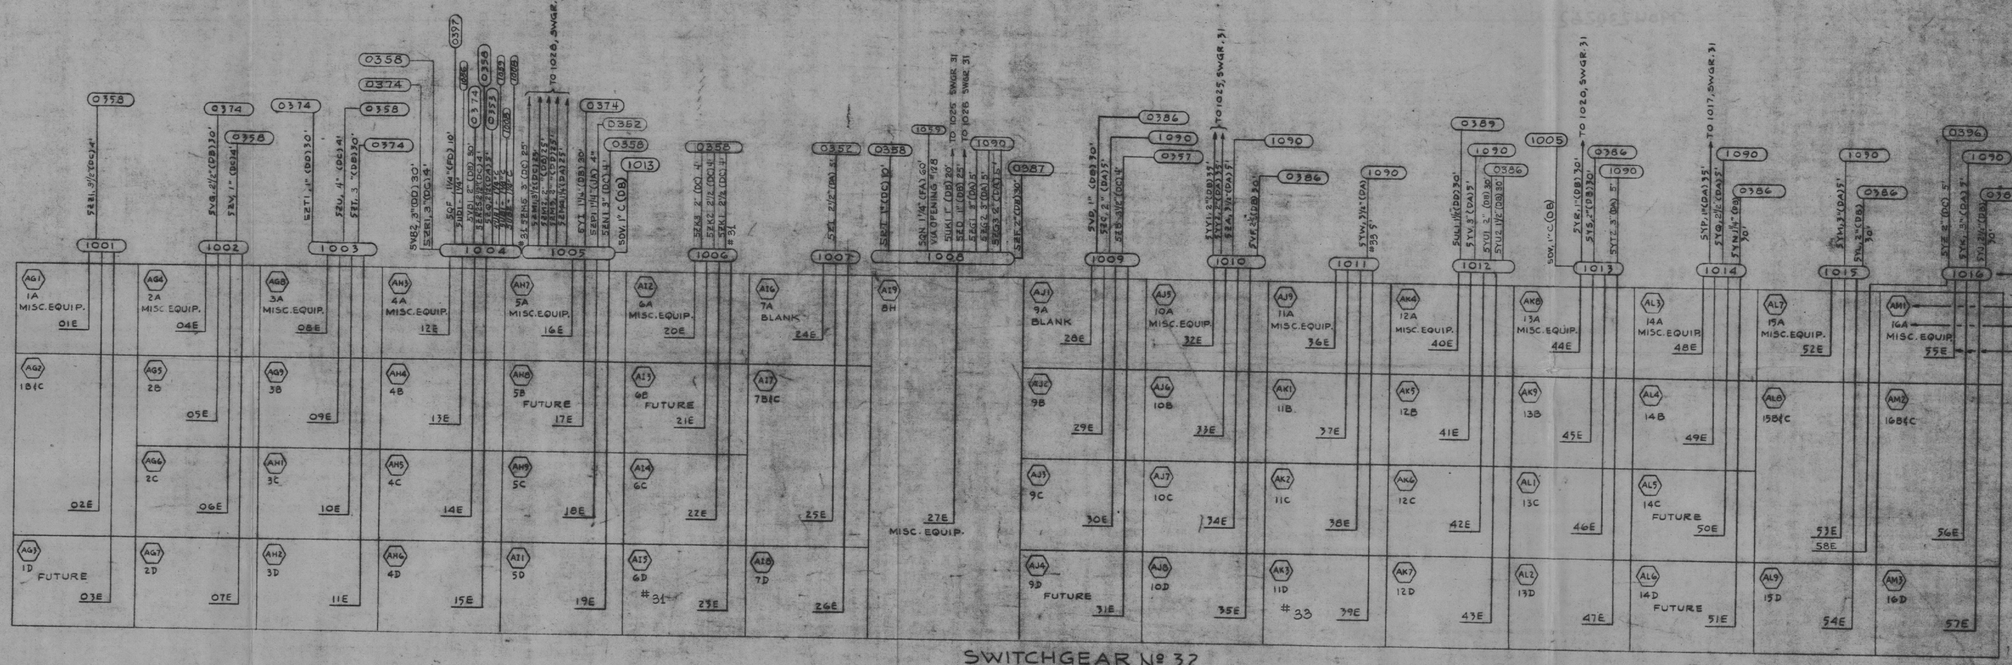

SWITCHGEAR Nº 32
FRONT VIEW, LOOKING NORTH

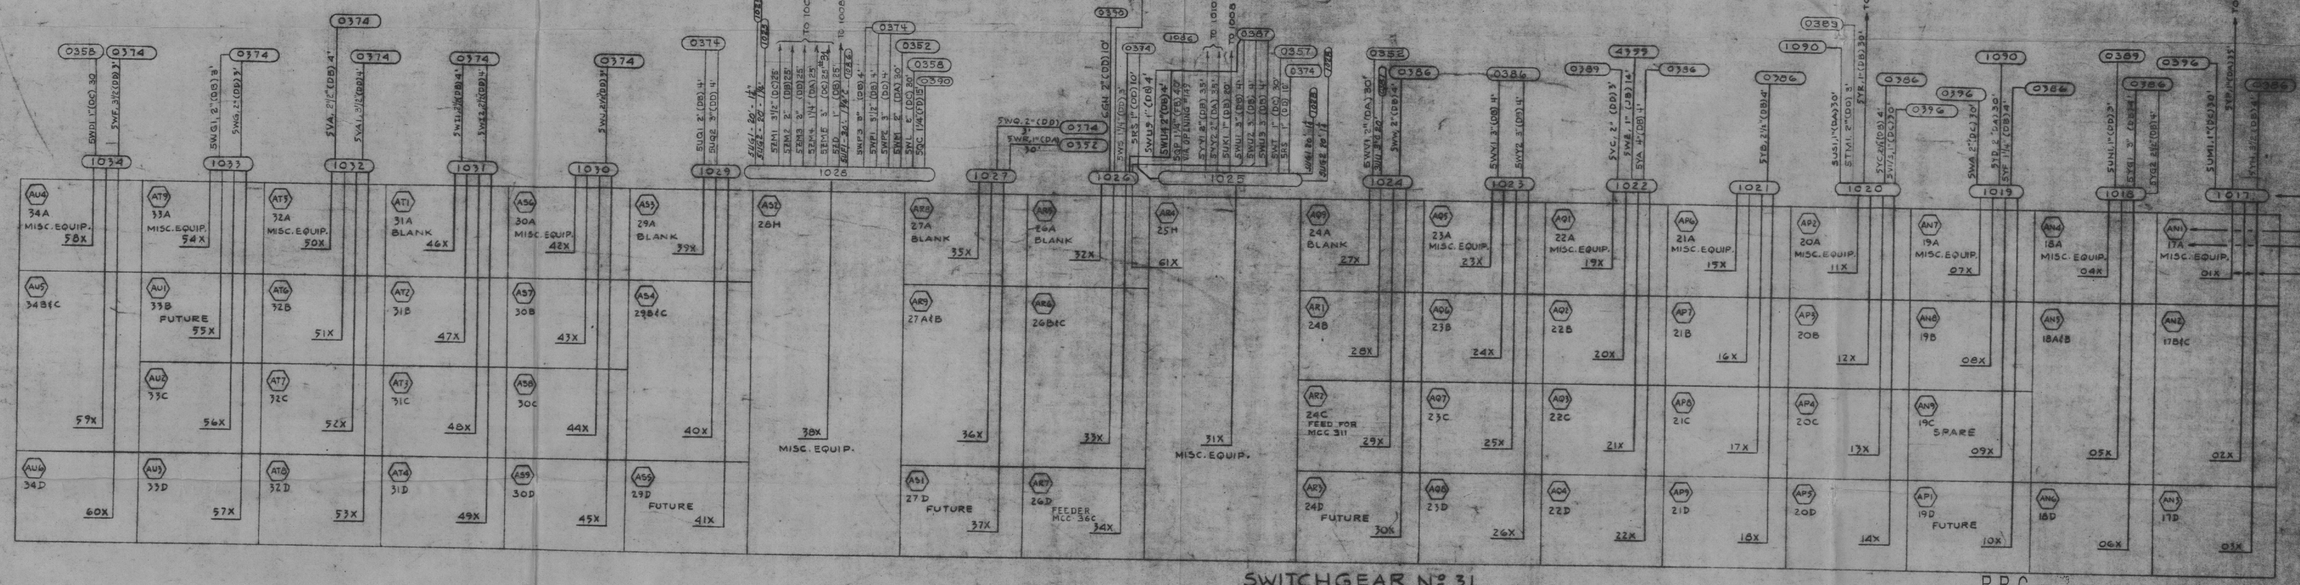

SWITCHGEAR Nº 31
REAR VIEW, LOOKING NORTH

NOTES:
1-THESE FICTITIOUS TRAYS, PHYSICALLY DO NOT EXIST. SEE CONDUIT & CABLE SCHEDULE GENERAL INSTRUCTION TAB "3, PAGE 3.

PRC APERTURE CARD

REFERENCE PLANS
9321-F-31103 CONTROL BLDG. LOCATION OF SLEEVES & OPENINGS, SHT. NO 1.
9321-F-31113 CONTROL BLDG. LOCATION OF SLEEVES & OPENINGS, SHT. NO 2.
9321-F-32913 CONDUIT & TRAY SCHEMATIC CONTROL BUILDING SHT NO 4 (FOR ADDITIONAL CONDUITS)

TERA APERTURE CARD

POOR ORIGINAL

NO.	DATE	DESCRIPTION	ENGR.	SUP. ENG.
8	12-19-72	REVISED AS BUILT & FINAL ISSUE		
7	1-18-72	ADDED FICTITIOUS TRAY IN CONDT. & B.&C.		
6	12-22-71	MARKED 5-SPARE CONDUIT-SYS'S REMOVED "HOLD PER ITEM 1 OF E.I.P.-567"		
5	12-01	DELETED CONDUIT SYS'T"		
4	8-7-72	AT SWGR 323 CYC. FEED MCC 36D(2A) VIA TYCO 500 CM CYC. 3/0 AWG CU. 1.25" C.S. VOLUME (1) CA-A5MS 3of3 (2) AT SWGR 31 MCC 36D(2A) SYS. & SWG 2-D		
3	6-15-72	GEN. REVISION OF CONDUITS		
2	3-21-72	GEN. REVISION OF CONDUITS		
1	2-28-72	GEN. REVISION OF CONDUITS		
0	2-8-72	FIRST ISSUE FOR CONSTRUCTION		

ENGINEER
STATE REG. No. 40253
UNITED ENGINEERS & CONSTRUCTORS INC.

AUX FEEDWATER PUMPS #31 & #33

WESTINGHOUSE ELECTRIC CORPORATION
CONDUIT CONNECTION SCHEMATIC
CONTROL CONDUITS FOR 480V. SWITCHGEAR
FOR
CONSOLIDATED EDISON COMPANY
INDIAN POINT GENERATI...
UNIT NO. 3

U.E.&C. DWG. NO. 9321-F-32783-3
CON. ED. CO. DWG. NO. A202731

8111030160