DRAWING NUMBER

DRAWING NUMBER

DRAWING NUMBER

DRAWING NUMBER

DRAWING NUMBER
U.E.&C.

DRAWING NUMBER
9321-F-27003

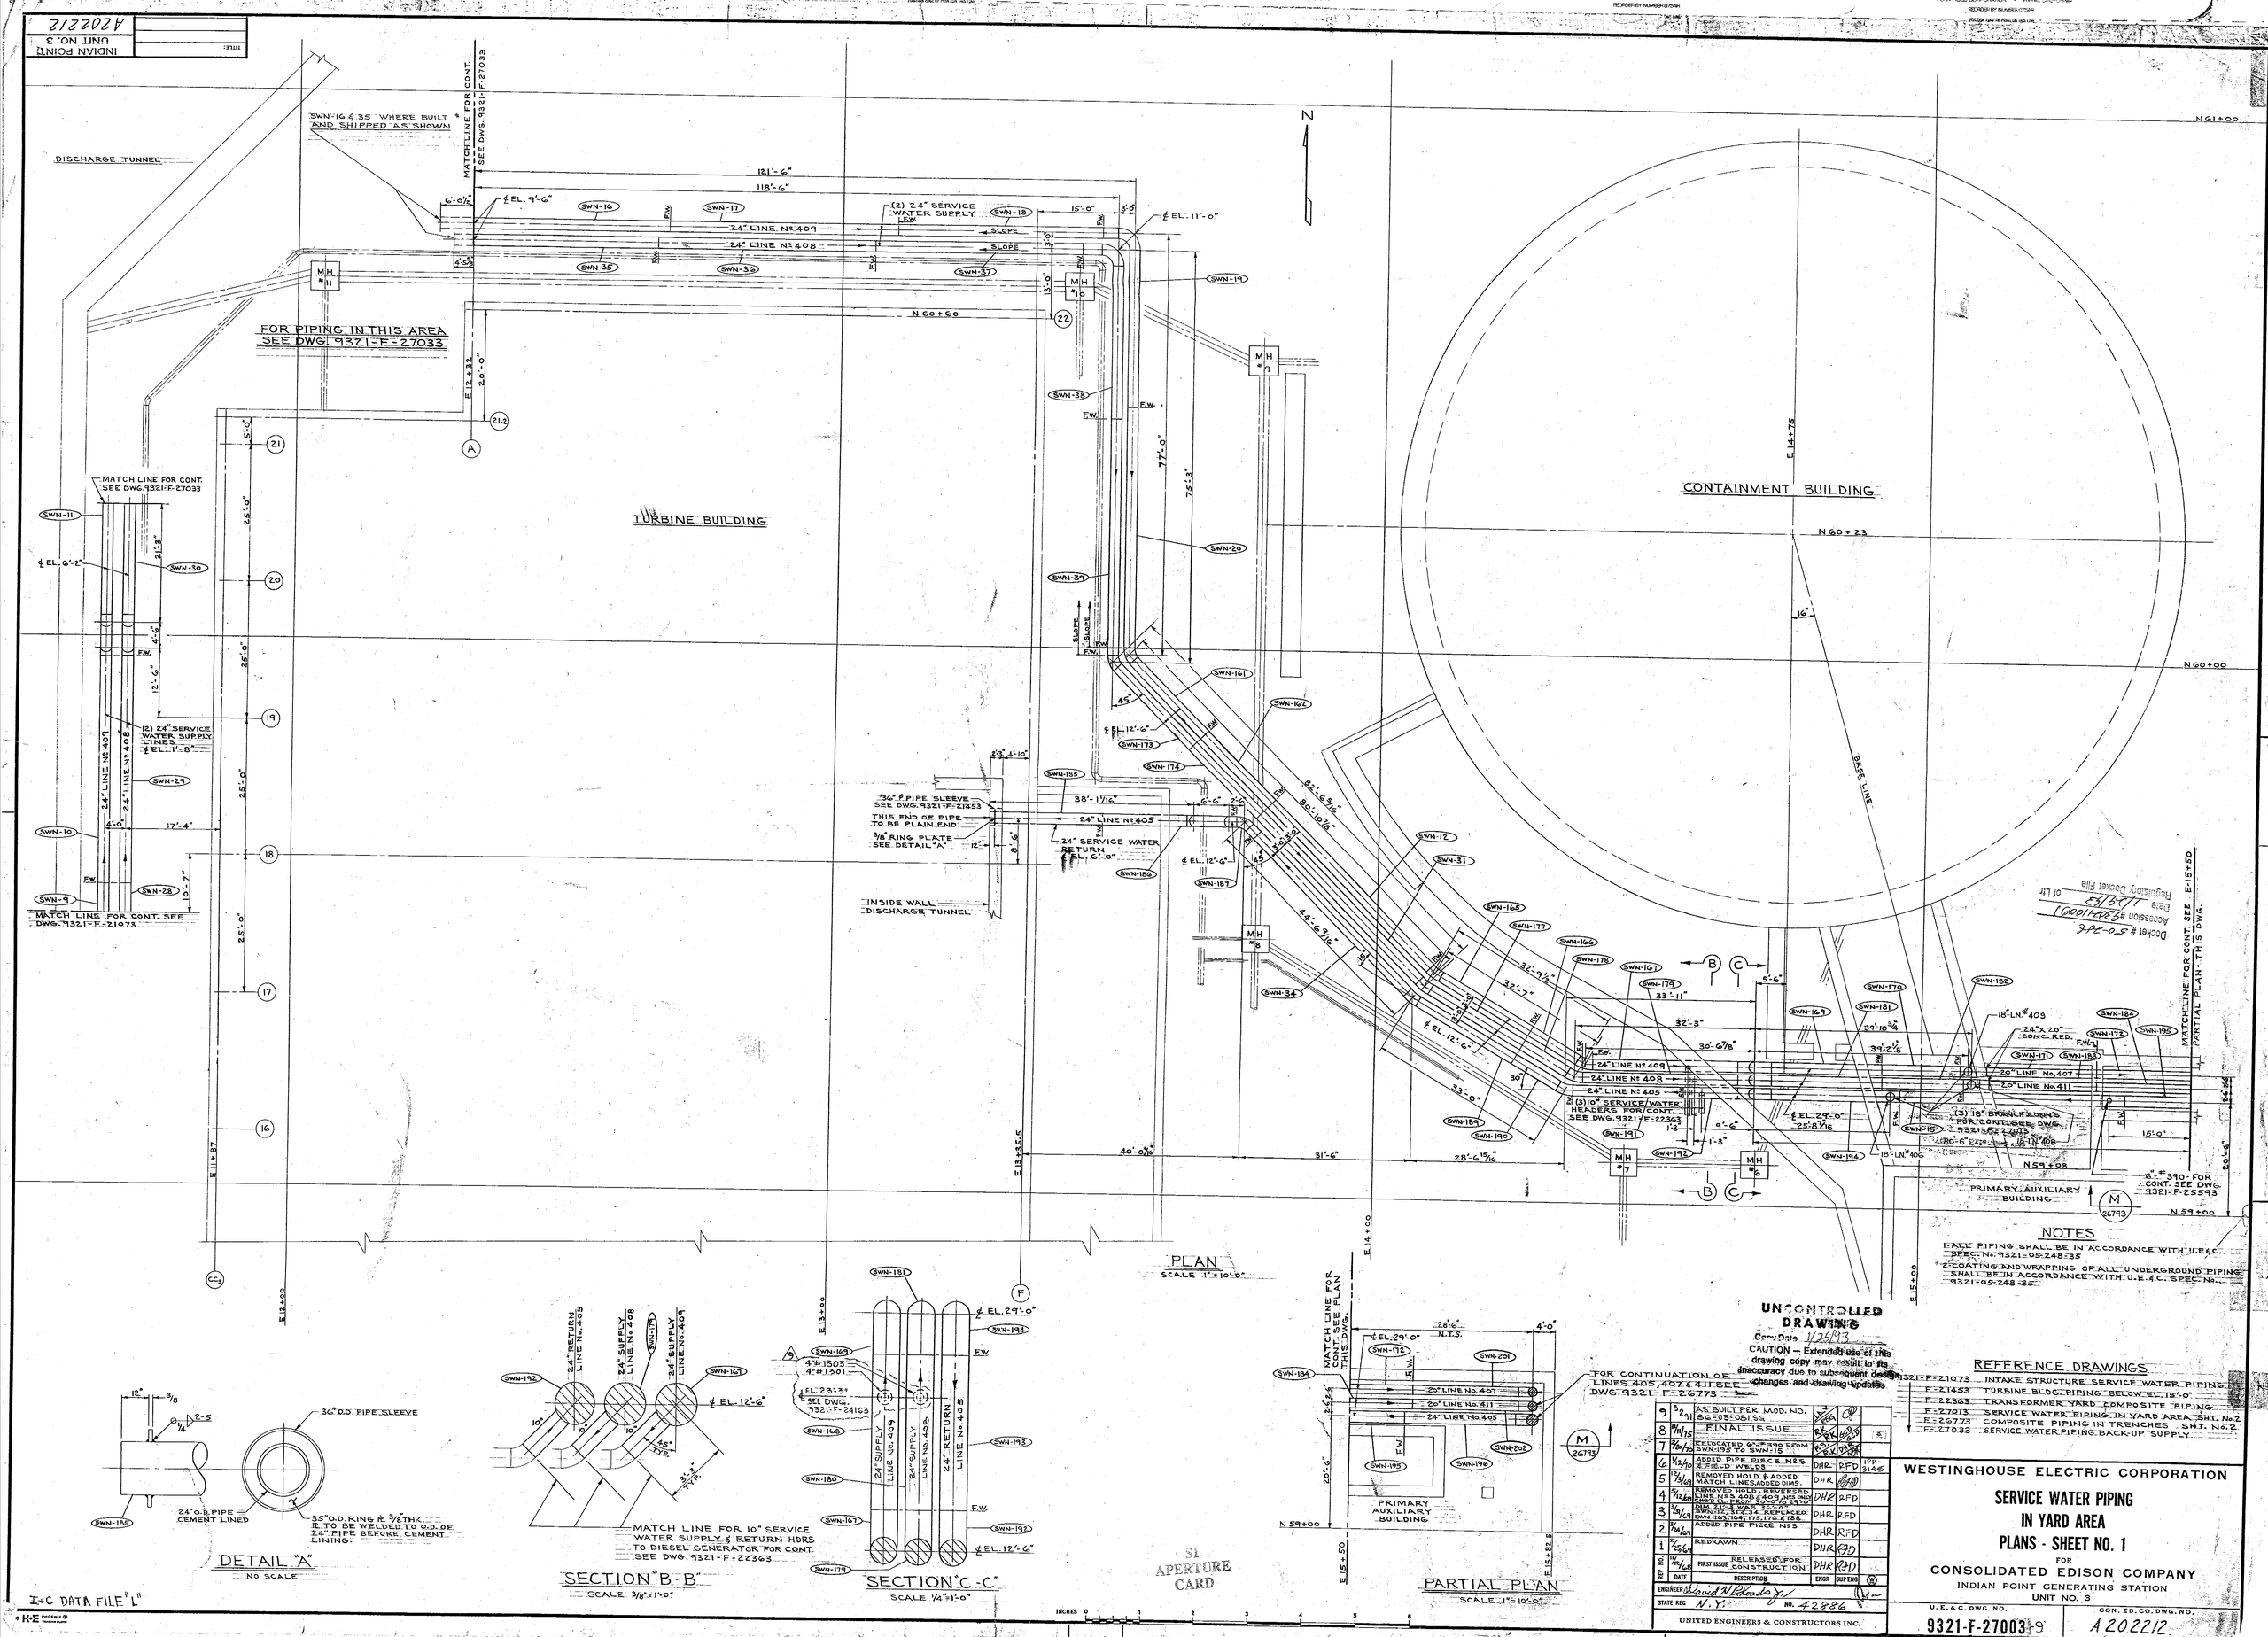

NOTES

1. ALL PIPING SHALL BE IN ACCORDANCE WITH U.E.&C. SPEC. No. 9321-05-248-35
2. COATING AND WRAPPING OF ALL UNDERGROUND PIPING SHALL BE IN ACCORDANCE WITH U.E.&C. SPEC. No. 9321-05-248-35

UNCONTROLLED DRAWING
Comp Date 1/26/93
CAUTION – Extended use of this drawing copy may result in its inaccuracy due to subsequent design changes and drawing updates

REFERENCE DRAWINGS

9321-F-21073	INTAKE STRUCTURE SERVICE WATER PIPING
F-21453	TURBINE BLDG. PIPING BELOW EL. 15'-0"
F-22363	TRANSFORMER YARD COMPOSITE PIPING
F-27013	SERVICE WATER PIPING IN YARD AREA SHT. No. 2
F-26773	COMPOSITE PIPING IN TRENCHES SHT. No. 2
F-27033	SERVICE WATER PIPING BACKUP SUPPLY

REV. NO.	DATE	DESCRIPTION	ENGR	SUP ENG	M
9	2/21	AS BUILT PER MOD. NO. E&C-03-051 SG			
8	1/11/95	FINAL ISSUE			
7	1/26/93	RELOCATED 6"-F390 FROM SWN-195 TO SWN-15			
6	1/23/90	ADDED PIPE PIECE N25 & FIELD WELDS	DHR	RFD	IPF-3145
5	3/3/89	REMOVED HOLD & ADDED MATCH LINES, ADDED DIMS.	DHR		
4	5/11/88	REMOVED HOLD, REVERSED LINES No. 405, 408 & 409, AND SWN-21 FROM 8'-0" TO 25'-0"	DHR	RFD	
3	1/11/83	SWN-15, 31 & 33 REPLACED SWN-152, 164, 175, 176 & 188	DHR	RFD	
2	7/30/80	ADDED PIPE PIECE N25	DHR	RFD	
1	7/25/68	REDRAWN	DHR	RFD	
0	11/21/68	FIRST ISSUE RELEASED FOR CONSTRUCTION	DHR	RFD	

ENGINEER Donald N. Rhodes Jr.
STATE REG. N.Y. NO. 42886

UNITED ENGINEERS & CONSTRUCTORS INC.

WESTINGHOUSE ELECTRIC CORPORATION

SERVICE WATER PIPING IN YARD AREA PLANS - SHEET NO. 1

FOR

CONSOLIDATED EDISON COMPANY

INDIAN POINT GENERATING STATION UNIT NO. 3

U.E.&C. DWG. NO. 9321-F-27003-9

CON. ED. CO. DWG. NO. A 202212

INDIAN POINT UNIT NO. 3 A202212

Docket # 50-247
Accession # 8201100011
Date 1/13/82
Regulatory Docket File

I+C DATA FILE "L"

930217037 8