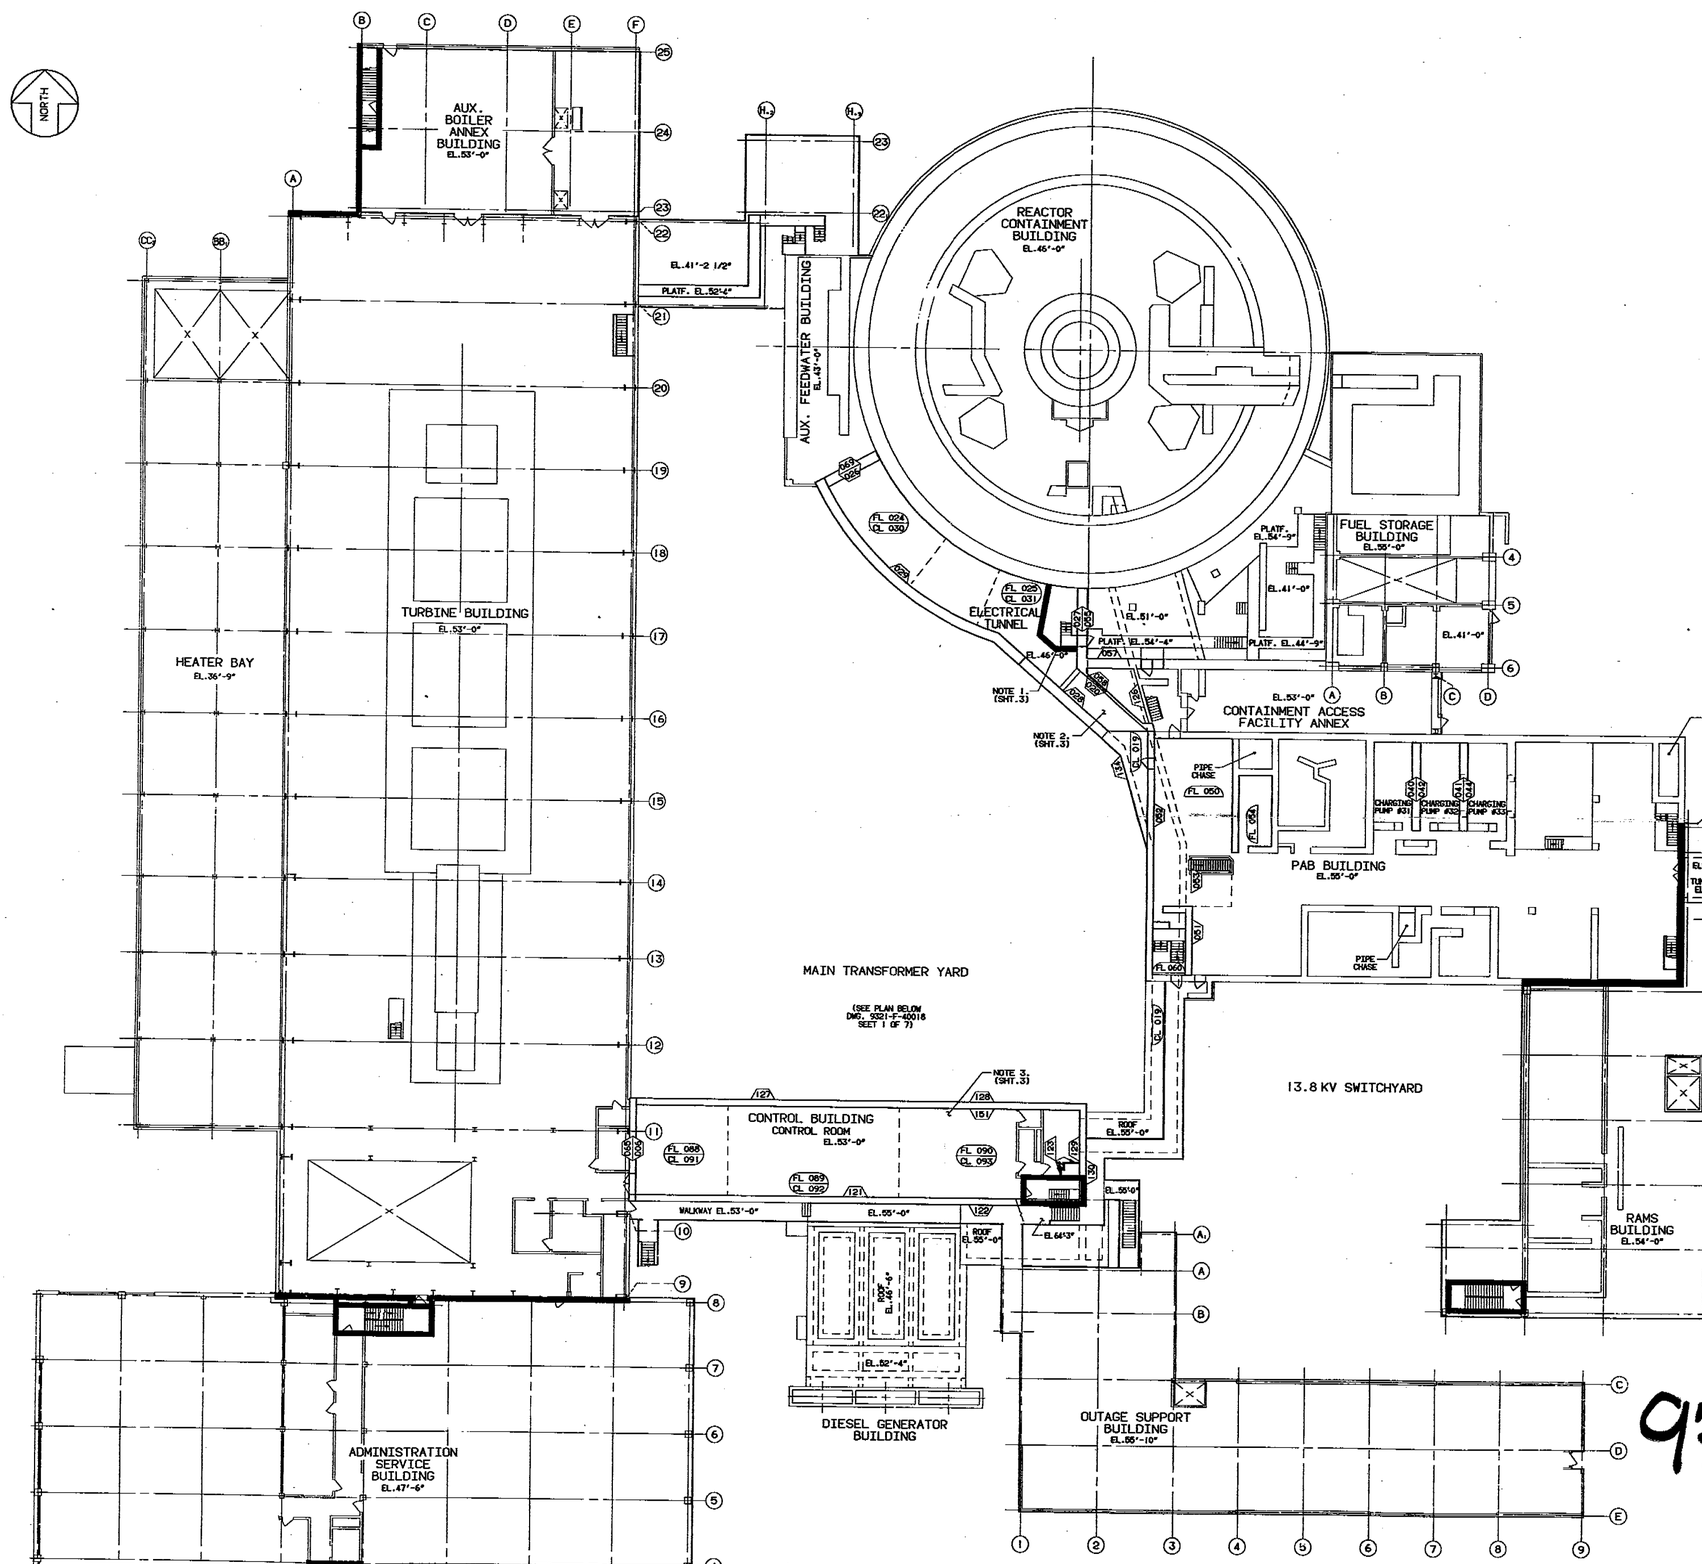

SHT. NO.	FIRE BARRIER CODE NO.
006	CTL3-15-MA-TS
019	ETN4-60A-CA
020	ETN4-60A-EA
024	ETN4-73A-FA
025	ETN4-73A-FB & ETN4-73A-FC
026	ETN4-73A-NA
027	ETN4-73A-SA
028	ETN4-73A-MA
029	ETN4-73A-MC
030	ETN4-74A-CA
031	ETN4-74A-CB & ETN4-74A-CC
040	PAB2-5-EA
041	PAB2-6-EA
042	PAB2-6-MA
044	PAB2-7-MA
050	PAB2-17A-FA
051	PAB2-17A-MA
052	PAB2-17A-MB
053	PAB2-17A-MC
054	PAB2-20A-FA
055	PAB2-59A-NA
057	PAB2-59A-MA
058	PAB2-59A-MB
060	PAB2-63A-FA
065	TBL5-49A-EA-TS
069	TBL5-57A-SA
088	CTL3-15-SA-TS
089	CTL3-15-FB-TS
090	CTL3-15-FC-TS
091	CTL3-11-CA-TS
092	CTL3-11-CB-TS
093	CTL3-11-CC-TS
121	CTL3-15-SA
122	YARD7-YARD-NA
123	CTL3-15-SB
126	PAB2-59A-EA
127	YARD7-66A-SA
128	YARD7-65A-SA
129	CTL3-15-EA
130	YARD7-YARD-MA
134	YARD7-YARD-EB
151	CTL3-15-NA

ANSTEC APERTURE CARD

UNCONTROLLED DRAWING

Copy Date 11-6-96

CAUTION — Extended use of this drawing copy may result in its inaccuracy due to subsequent design changes and drawing updates

97010970153

NOT NUCLEAR SAFETY RELATED

REV NO	DATE	DESCRIPTION	DWN	DES	DWG CHK	DES CH	PROJ APPD.
1	5/16/96	ORIG. ISSUE-AS BUILT PER DCR 100118281	DM	[illegible]	[illegible]	[illegible]	[illegible]

REVISIONS

DWN | CHK'D
DES SUPV
DISCIPLINE ENG
DISCIPLINE MGR.
PROJ APPROVAL
DATE

INDIAN POINT NO.3 NUCLEAR POWER PLANT

FIRE BARRIER PENETRATION WALLS LOCATION SITEMAP PLANS EL.51'-0", 53'-0", 54'-0" & 55'-0"

New York Power Authority

SCALE: 1/16"=1'-0"

DWG NO 9321-F-40018 SHEET 4 OF 7 | REV 1

97010970153