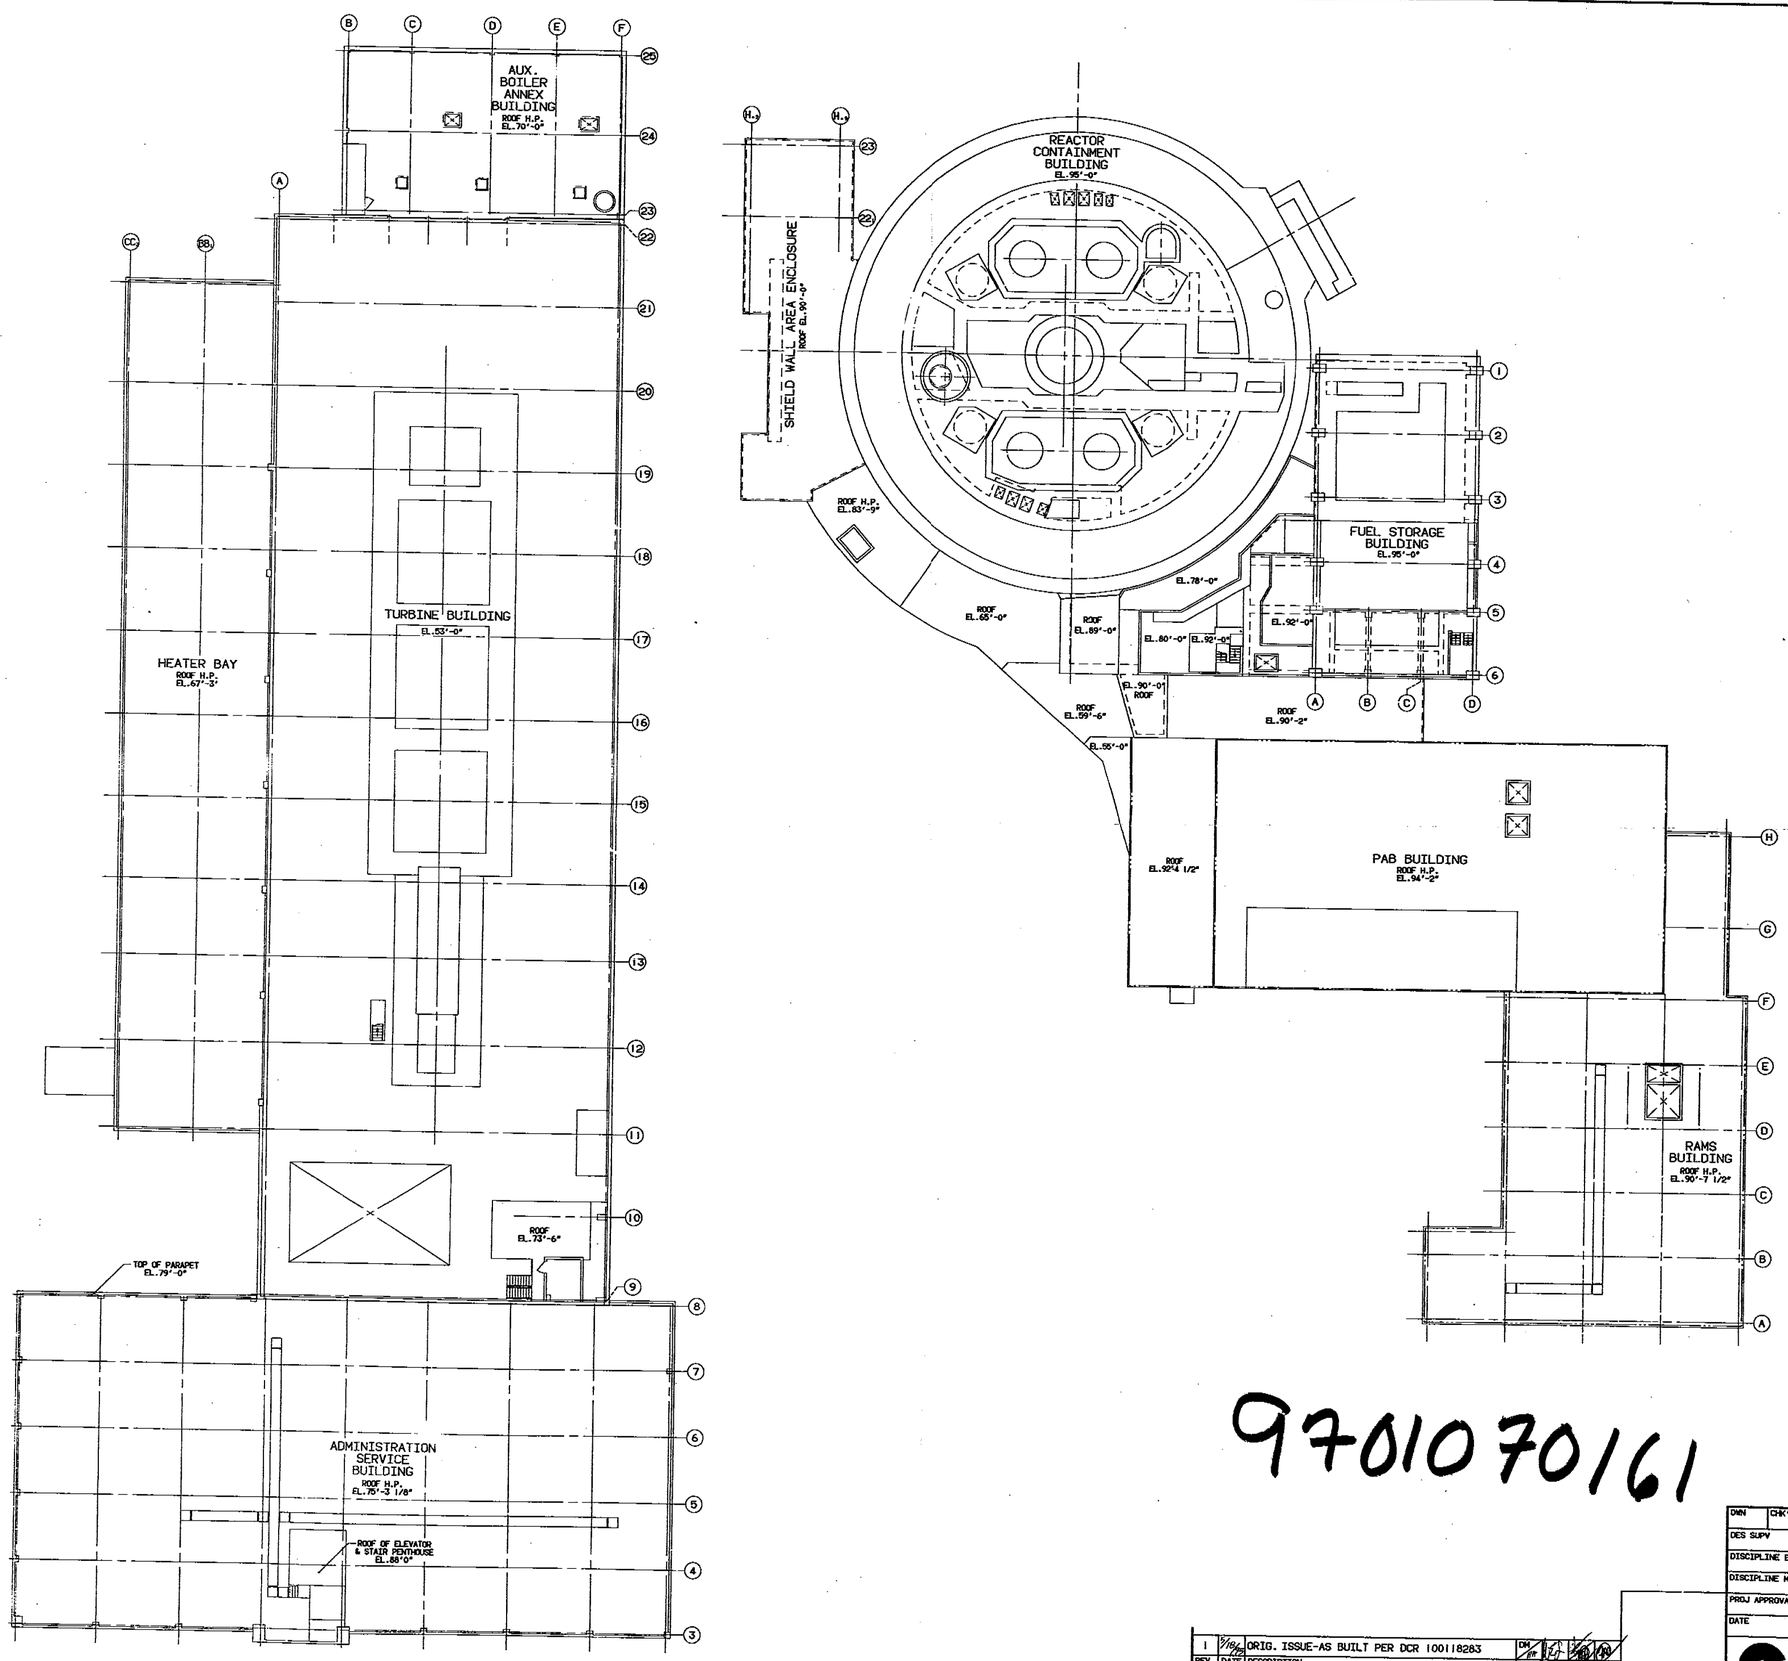

AMSTEC APERTURE CARD

UNCONTROLLED DRAWING
Copy Date 11-6-96
CAUTION — Extended use of this drawing copy may result in inaccuracy due to subsequent changes and drawing updates

9701070161

NOT NUCLEAR SAFETY RELATED

REV NO	DATE	DESCRIPTION	DWN	CHK	DS	DH	PROJ APP.
1	7/18/96	ORIG. ISSUE-AS BUILT PER DCR 100118283	DM				

REVISIONS

DWN / CHK'D	INDIAN POINT NO.3 NUCLEAR POWER PLANT
DES SUPV	
DISCIPLINE ENG	FIRE BARRIER PENETRATION WALLS LOCATION SITEMAP PLANS EL.95'-0"
DISCIPLINE MGR.	
PROJ APPROVAL	
DATE	

New York Power Authority

SCALE: 1/16"=1'-0"
DWG NO 9321-F-40018 REV 1
SHEET 6 OF 7

9701070161