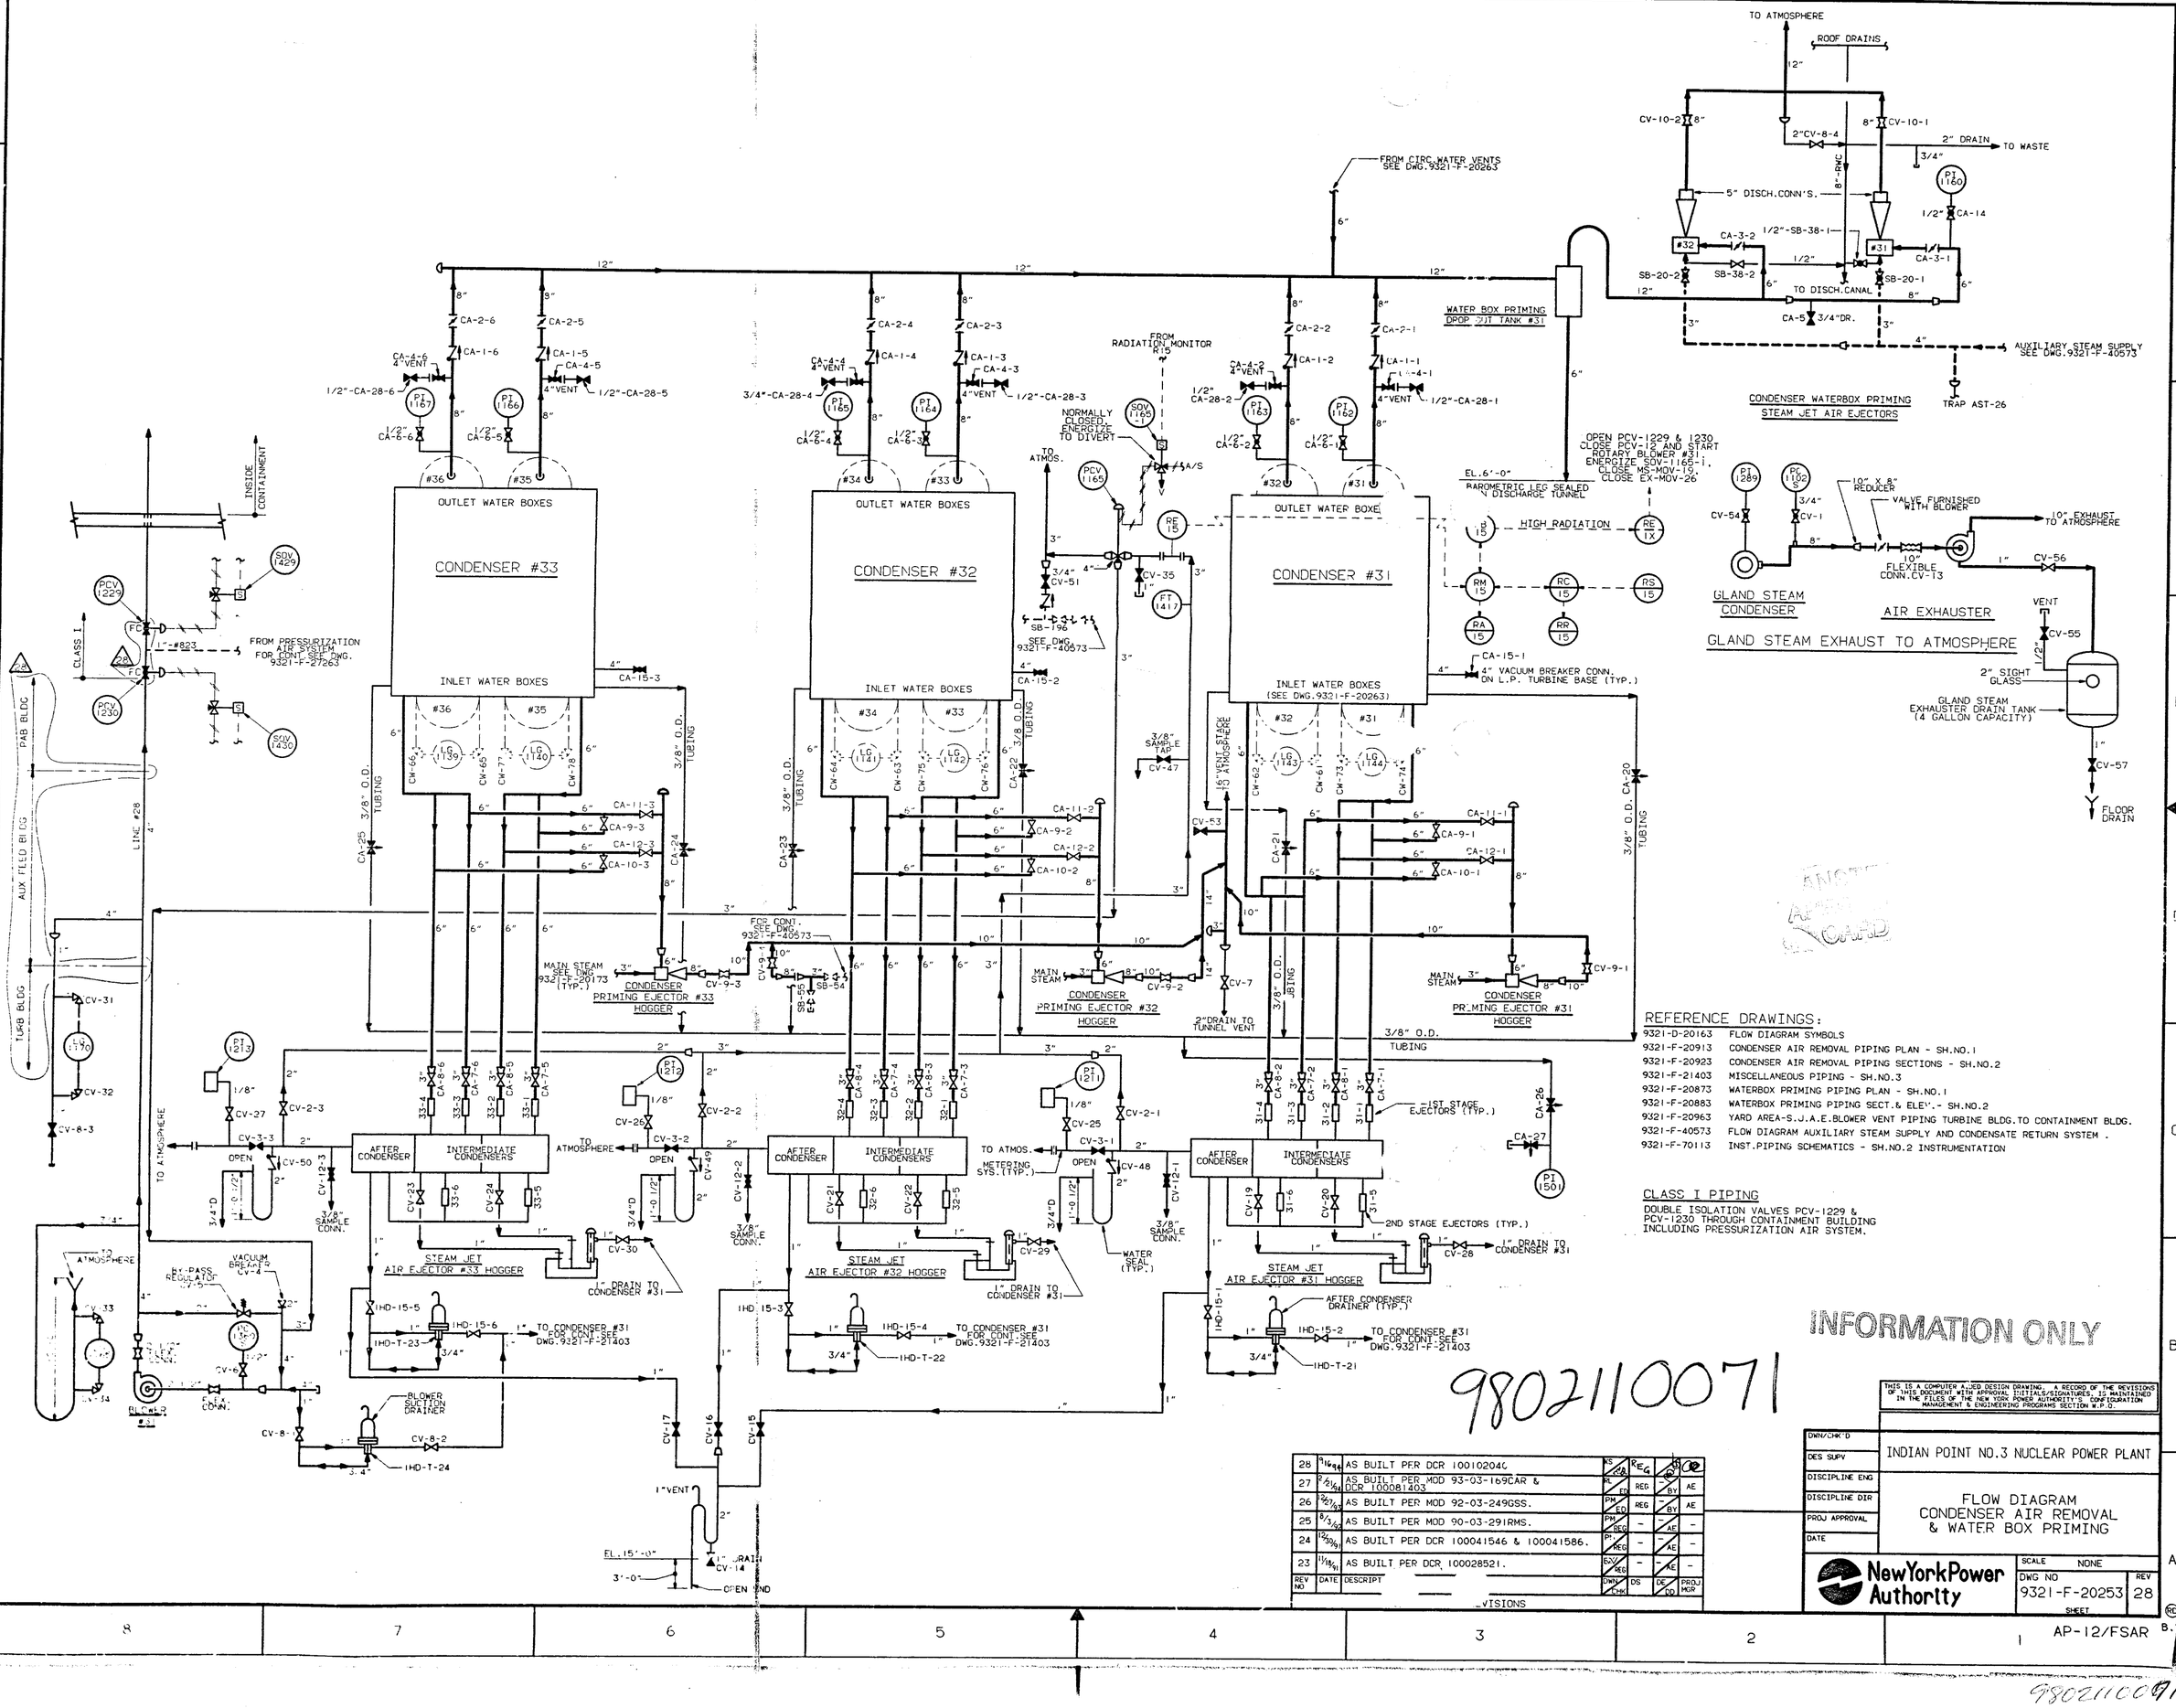

REFERENCE DRAWINGS:

9321-D-20163	FLOW DIAGRAM SYMBOLS
9321-F-20913	CONDENSER AIR REMOVAL PIPING PLAN - SH.NO.1
9321-F-20923	CONDENSER AIR REMOVAL PIPING SECTIONS - SH.NO.2
9321-F-21403	MISCELLANEOUS PIPING - SH.NO.3
9321-F-20873	WATERBOX PRIMING PIPING PLAN - SH.NO.1
9321-F-20883	WATERBOX PRIMING PIPING SECT.& ELEV.- SH.NO.2
9321-F-20963	YARD AREA-S.J.A.E.BLOWER VENT PIPING TURBINE BLDG.TO CONTAINMENT BLDG.
9321-F-40573	FLOW DIAGRAM AUXILIARY STEAM SUPPLY AND CONDENSATE RETURN SYSTEM .
9321-F-70113	INST.PIPING SCHEMATICS - SH.NO.2 INSTRUMENTATION

CLASS I PIPING

DOUBLE ISOLATION VALVES PCV-1229 & PCV-1230 THROUGH CONTAINMENT BUILDING INCLUDING PRESSURIZATION AIR SYSTEM.

INFORMATION ONLY

9802110071

REV NO	DATE	DESCRIPT	DWN/CHK	DS	DE/DD	PROJ MGR
28	9/16/94	AS BUILT PER DCR 100102040	KS/CB	REG	KL/CB	AE
27	2/21/91	AS BUILT PER MOD 93-03-169CAR & DCR 100081403	KL/ED	REG	BY	AE
26	2/20/92	AS BUILT PER MOD 92-03-249GSS.	PM/ED	REG	BY	AE
25	6/3/92	AS BUILT PER MOD 90-03-291RMS.	PM/REG	-	-	AE
24	12/30/91	AS BUILT PER DCR 100041546 & 100041586.	PM/REG	-	-	AE
23	11/15/91	AS BUILT PER DCR 100028521.	GW/REG	-	-	AE

REVISIONS

THIS IS A COMPUTER AIDED DESIGN DRAWING. A RECORD OF THE REVISIONS OF THIS DOCUMENT WITH APPROVAL INITIALS/SIGNATURES, IS MAINTAINED IN THE FILES OF THE NEW YORK POWER AUTHORITY'S CONFIGURATION MANAGEMENT & ENGINEERING PROGRAMS SECTION W.P.O.

DWN/CHK'D	
DES SUPV	
DISCIPLINE ENG	
DISCIPLINE DIR	
PROJ APPROVAL	
DATE	

INDIAN POINT NO.3 NUCLEAR POWER PLANT

FLOW DIAGRAM
CONDENSER AIR REMOVAL
& WATER BOX PRIMING

New York Power Authority

SCALE NONE

DWG NO 9321-F-20253

REV 28

SHEET

AP-12/FSAR

9802110071