


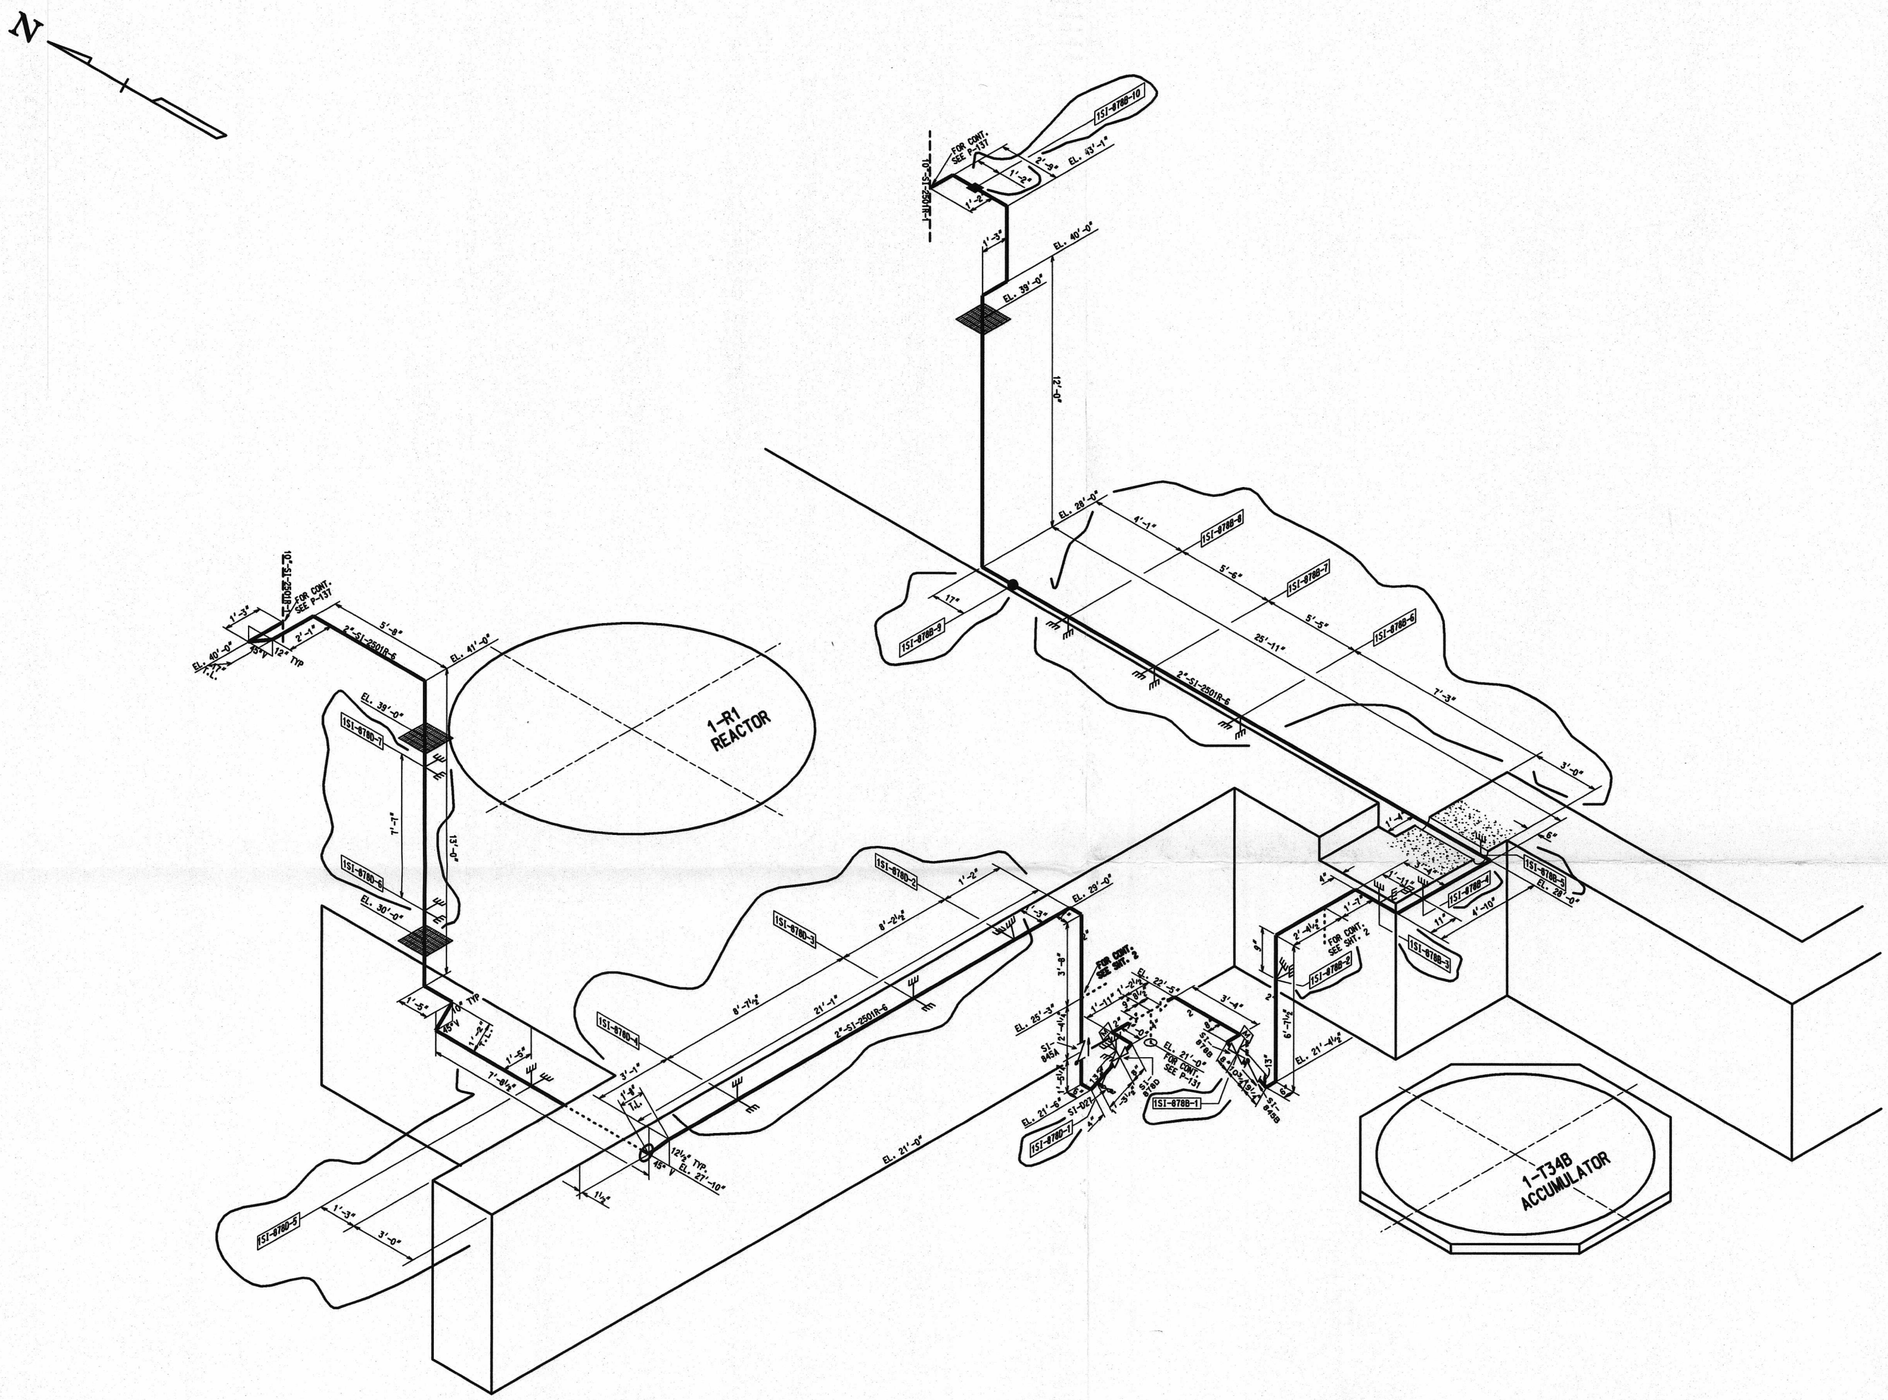


NOTES:
1. 1 FOR "OPERATING" AND "DESIGN" TEMPERATURES & PRESSURES, AND ANALYSIS & VALVE INFORMATION, SEE ACCESSION REPORT 100096.
2. 1 ALL ELEVATIONS ARE TO BE USED AS REFERENCE ONLY.

LEGEND
- RIGID GRAVITY RESTRAINT
- SPRING HANGER (C=CONSTANT, V=VARIABLE)
- ANCHOR
- GUIDE
- RESTRAINT
- SNUBBER

AS-BUILT PER IEB-79-14 RECONCILIATION PROGRAM.

VENDOR : WE
T.F.I. T2.4
MOD. REQ. : NONE

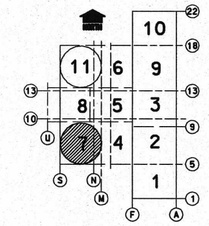© We Energies 2002

D-01

REFERENCE DRAWINGS

| REV NO. | DATE | REVISION DESCRIPTION | ACT | DRAWN | CHK'D | APPR'D |
|---|---|---|---|---|---|---|
| 01 | 07-27-02 | REVISED PER DCN # 2001-3113 | 2065 | KJB1 | BER | BER |
| 00 | 01-26-96 | INCORP INTO PDS PER MEMO NEES-96-0049 | 4294 | EMM | JRB | BAH |

LEVEL USAGE 1 2 3 4 5 7 — 62 63

CGS REF FILES

MICROFILM NO. 300305

| | | |
|---|---|---|
| DRAWN | RLB 4-27-95 | PROJECT NO. 19323 |
| CHECKED | DES 1-4-96 | ACTIVITY NO. 4947 |
| APPROVED | BAH 1-17-96 | SCALE NONE |

CGS NO. 50164

we energies

PIPING ISOMETRIC
2" SAFETY INJECTION (SI) PIPING
IN CONTAINMENT
PBA-1140 SH.1
POINT BEACH N.P. UNIT 1

E PB 01 MS I L 1 8 3 0 4 2 0 1

03-15-96