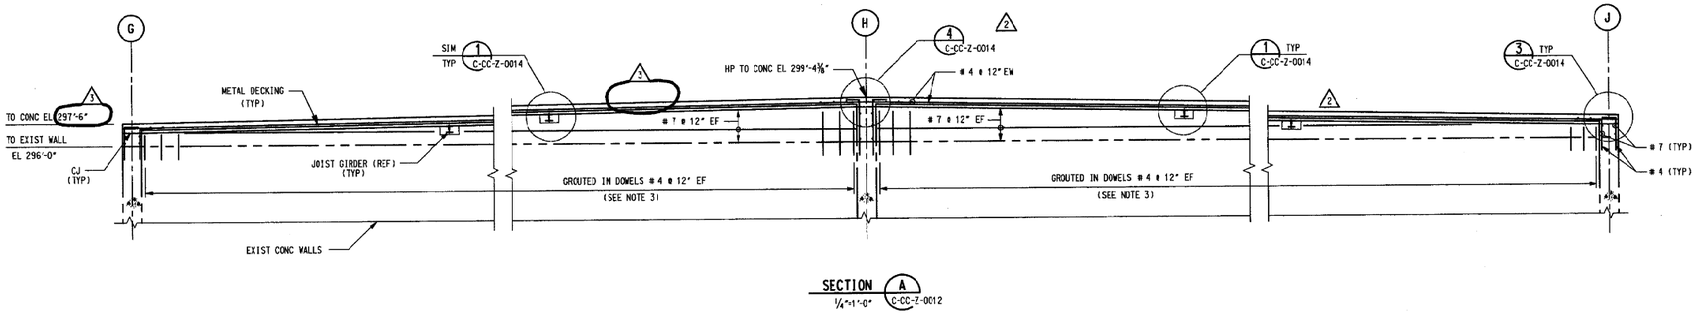

SECTION A (C-CC-Z-0012)
1/4"=1'-0"

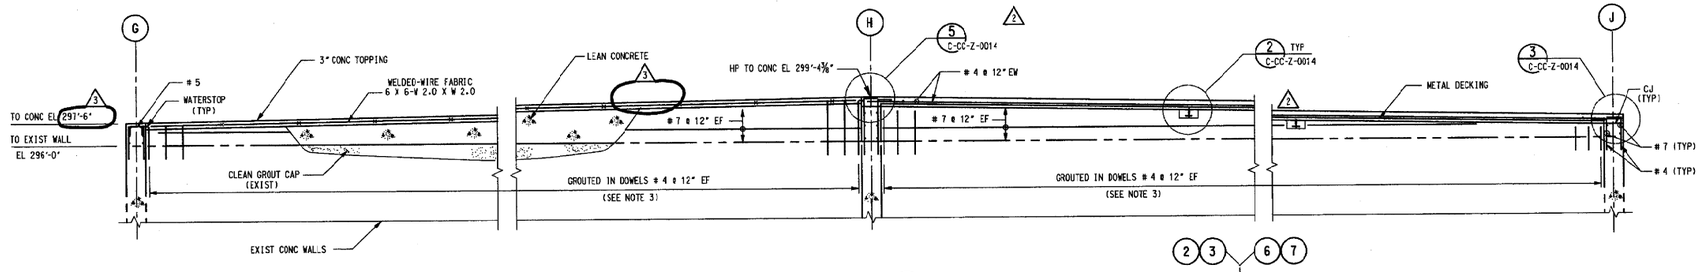

SECTION B (C-CC-Z-0012)
1/4"=1'-0"

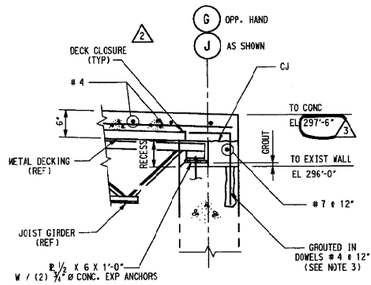

SECTION C (C-CC-Z-0012)
NTS

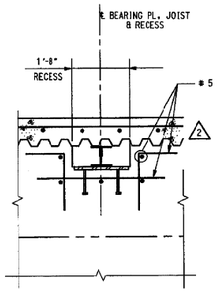

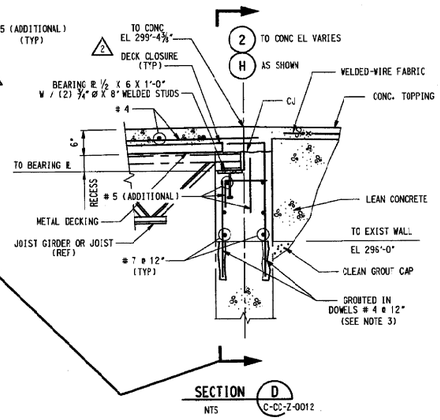

SECTION D (C-CC-Z-0012)
NTS

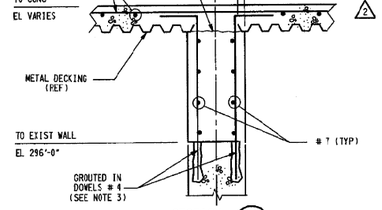

SECTION E (C-CC-Z-0012)
NTS
2 JOIST NOT SHOWN FOR CLARITY

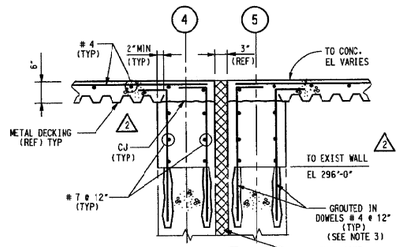

SECTION G (C-CC-Z-0012)
NTS
2 JOIST NOT SHOWN FOR CLARITY

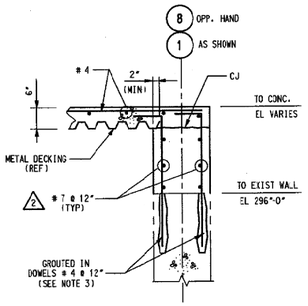

SECTION F (C-CC-Z-0012)
NTS
2 JOIST NOT SHOWN FOR CLARITY

NOTES

1. FOR GENERAL NOTES SEE DWG C-CC-Z-0011.
2. EXIST. J- BOLTS TO BE ABANDONED IN PLACE, NOT SHOWN ON DWG'S C-CC-Z-0013 AND C-CC-Z-0014 FOR CLARITY.
3. #4 DOWELS ARE NOT REQUIRED WITHIN 12" OF ABANDONED J-BOLTS AND SHALL HAVE A MIN EMBEDMENT OF 11".

ENGINEERING DOC. CONTROL-SRS
D0430084

C CC Z 0013 LATEST REVISION 3

PROJ.	REV. NO.	DATE	REVISION	PRP'D	LEAD ENG	CHK'D	APP'VD	APP'VD	APP'VD	APP'VD
S5515	0		ISSUED FOR CONSTRUCTION		SIGNATURES ON FILE					
S5515	1		ISSUED FOR CONSTRUCTION		SIGNATURES ON FILE					
S5515	2	11-23-94	REVISED DECKING ORIENTATION - ISSUED FOR CONSTRUCTION (DE-YWLW)		SIGNATURES ON FILE					
S5515	3	7-7-95	ISSUED AS-BUILT, INCORPORATED C-DCF-Z-00012		RJL	RJL	PB	DJL	DJL	

THIS DRAWING HAS BEEN FURNISHED BY THE SAVANNAH RIVER SITE. THE INFORMATION AND KNOW-HOW THEREIN MAY NOT BE USED NOR THE DRAWING REPRODUCED WITHOUT WRITTEN PERMISSION OF THE PRIME CONTRACTOR. ALL REPRODUCTIONS IN WHOLE OR IN PART, INCLUDING VENDOR'S SHOP DRAWINGS, SHALL BEAR OR REFER TO THIS STAMP.

REFERENCE DRAWINGS

C-CC-Z-0011	GENERAL NOTES
C-CC-Z-0012	ROOF PLAN
C-CC-Z-0014	CONCRETE SECTIONS & DETAILS SH 2

REFERENCE STANDARDS

UNITED STATES DEPARTMENT OF ENERGY
SAVANNAH RIVER SITE

BLDG. NO.	SITE CLEARANCE NO.	DESIGN AREA NO.	DESIGN GROUP
451-4Z	N/A	Z451	WRLW/DE

TITLE
SAVANNAH RIVER SITE-200Z
DEFFENSE WASTE PROCESSING FACILITY-SALTSTONE
SALTSTONE VAULT NO.4
PERMANENT ROOF
CONCRETE SECTIONS AND DETAILS
SHEET NO.1 (U)
STRUCTURAL CONCRETE

SCALE	SRS DRAWING NO.	SHEET NO.	LATEST REVISION
AS NOTED		1 OF 1	3

W.S. # ( ) . REF FILES ( ) YES ( ) NO
LEVELS 1 2 3 4 5 6 7 8 9 10 11 12 13 14 15 16 17 18 19 20 21 22 23 24 25 26 27 28 29 30 31 32 33 34 35 36 37 38 39 40 41 42 43 44 45 46 47 48 49 50 51 52 53 54 55 56 57 58 59 60 61 62 63 64
PSC# PLOT DATE 08/25/94 TIME 1345
DRAWN BY (ORIG) H.LEWIN
LAST CADD REV. BY: T.J. WEBER
DATE: 08MAY98

E:\dgn\c0012cc0013.001 Jul. 17, 1998 14:16:27