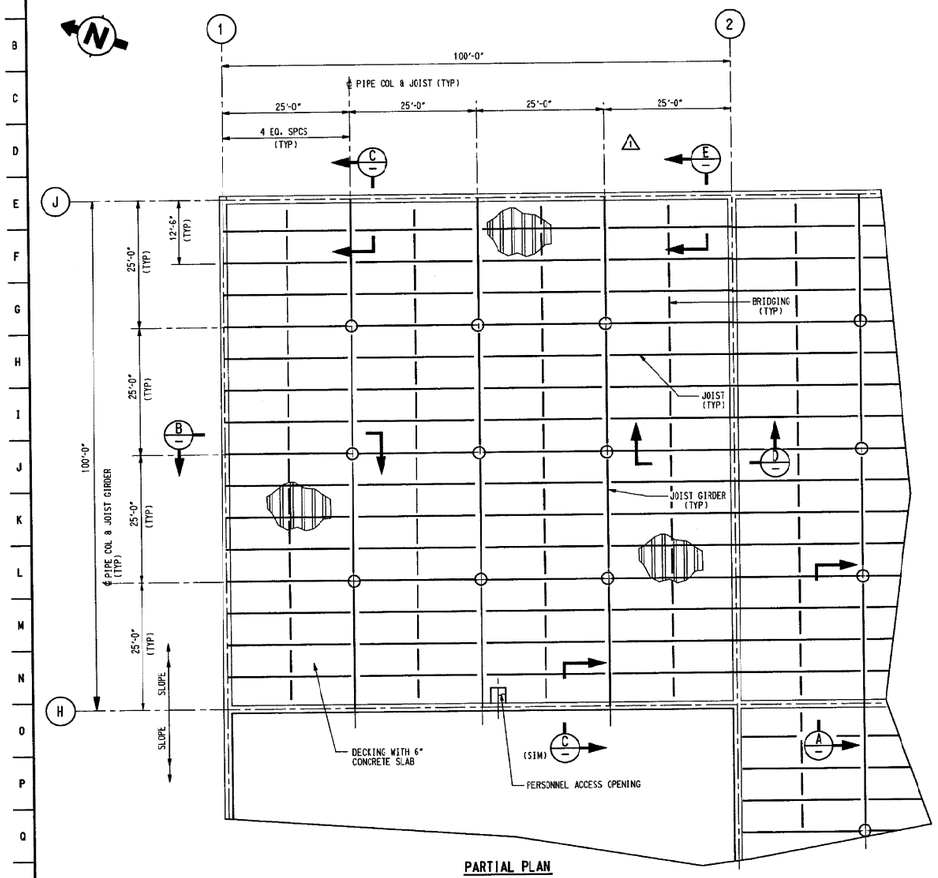

PARTIAL PLAN
TYPICAL CELL
VAULT NO.4
SCALE: 1" = 10'

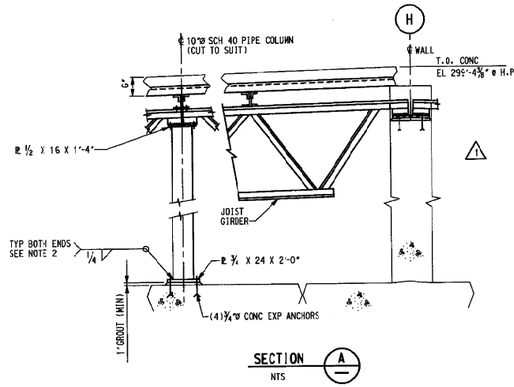

SECTION A
NTS

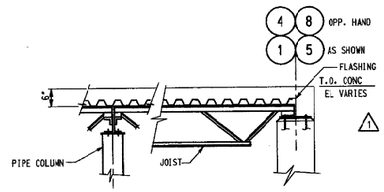

SECTION B
NTS

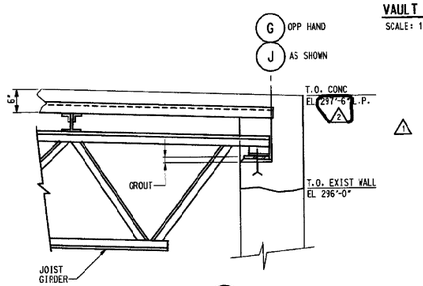

SECTION C
NTS

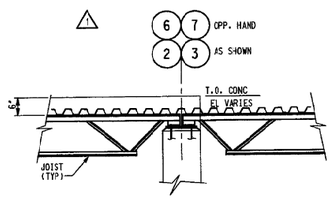

SECTION D
NTS

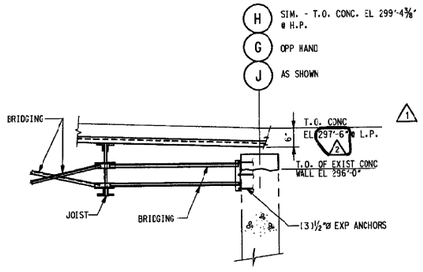

SECTION E
NTS

NOTES

1. FOR GENERAL NOTES SEE DRAWING C-CC-Z-0011.
2. PIPE COLUMNS SHALL BE FILLED WITH LEAN CONCRETE PRIOR TO ATTACHING TOP PLATE AND JOIST GIRDER.

ENGINEERING DOC. CONTROL-SRS
DOWNDOOS

C CS Z 0002 LATEST REVISION 2

PROJ.	REV. NO.	DATE	REVISION	PRP'D	LEAD ENG	CHK'D	APV'D	APV'D	APV'D
55515	0		ISSUED FOR CONSTRUCTION			SIGNATURES ON FILE			
55515	1	11-23-94	REVISED DECKING ORIENTATION - ISSUED FOR CONSTRUCTION (DE-WALW			SIGNATURES ON FILE			
55515	2	2/13/98	ISSUED AS-BUILT, INCORPORATED C-DCF-Z-00012	KEM	RJ	RJ	RDS	2/13	2/13

W.S. ⊕ [ ]
REF FILES YES NO

LEVELS 1234567890123456789012345678901234567890123456789012345678901234567890123456789012345

PSC- DRAWN BY (ORIG): K. ASLANER LAST CARD REV. BY: T.J. WELDER
PLOT DATE 5/6/94 TIME DATE: 04MAY98

THIS DRAWING HAS BEEN FURNISHED BY THE SAVANNAH RIVER SITE. THE INFORMATION AND KNOW-HOW THEREON MAY NOT BE USED FOR ANY PURPOSE OTHER THAN THAT FOR WHICH IT IS SPECIFICALLY FURNISHED NOR MAY IT BE REPRODUCED OR PRODUCT MADE THEREFROM WITHOUT PERMISSION. ALL CONTRACTORS AND VENDORS SHALL REVIEW AND APPROVE OR REJECT THEIR SHOP DRAWINGS, SHALL BEAR OF REFER TO THIS STAMP.

REFERENCE DRAWINGS

C-CC-Z-0011	GENERAL NOTES
C-CC-Z-0012	VAULT PLAN

REFERENCE STANDARDS

UNITED STATES DEPARTMENT OF ENERGY
SAVANNAH RIVER SITE

BLDG. NO.	SITE CLEARANCE NO.	DESIGN AREA NO.	DESIGN GROUP
451-4Z	N/A	Z451	V-WLW/DE

TITLE
SAVANNAH RIVER SITE-200Z AREA
DEFENSE WASTE PROCESSING FACILITY-SALTSTONE
SALTSTONE VAULT NO. 4
PERMANENT ROOF
STEEL SECTIONS AND DETAILS
SHEET NO.2 (U)
STRUCTURAL STEEL

SCALE	SRS DRAWING NO.	SHEET NO.	LATEST REVISION
AS NOTED		1 OF 1	2

E:\dgn\z-cc\z-cc2002.002 Jan. 17, 1995 14:17:56