ISOMETRIC OF	INDIAN POINT #2
MAIN STM LINE #2	B206657
SHEET 1 OF 2	

12/29/93	4

THIS REVISION IS CLASS 'A' AS PER CI-240-1. UPDATED DWG AS PER AS-BUILT INFORMATION AND IN-SERVICE INSPECTION FIELD REVISION INFORMATION RELEASE FOR RECORD
P.N. 69982-AD-3 JM/BV 12/15/93
ATOMETRICS INC.
12/17/93 FOM

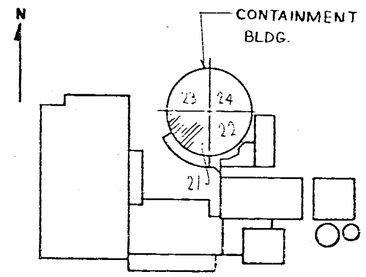

KEY PLAN

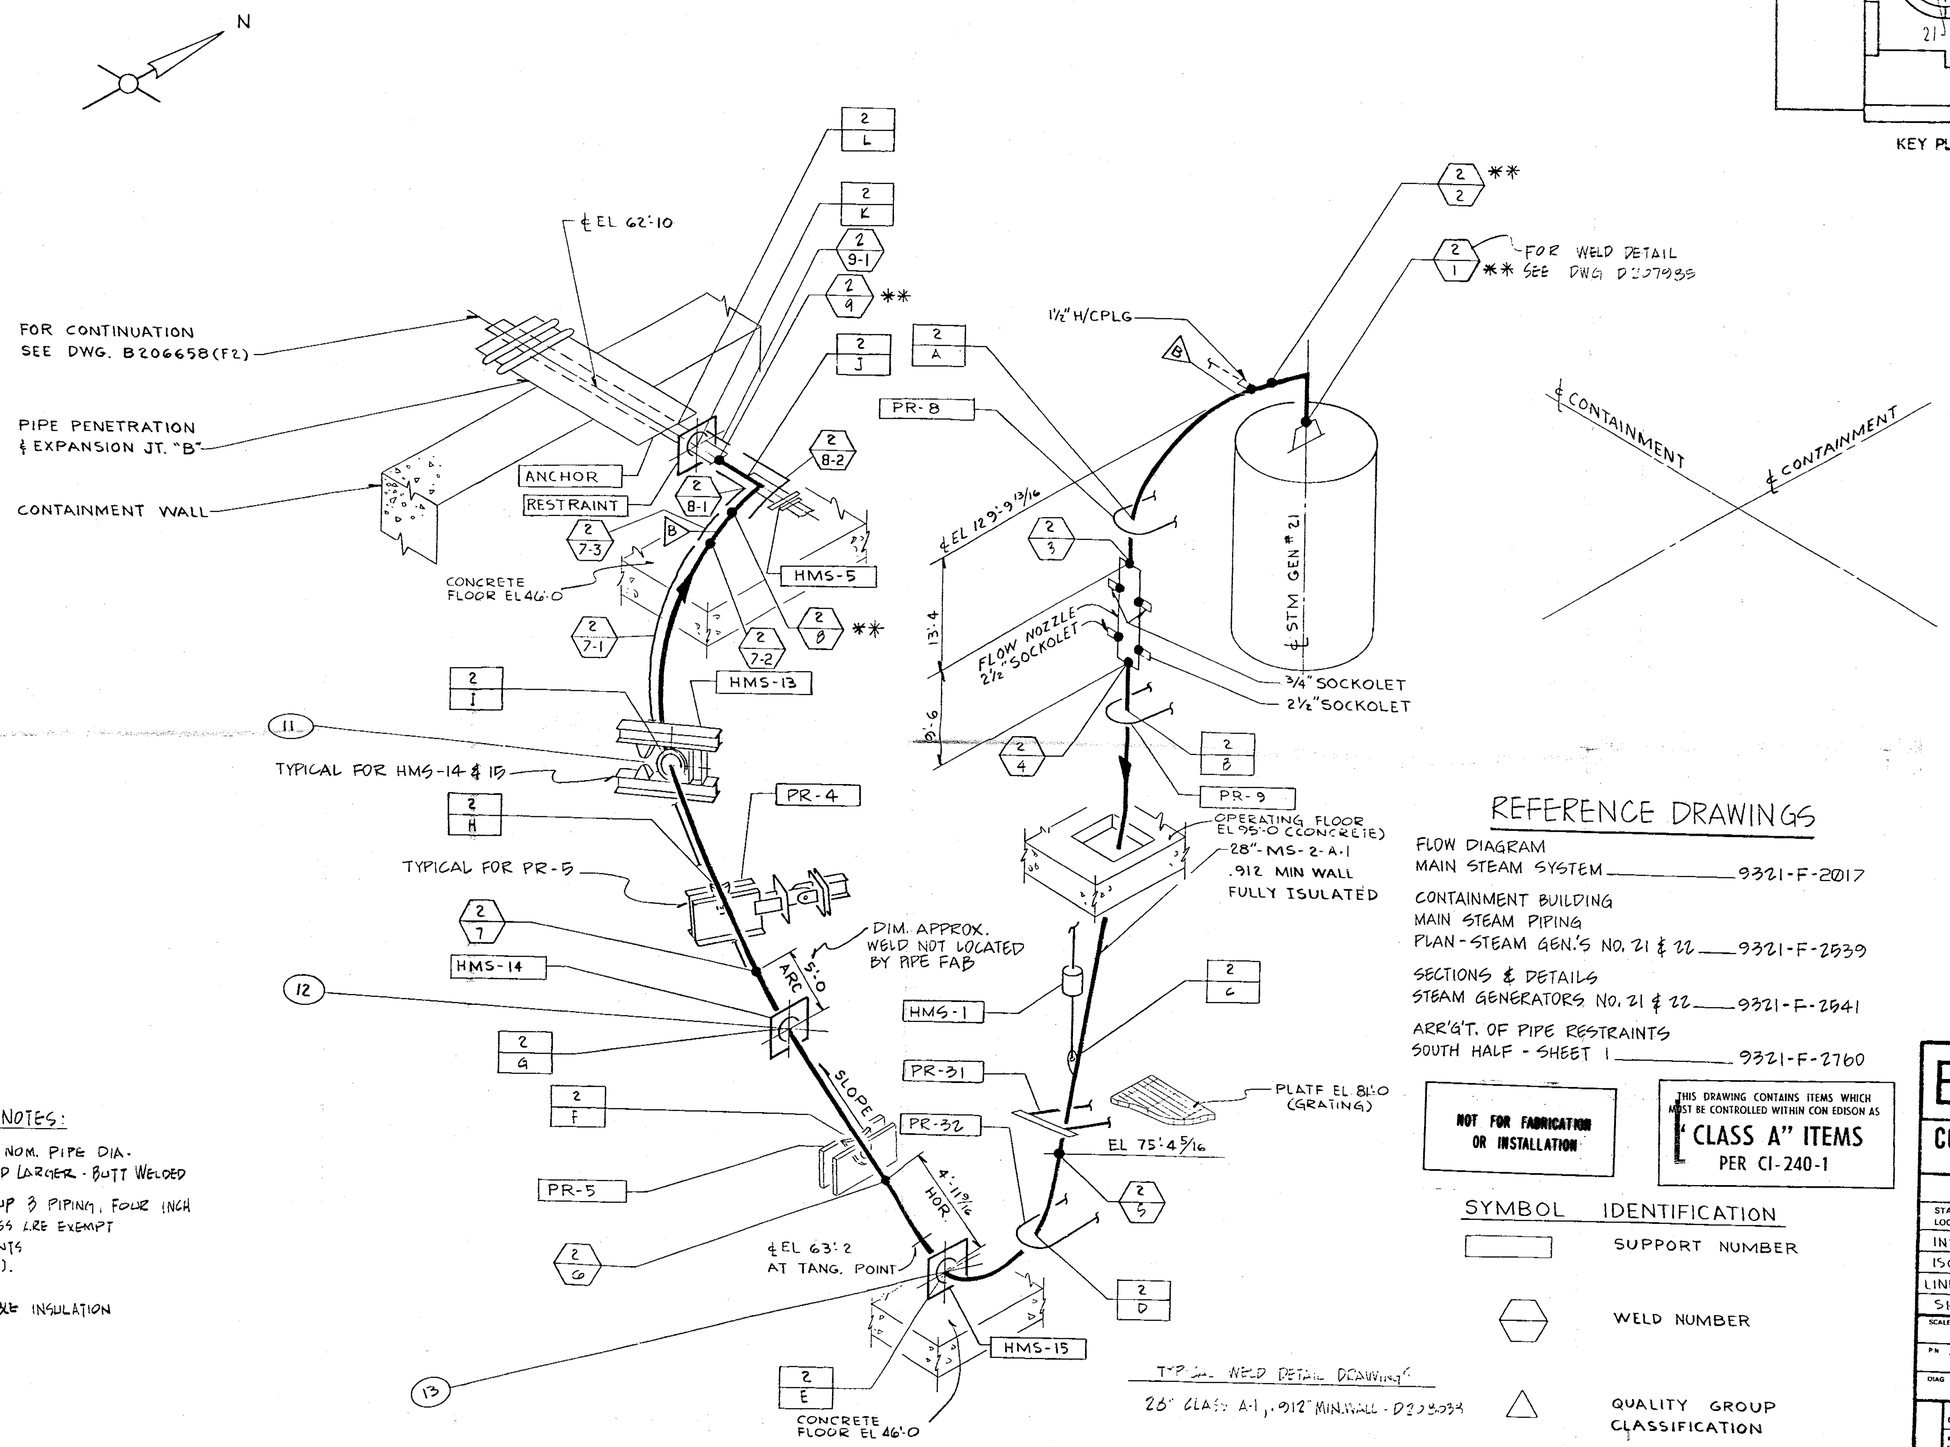

GENERAL NOTES:

1. WELDS LESS THAN 2½" NOM. PIPE DIA. SOCKET WELDED ; 2½" AND LARGER - BUTT WELDED
2. WELDS IN QUALITY GROUP 3 PIPING, FOUR INCH NOM. PIPE DIA OR LESS ARE EXEMPT FROM N.D.T. REQUIREMENTS PER IWC-1222(a)&(b).
3. (*) - INDICATES REMOVABLE INSULATION

REFERENCE DRAWINGS

FLOW DIAGRAM
MAIN STEAM SYSTEM ——— 9321-F-2017

CONTAINMENT BUILDING
MAIN STEAM PIPING
PLAN - STEAM GEN.'S NO. 21 & 22 ——— 9321-F-2539

SECTIONS & DETAILS
STEAM GENERATORS NO. 21 & 22 ——— 9321-F-2541

ARR'G'T. OF PIPE RESTRAINTS
SOUTH HALF - SHEET 1 ——— 9321-F-2760

NOT FOR FABRICATION OR INSTALLATION

THIS DRAWING CONTAINS ITEMS WHICH MUST BE CONTROLLED WITHIN CON EDISON AS "CLASS A" ITEMS PER CI-240-1

SYMBOL IDENTIFICATION

- SUPPORT NUMBER
- WELD NUMBER
- QUALITY GROUP CLASSIFICATION
- INTEGRAL SUPPORT WELD NUMBER
- ** STRUCTURAL DISCONTINUITY AT WELD PER TABLE IWC-2520 FOOTNOTE 1

Docket # 50-247
Accession # 9403110117
Date 2/28/94
Regulatory Docket File
of Ltr

REVISIONS	
0	THIS ISSUE IS NON-CLASS "A" PER CI 240.1. RELEASE FOR RECORD, P.N. 7076 11-3-78
1	THIS REVISION IS NON-CLASS "A" PER CI-240-1. ADDED REF. DRAWINGS, ADDED LATEST REV. Nº TO REF. DWG. RELEASE FOR RECORD, P.N. 7076 J.R./AS EBASCO SERVICES INC. 1-10-80
2	THIS REVISION IS NON-CLASS "A" PER CI-240-1. UPDATED DWG. PER INFORMATION RECEIVED FROM FIELD. RELEASE FOR RECORD. P.N. 21368 WB/RC 5-1-84
3	THIS REV IS NON-CLASS PER CI-240-1 CHANGED DISCIPLINE CODE FROM MJ TO ML. REL. FOR RECORD. P/N 69911-E1

NOT FOR FABRICATION OR INSTALLATION

B206657-4

CONSOLIDATED EDISON CO.
OF NEW YORK, INC.

STATION LOCATION INDIAN POINT Nº 2
INSERVICE INSPECTION
ISOMETRIC OF MAIN STEAM
LINE Nº 2 INSIDE CONTAINMENT
SHEET 1 OF 2

SCALE NONE	DRAWN BY J. ALAMILLA	RECORDED
P.N. 7076	CHECKED BY M. STEINAUER	ENG
DIAG / ELECT	MECH 14 / STRUCT	DIST

APPROVALS

GENERAL ENGINEERING	CHIEF DESIGN ENGINEER	
MECHANICAL ENGINEERING	MECH PLANT ENGINEER	
CIVIL ENGINEERING	PLANT STRUCT ENGINEER	
	T & D STRUCT ENGINEER	
ELECTRICAL ENGINEERING	STATION ELECT ENGINEER	
	T & D ENGINEER	
GAS & STEAM OPERATIONS	STRUCT ENGINEER	
PRODUCTION	CONVENTIONAL POWER	
	NUCLEAR POWER	ML

ANSTEC APERTURE CARD

FORM 929D21