ISOMETRIC OF MAIN STEAM LINE Nº 4 SHEET 1 OF 2	B-206661
INDIAN POINT Nº 2	

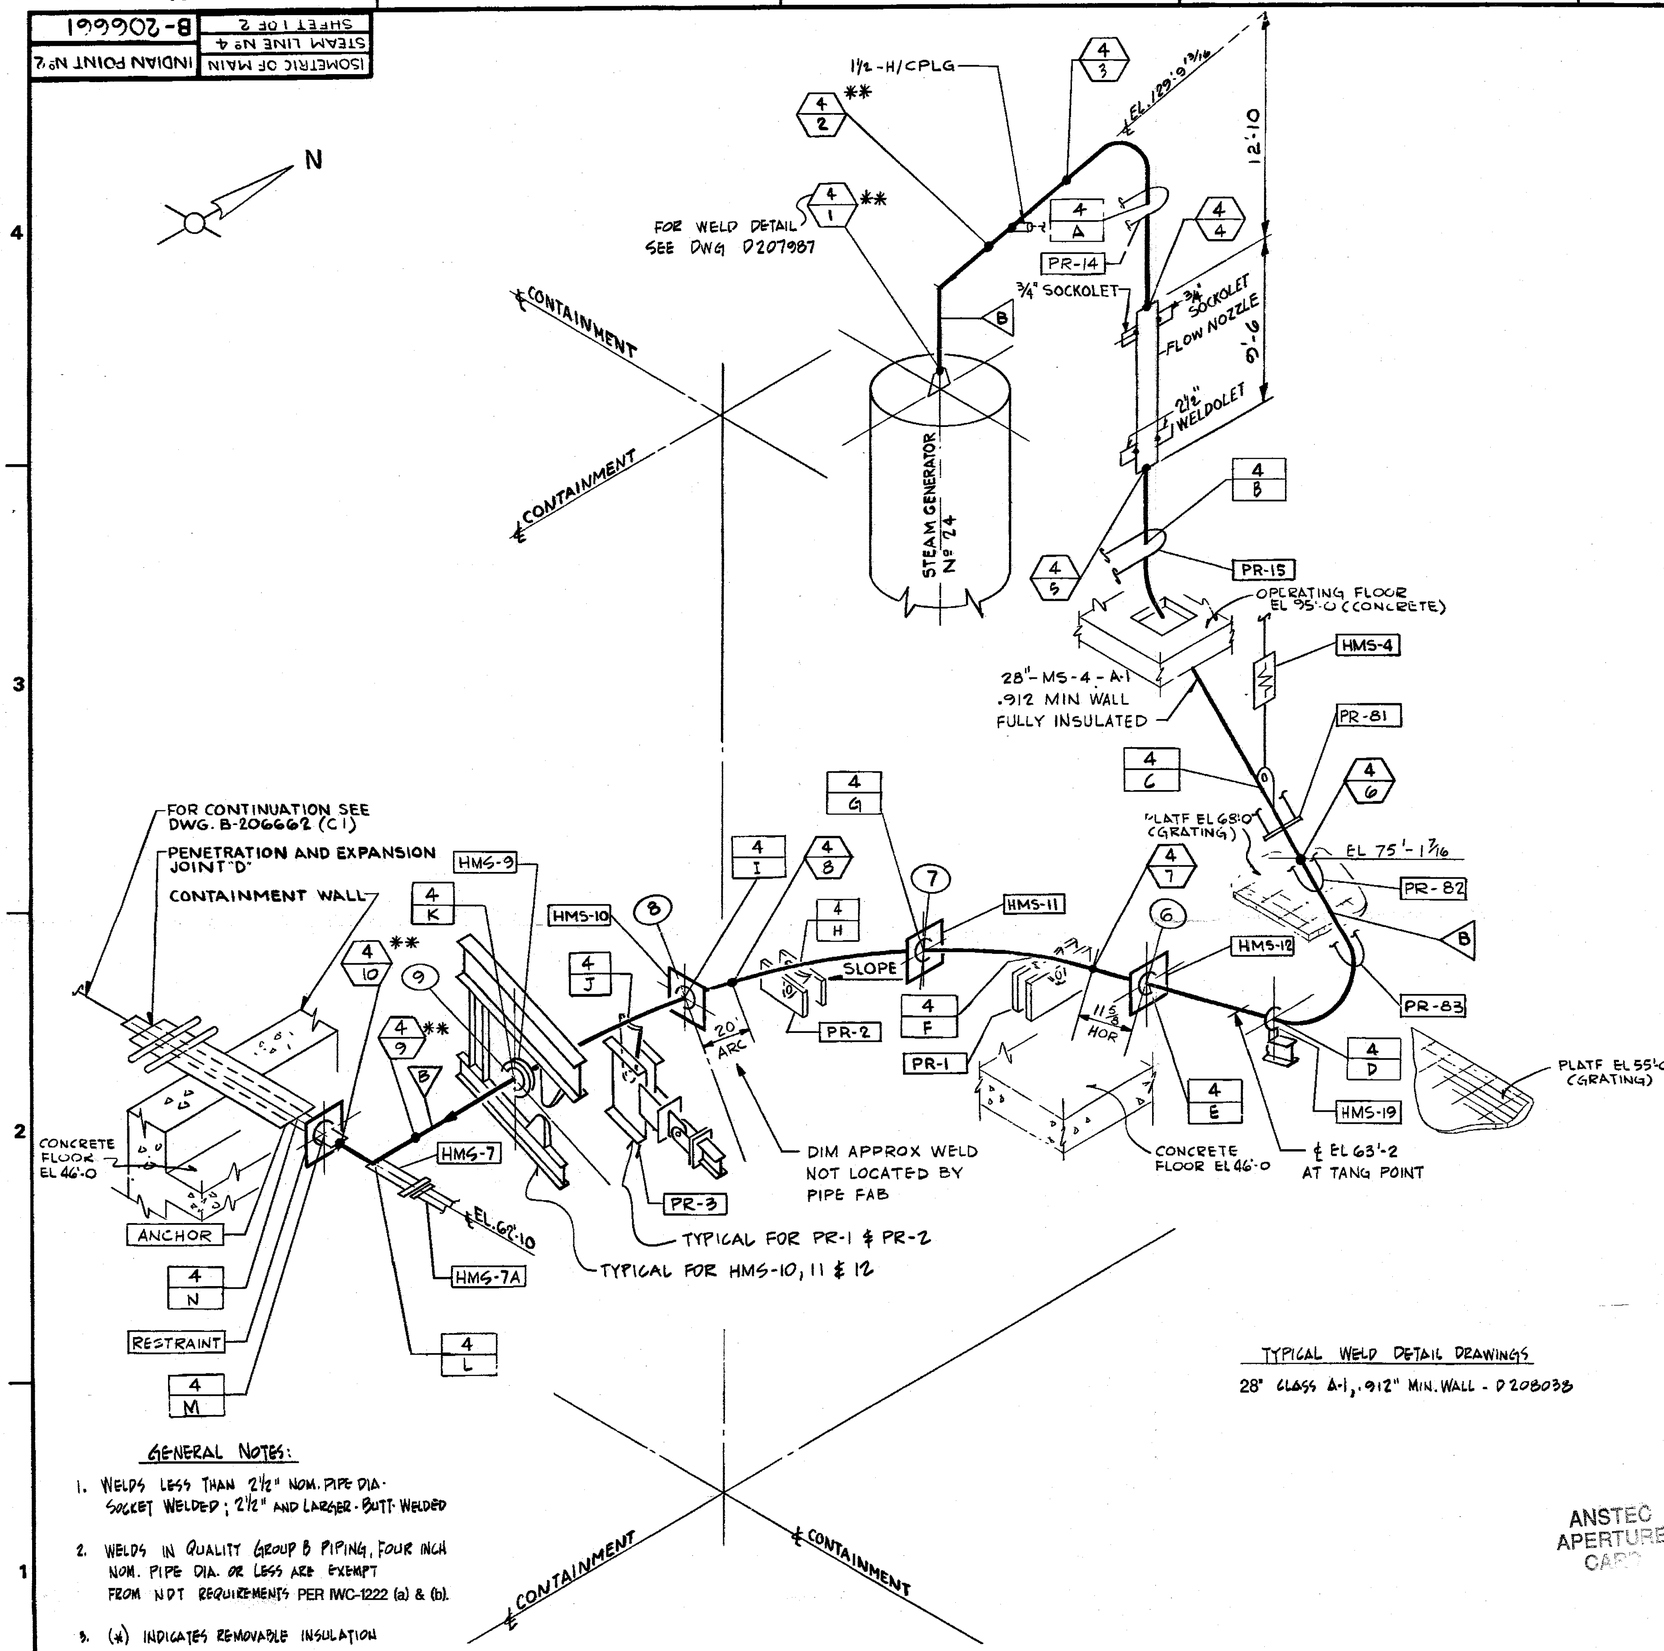

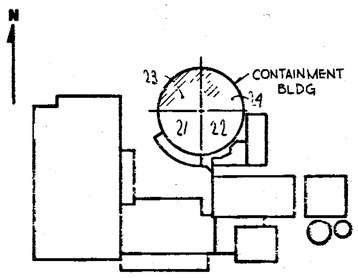

KEY PLAN

REFERENCE DRAWINGS

FLOW DIAGRAM
MAIN STEAM SYSTEM ——— 9321-F-2017

CONTAINMENT BUILDING
MAIN STEAM PIPING
PLAN - STEAM GEN'S NO. 23 & 24 ——— 9321-F-2540

SECTIONS & DETAILS
STEAM GENERATORS NO. 23 & 24 ——— 9321-F-2542

ARR'G'T OF PIPE RESTRAINTS
NORTH HALF - SHEET 1 ——— 9321-F-2738

Docket # 50-247
Accession # 9403210117
Date 2/28/94
Regulatory Docket File

NOT FOR FABRICATION OR INSTALLATION

THIS DRAWING CONTAINS ITEMS WHICH MUST BE CONTROLLED WITHIN CON EDISON AS:
"CLASS A" ITEMS PER CI-240-1

TYPICAL WELD DETAIL DRAWINGS
28" CLASS A-1, .912" MIN. WALL - D208038

SYMBOL IDENTIFICATION

- SUPPORT NUMBER
- WELD NUMBER
- QUALITY GROUP CLASSIFICATION
- INTEGRAL SUPPORT WELD NUMBER
- ** — STRUCTURAL DISCONTINUITY PER TABLE IWC-2520

GENERAL NOTES:

1. WELDS LESS THAN 2½" NOM. PIPE DIA. SOCKET WELDED; 2½" AND LARGER - BUTT WELDED
2. WELDS IN QUALITY GROUP B PIPING, FOUR INCH NOM. PIPE DIA. OR LESS ARE EXEMPT FROM NDT REQUIREMENTS PER IWC-1222 (a) & (b).
3. (*) INDICATES REMOVABLE INSULATION

ANSTEC APERTURE CARD

REVISIONS

0	THIS ISSUE IS NON-CLASS "A" PER CI 240-1. RELEASE FOR RECORD. P.N. 7076 11-3-78
1	THIS REVISION IS NON-CLASS "A" PER CI-240-1. ADDED REF. DRAWINGS. ADDED LATEST REV. Nº. TO REF. DWG. RELEASE FOR RECORD. P.N. 7076 J.R./AS EBASCO SERVICES, INC. 1-10-80
2	THIS REVISION IS NON-CLASS "A" PER CI-240-1 ADDED LATEST REV Nº TO REF DWG'S RELEASE FOR RECORD. P.N. 21363 TREADWELL CORP 11-12-82
3	THIS REVISION IS NON-CLASS PER CI-240-1. UPDATED DWG. PER INFORMATION RECEIVED FROM FIELD. RELEASE FOR RECORD. P.N. 21363 VO/RC 5/16/84
4	THIS REV IS NON-CLASS PER CI-240 1. CHANGED DISCIPLINE CODE FROM "MJ" TO "ML" RELEASE FOR RECORD. J.J./J.M.
5	THIS REVISION IS CLASS A PER CI-240-1 UPDATED DWG. PER AS-BUILT INFORMATION AND SERVICE INSPECTION FIELD REVISION INFORMATION. RELEASED FOR RECORD P/N 69982-AD-4 NPS 12/16/93 AAA

NOT FOR FABRICATION OR INSTALLATION

B206661-5

CONSOLIDATED EDISON CO.
OF NEW YORK, INC.

STATION LOCATION: INDIAN POINT Nº 2
INSERVICE INSPECTION ISOMETRIC OF MAIN STEAM LINE Nº 4 INSIDE CONTAINMENT

SCALE	DRAWN BY	RECORDED
NONE	C. ZAPATA	
P.N. 7076	CHECKED BY M STEINAUER	ENG
DIAG / ELECT / MECH	STRUCT	DIST

APPROVALS

GENERAL ENGINEERING	CHIEF DESIGN ENGINEER	
MECHANICAL ENGINEERING	MECH PLANT ENGINEER	
CIVIL ENGINEERING	PLANT STRUCT ENGINEER	
	T & D STRUCT ENGINEER	
ELECTRICAL ENGINEERING	STATION ELECT ENGINEER	
	T & D ENGINEER	
GAS & STEAM OPERATIONS	STRUCT ENGINEER	
PRODUCTION	CONVENTIONAL POWER	
	NUCLEAR POWER	ML

FORM 929D21