ISOMETRIC OF SAFETY INJECTION LINE Nº16 SHEET 3 OF 3	INDIAN POINT Nº 2 B-206683

VALVE BONNET BONNET						
VALVE NO.	VALVE TYPE	NO.OF BOLTS	BOLT DIA.	BOLT TYPE	VALVE MANUFACTURER	MANUFACTURER DWG. NO.
856D	2-TM58FM				VELAN	137116
856F						
857A	2-C58				CONVAL	
857D	2-C58				CONVAL	
857H	2-C58				CONVAL	
857M	2-C58				CONVAL	

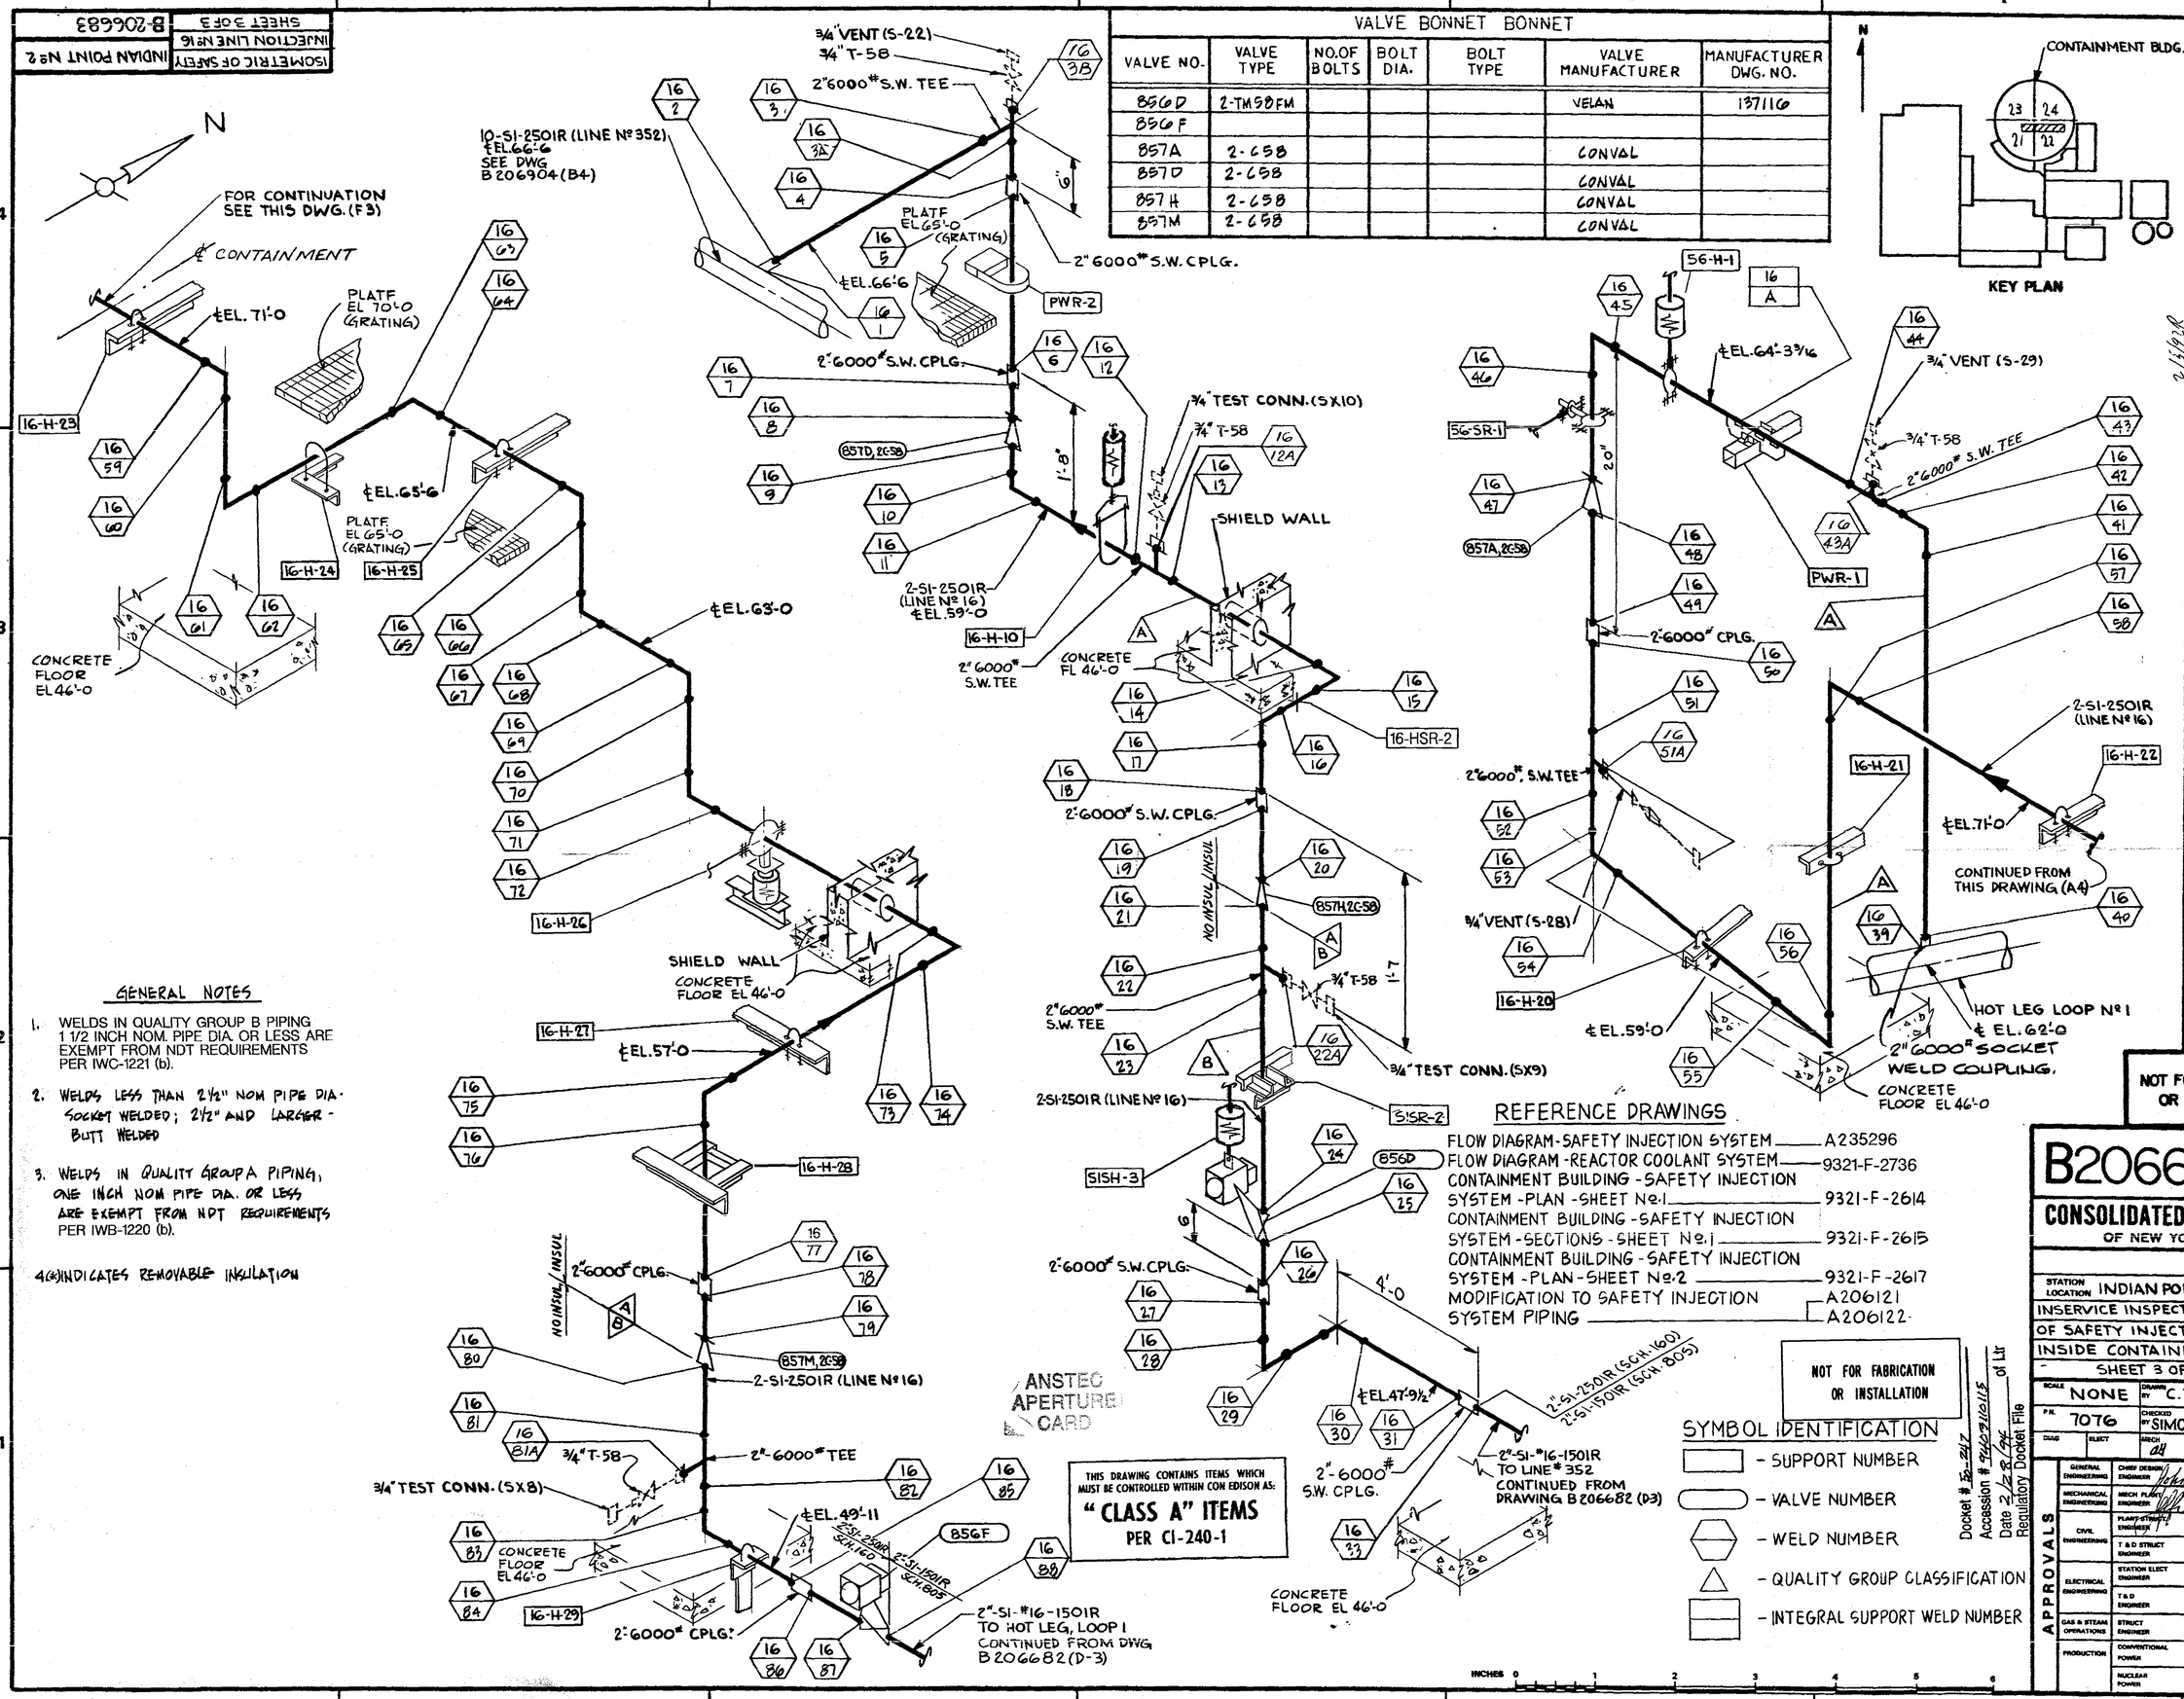

GENERAL NOTES

1. WELDS IN QUALITY GROUP B PIPING 1 1/2 INCH NOM. PIPE DIA. OR LESS ARE EXEMPT FROM NDT REQUIREMENTS PER IWC-1221 (b).
2. WELDS LESS THAN 2½" NOM PIPE DIA. SOCKET WELDED; 2½" AND LARGER - BUTT WELDED
3. WELDS IN QUALITY GROUP A PIPING, ONE INCH NOM PIPE DIA. OR LESS ARE EXEMPT FROM NDT REQUIREMENTS PER IWB-1220 (b).

4 (G) INDICATES REMOVABLE INSULATION

REFERENCE DRAWINGS

FLOW DIAGRAM - SAFETY INJECTION SYSTEM	A235296
FLOW DIAGRAM - REACTOR COOLANT SYSTEM	9321-F-2736
CONTAINMENT BUILDING - SAFETY INJECTION SYSTEM - PLAN - SHEET Nº1	9321-F-2614
CONTAINMENT BUILDING - SAFETY INJECTION SYSTEM - SECTIONS - SHEET Nº1	9321-F-2615
CONTAINMENT BUILDING - SAFETY INJECTION SYSTEM - PLAN - SHEET Nº2	9321-F-2617
MODIFICATION TO SAFETY INJECTION SYSTEM PIPING	A206121, A206122

SYMBOL IDENTIFICATION

- SUPPORT NUMBER
- VALVE NUMBER
- WELD NUMBER
- QUALITY GROUP CLASSIFICATION
- INTEGRAL SUPPORT WELD NUMBER

THIS DRAWING CONTAINS ITEMS WHICH MUST BE CONTROLLED WITHIN CON EDISON AS: **"CLASS A" ITEMS PER CI-240-1**

NOT FOR FABRICATION OR INSTALLATION

ANSTEC APERTURE CARD

Docket # 50-247
Accession # 7912310118
Date 2/28/79
Regulatory Docket File
of Ltr

REVISIONS

0 — 11-3-78 — THIS ISSUE IS NON-CLASS "A" PER CI 240-1. RELEASE FOR RECORD. P.N. 7076 11-3-78

3 — 11-21-92 — THIS REVISION IS NON CLASS PER CI-240-1 UPDATED DWG PER AS FOUND CONDITIONS - PKG #6928 RELEASE FOR RECORD P.N. 69911-CJ WS/KE

4 — 5/4/93 — THIS REV. IS NON-CLASS PER CI-240-1 CHANGED DISCIPLINE CODE FROM MJ TO ML. RELEASE FOR RECORD P.N. 69911-E1

5 — 12-12-94 — THIS REVISION IS CLASS A PER CI-240-1 UPDATED DWG. PER AS-BUILT INFORMATION AND SERVICE INSPECTION FIELD REVISION INFORMATION. RELEASED FOR RECORD - P/N 69982-AD-4 NPS 12-14-93 AAA

NOT FOR FABRICATION OR INSTALLATION

B206683-5

CONSOLIDATED EDISON CO. OF NEW YORK, INC.

STATION LOCATION: INDIAN POINT NUMBER 2
INSERVICE INSPECTION ISOMETRIC OF SAFETY INJECTION LINE Nº 16 INSIDE CONTAINMENT BUILDING - SHEET 3 OF 3

SCALE	DRAWN BY	RECOMMENDED
NONE	C. ZAPATA	
P.N. 7076	CHECKED BY SIMONE	ENG.
CHAG / ELECT / MECH 04 / STRUCT. / DIST		

APPROVALS

GENERAL ENGINEERING	CHIEF DESIGN ENGINEER	
MECHANICAL ENGINEERING	MECH PLANT ENGINEER	
CIVIL ENGINEERING	PLANT STRUCT ENGINEER	
	T & D STRUCT ENGINEER	
ELECTRICAL ENGINEERING	STATION ELECT ENGINEER	
	T & D ENGINEER	
GAS & STEAM OPERATIONS	STRUCT ENGINEER	
PRODUCTION	CONVENTIONAL POWER	
	NUCLEAR POWER	ML