B 206902	ISOMETRIC OF SAFETY INJECT. LINE Nº 351-INSIDE CONTAINMENT-SHT 1 OF 2
INDIAN POINT Nº2	

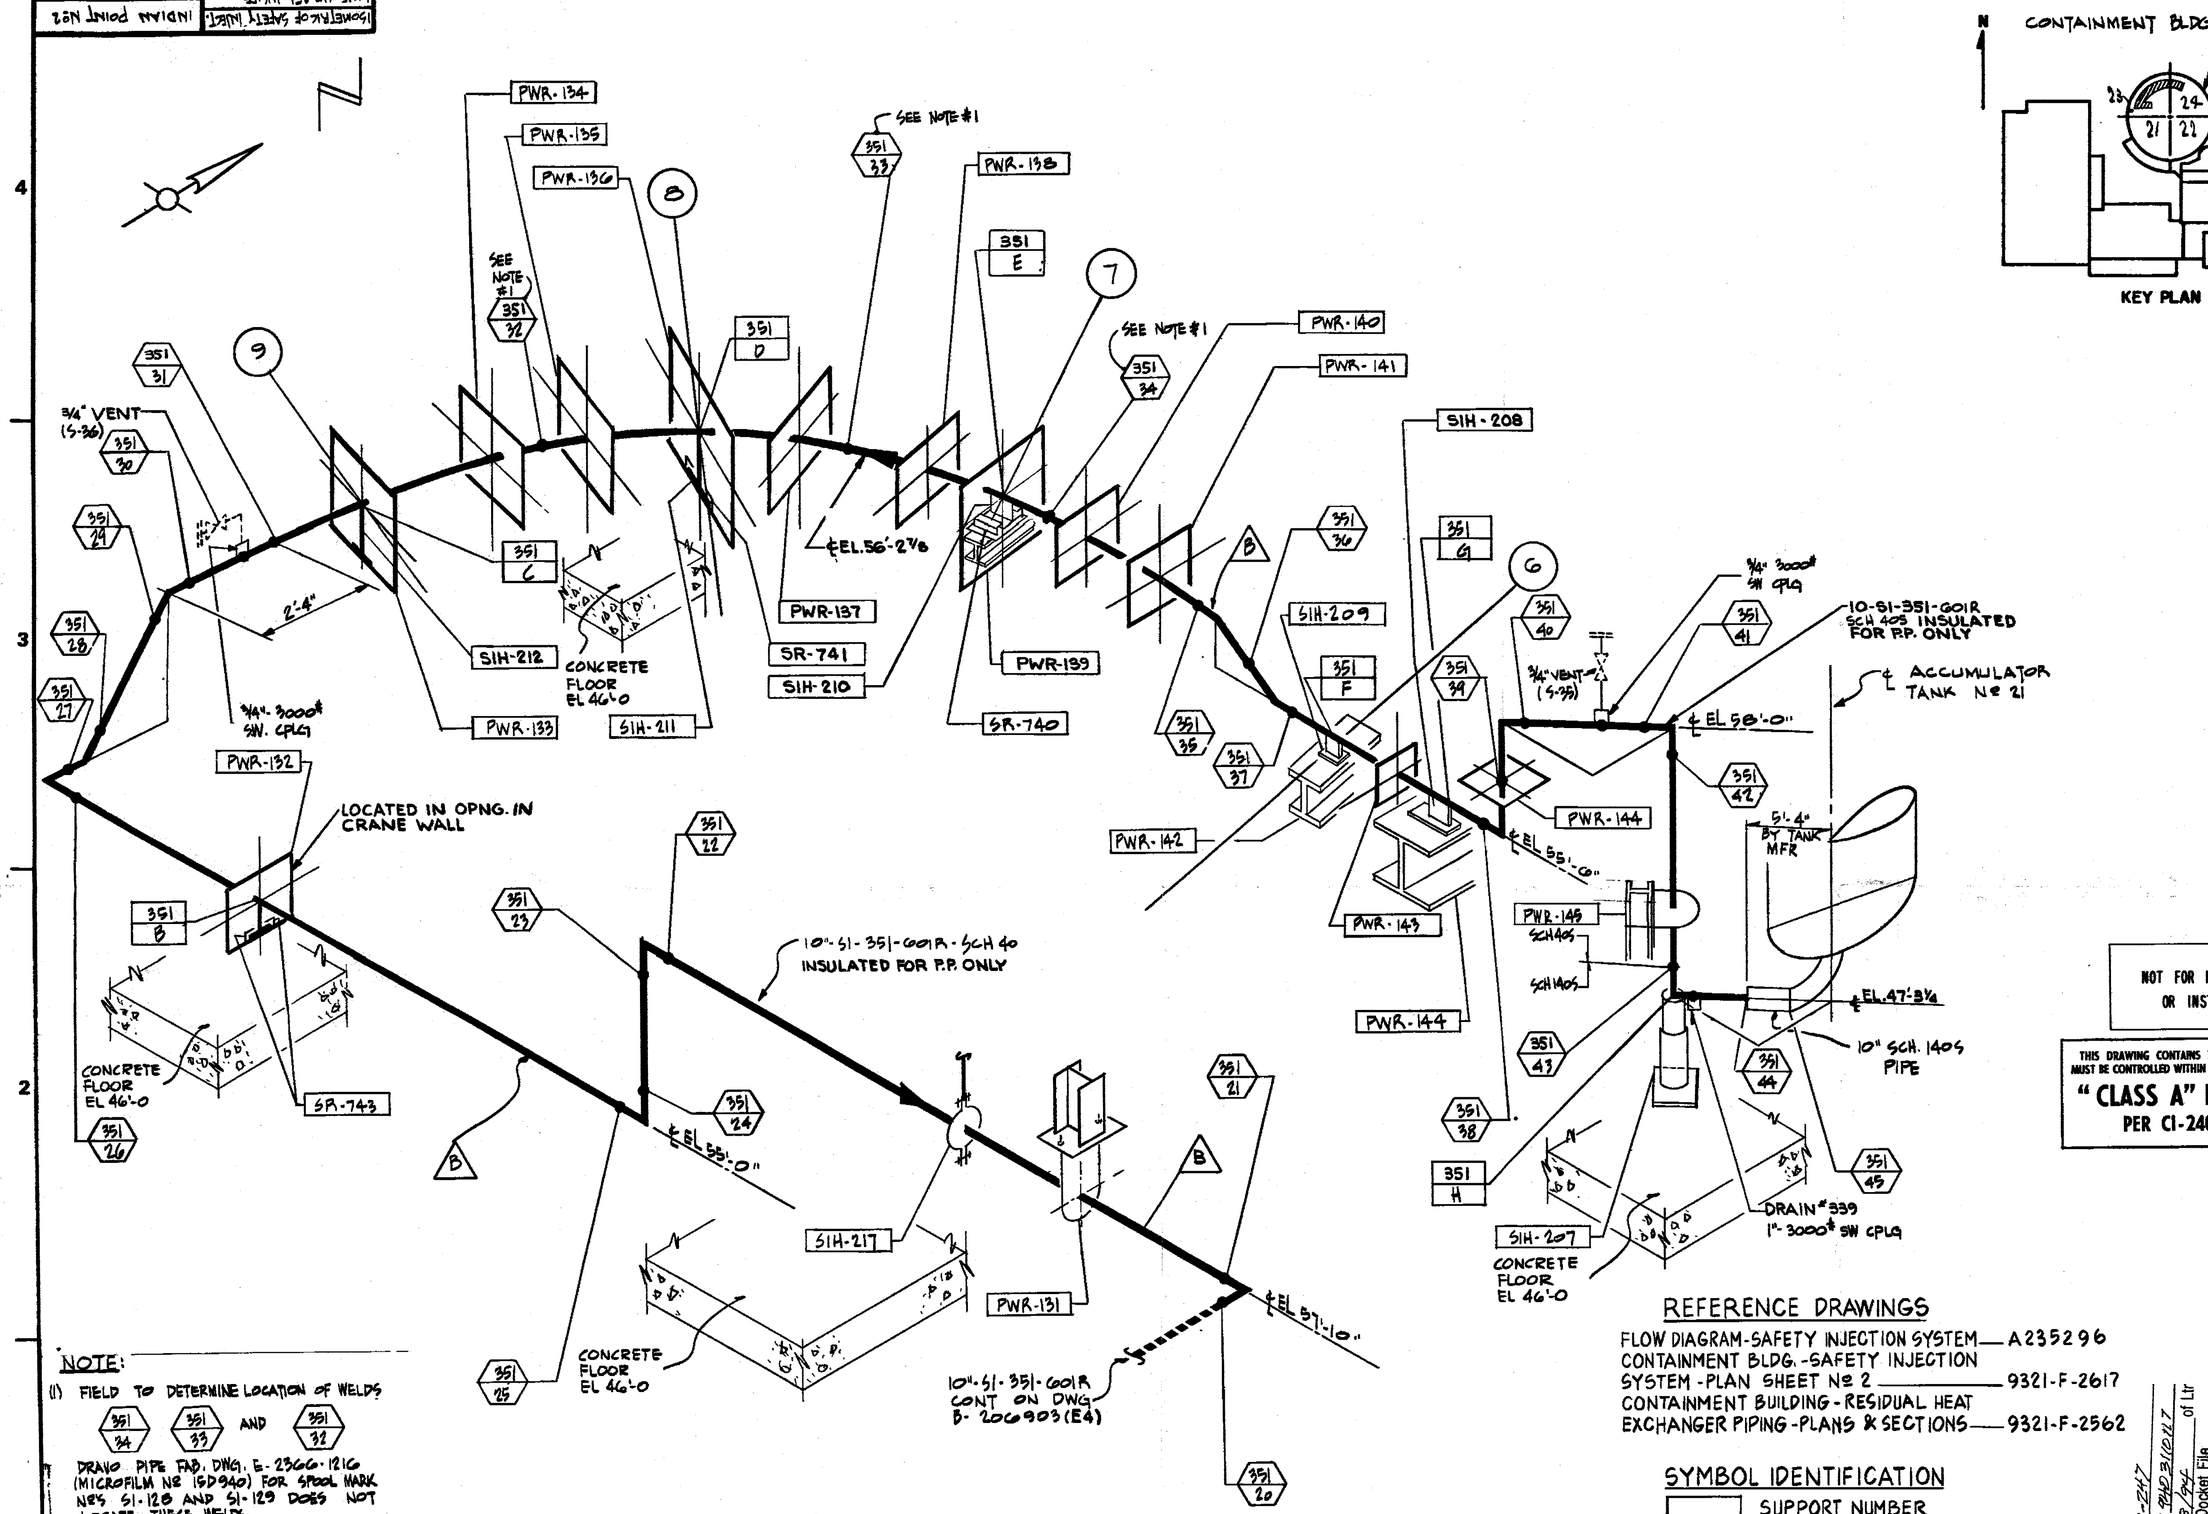

NOT FOR FABRICATION OR INSTALLATION

THIS DRAWING CONTAINS ITEMS WHICH MUST BE CONTROLLED WITHIN CON EDISON AS:
"CLASS A" ITEMS PER CI-240-1

NOTE:

(1) FIELD TO DETERMINE LOCATION OF WELDS 351/34, 351/33 AND 351/32

DRAWO PIPE FAB. DWG. E-2366-1216 (MICROFILM Nº (SD940) FOR SPOOL MARK Nº S1-128 AND S1-129 DOES NOT LOCATE THESE WELDS.

TYPICAL WELD DETAIL DRAWINGS

10" CLASS 2501, SCH 140S - D 208023
10" CLASS 601, SCH 40S - D 208024

FOR GENERAL NOTES SEE DWG B 206903

REFERENCE DRAWINGS

FLOW DIAGRAM-SAFETY INJECTION SYSTEM — A235296
CONTAINMENT BLDG.-SAFETY INJECTION SYSTEM-PLAN SHEET Nº 2 — 9321-F-2617
CONTAINMENT BUILDING-RESIDUAL HEAT EXCHANGER PIPING-PLANS & SECTIONS — 9321-F-2562

SYMBOL IDENTIFICATION

- SUPPORT NUMBER
- VALVE NUMBER
- WELD NUMBER
- QUALITY GROUP CLASSIFICATION
- INTEGRAL SUPPORT WELD NUMBER

Docket #50-247
Accession # 9310310117
Date 2/28/94 of Ltr
Regulatory Docket File

ANSTEC APERTURE CARD

REVISIONS

0 — 11-3-78 — THIS ISSUE IS NON-CLASS "A" PER CI 240-1. RELEASE FOR RECORD. P.N. 7076 11-3-78

1 — THIS REVISION IS NON-CLASS "A" PER CI-240-1. ADDED REF. DRAWING. UPDATED DWG. TO SHOW WORK ON DWG. 9321-F-2617, THRU REV. 22. ADDED LATEST REV. Nº TO REF. DWG'S. RELEASE FOR RECORD. P.N. 7076 RT/AS EBASCO SERVICES, INC. 1-10-80

2 — THIS REVISION IS NON-CLASS "A" PER CI-240-1. ADDED LATEST REV. Nº TO REF. DWG'S, REMOVED SR-742. RELEASE FOR RECORD, P.N. 21368 TREADWELL CORP. 11-12-82.

3 — THIS REV. IS NON CLASS PER CI-240-1 CHANGED DISCIPLINE CODE FROM MJ TO ML. RELEASE FOR RECORD P.N. 6990-E1 A.G.

4 — THIS REVISION IS CLASS A PER CI-240-1 UPDATED DWG PER AS-BUILT INFORMATION AND SERVICE INSPECTION FIELD REVISION INFORMATION. RELEASED FOR RECORD P/N 89982-AD-4 NPS 12-15-93 AAA

NOT FOR FABRICATION OR INSTALLATION

B206902-4

CONSOLIDATED EDISON CO. OF NEW YORK, INC.

STATION LOCATION	INDIAN POINT Nº 2
	INSERVICE INSPECTION
	ISOMETRIC OF SAFETY INJECTION LINE Nº 351
	INSIDE CONTAINMENT BLDG SHT 1 OF 2
	ACCUMULATOR Nº 21 DISCHARGE
SCALE	NONE
DRAWN BY	P DENE
RECORDED	11/13/78
P.N.	7076
CHECKED BY	M. STEINAUER
DIAG. / ELECT / MECH 28 / STRUCT / CIVIL	

APPROVALS: GENERAL ENGINEERING — CHIEF DESIGN ENGINEER; MECHANICAL ENGINEERING — MECH PLANT ENGINEER; CIVIL ENGINEERING — PLANT STRUCT ENGINEER; T & D STRUCT ENGINEER; ELECTRICAL ENGINEERING — STATION ELECT ENGINEER; T & D ENGINEER; GAS & STEAM OPERATIONS — STRUCT ENGINEER; PRODUCTION — CONVENTIONAL POWER; NUCLEAR POWER — ML