INDIAN POINT No 2	ISOMETRIC OF SAFETY INJECT. LINE No 356 - INSIDE CONTAINMENT	B206907

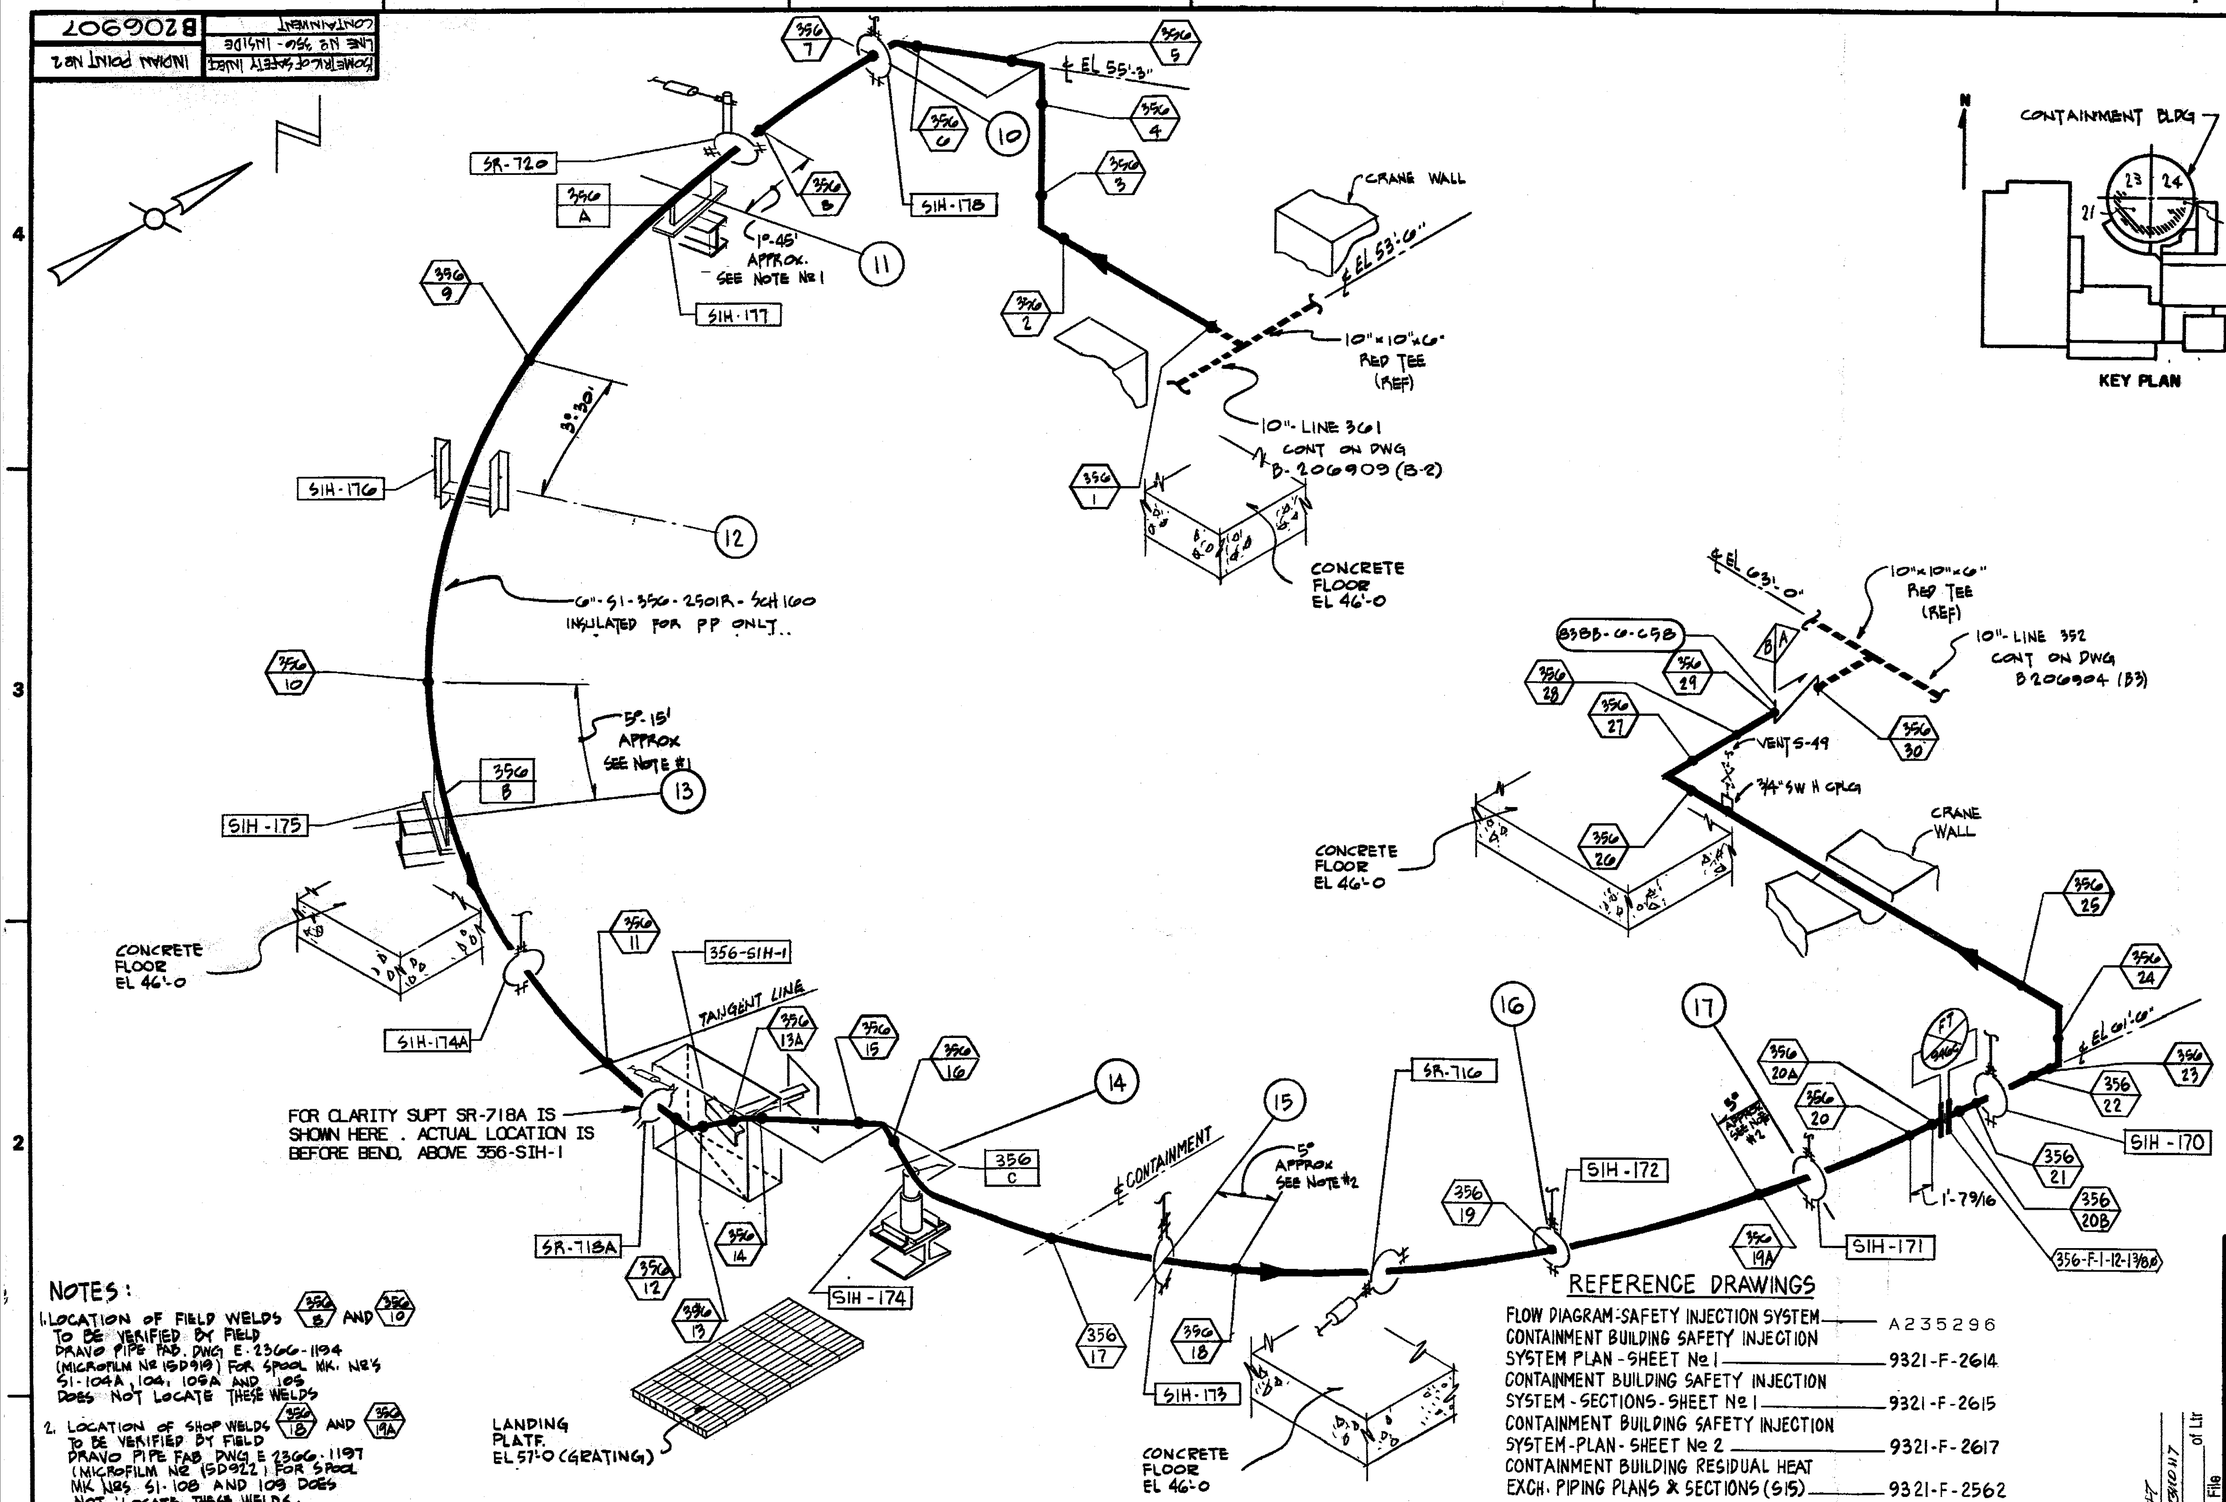

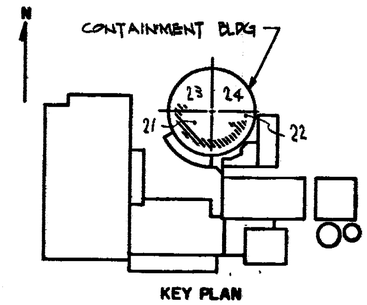

NOTES:

1. LOCATION OF FIELD WELDS 356/B AND 356/10 TO BE VERIFIED BY FIELD DRAVO PIPE FAB. DWG E-2366-1194 (MICROFILM No 1SD919) FOR SPOOL MK. No'S S1-104A, 104, 105A AND 105 DOES NOT LOCATE THESE WELDS
2. LOCATION OF SHOP WELDS 356/18 AND 356/19A TO BE VERIFIED BY FIELD DRAVO PIPE FAB DWG E 2366-1197 (MICROFILM No 1SD922) FOR SPOOL MK No'S S1-108 AND 109 DOES NOT LOCATE THESE WELDS.

FOR GENERAL NOTES SEE DWG B206906

REFERENCE DRAWINGS

FLOW DIAGRAM-SAFETY INJECTION SYSTEM	A235296
CONTAINMENT BUILDING SAFETY INJECTION SYSTEM PLAN - SHEET No 1	9321-F-2614
CONTAINMENT BUILDING SAFETY INJECTION SYSTEM - SECTIONS - SHEET No 1	9321-F-2615
CONTAINMENT BUILDING SAFETY INJECTION SYSTEM-PLAN - SHEET No 2	9321-F-2617
CONTAINMENT BUILDING RESIDUAL HEAT EXCH. PIPING PLANS & SECTIONS (S15)	9321-F-2562

TYPICAL WELD DETAIL DRAWINGS

6" CLASS 2501, SCH 160 - D208015

SYMBOL IDENTIFICATION

- SUPPORT NUMBER
- FLANGE No, NUMBER OF BOLTS, & BOLT DIAMETER
- VALVE NUMBER
- WELD NUMBER
- QUALITY GROUP CLASSIFICATION
- INTEGRAL SUPPORT WELD NUMBER

ANSTEC APERTURE CARD

VALVE BONNET BOLTING

VALVE NO.	VALVE TYPE	NO. OF BOLTS	BOLT DIA.	BOLT TYPE	VALVE MANUFACTURER	MANUFACTURER DWG. NO.
0388	6-6SB	12			VELAN	78704

REVISIONS

4 — THIS REVISION IS CLASS "A" PER CI-240-1 UPDATED DWG. PER AS BUILT INFORMATION AND SERVICE INSPECTION FIELD REVISION INFORMATION. RELEASED FOR RECORD P/N 69982-AO-4 NPS 12-15-93 AAA

1 — THIS REVISION IS NON-CLASS "A" PER CI-240-1. UPDATED DWG. TO SHOW WORK ON DWG'S. 9321-F-2614, THRU REV. 19 AND 9321-F-2617, THRU REV. 22. ADDED REF. DWG'S. ADDED LATEST REV. No. TO REF. DWG'S. RELEASE FOR RECORD: P.N. 7076 RT/AS EBASCO SERVICES, INC. 1-10-80

2 — THIS REVISION IS NON-CLASS "A" PER CI-240-1. ADDED LATEST REV. No TO REF. DWG'S. ADDED 356-SIH-1. REMOVED SR-708, 714, 715, 718, 719, 747, 356-SR-1, 356-SR-717, SR-717 RELEASE FOR RECORD P.N. 21368 TREADWELL CORP. 11-12-82.

3 — THIS REV. IS NON CLASS PER CI-240-1 CHANGED DISCIPLINE CODE FROM MJ TO ML. RELEASE FOR RECORD P.N. 69911-E1 AG

NOT FOR FABRICATION OR INSTALLATION

B206907-4

CONSOLIDATED EDISON CO.
OF NEW YORK, INC.

STATION LOCATION: INDIAN POINT No 2
INSERVICE INSPECTION
ISOMETRIC OF SAFETY INJECTION LINE
No 356 INSIDE CONTAINMENT (RHR RETURN)

SCALE	DRAWN BY	RECOMMENDED
NONE	P. DENE	11/21/78
P.N. 7076	CHECKED BY M. STEINAUER	ENGR.
DIMS / ELECT.	MECHAN. / STRUCT	CHIEF

APPROVALS: GENERAL ENGINEERING — CHIEF DESIGN ENGINEER; MECHANICAL ENGINEERING — MECH. ENGR. ENGINEER; CIVIL ENGINEERING — PLANT STRUCT. ENGINEER; T & D STRUCT ENGINEER; ELECTRICAL ENGINEERING — STATION ELECT ENGINEER; T & D ENGINEER; GAS & STEAM OPERATIONS — STRUCT ENGINEER; PRODUCTION — CONVENTIONAL POWER; NUCLEAR POWER

Docket # 50-247
Accession # 8412280117
Date 2/28/84
Regulatory Docket File
of Ltr

NOT FOR FABRICATION OR INSTALLATION

THIS DRAWING CONTAINS ITEMS WHICH MUST BE CONTROLLED WITHIN CON EDISON AS: "CLASS A" ITEMS PER CI-240-1

ML

FORM 826021