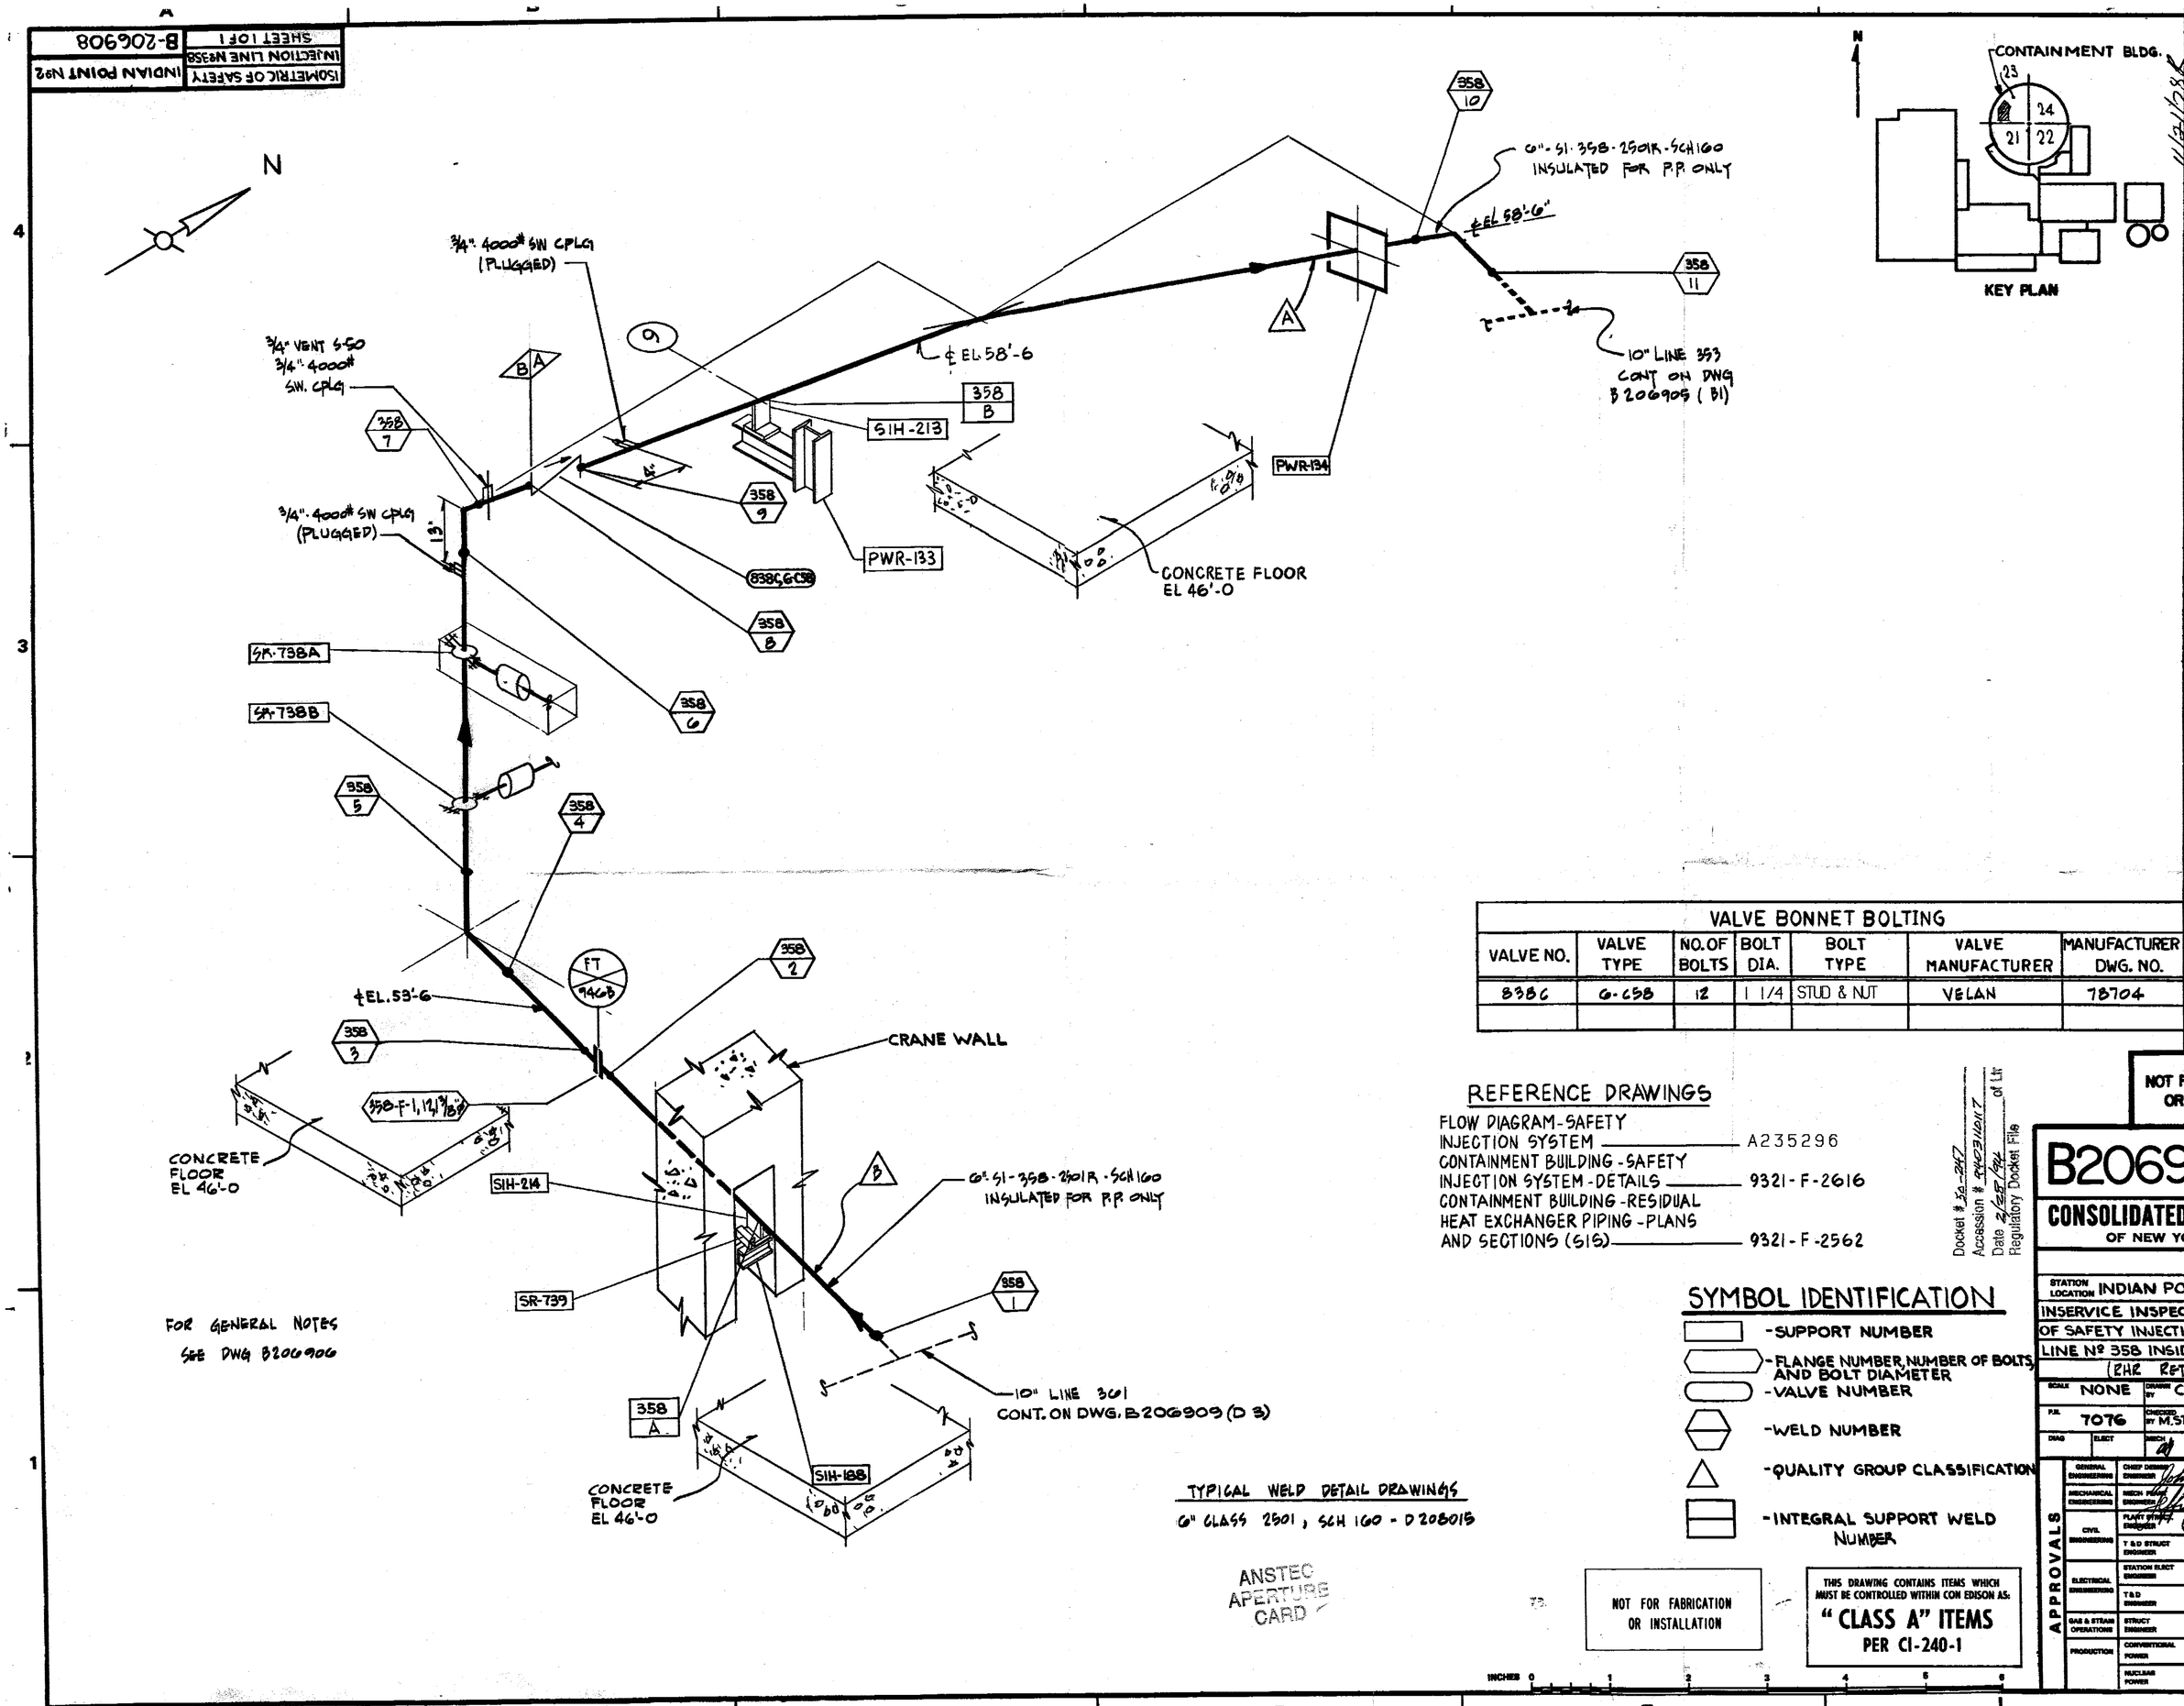

KEY PLAN

VALVE BONNET BOLTING						
VALVE NO.	VALVE TYPE	NO. OF BOLTS	BOLT DIA.	BOLT TYPE	VALVE MANUFACTURER	MANUFACTURER DWG. NO.
838C	6-C58	12	1 1/4	STUD & NUT	VELAN	78704

REFERENCE DRAWINGS

FLOW DIAGRAM-SAFETY INJECTION SYSTEM — A235296
CONTAINMENT BUILDING-SAFETY INJECTION SYSTEM-DETAILS — 9321-F-2616
CONTAINMENT BUILDING-RESIDUAL HEAT EXCHANGER PIPING-PLANS AND SECTIONS (SIS) — 9321-F-2562

SYMBOL IDENTIFICATION

- SUPPORT NUMBER
- FLANGE NUMBER, NUMBER OF BOLTS, AND BOLT DIAMETER
- VALVE NUMBER
- WELD NUMBER
- QUALITY GROUP CLASSIFICATION
- INTEGRAL SUPPORT WELD NUMBER

TYPICAL WELD DETAIL DRAWINGS
6" CLASS 2501, SCH 160 - D208015

ANSTEC APERTURE CARD

NOT FOR FABRICATION OR INSTALLATION

THIS DRAWING CONTAINS ITEMS WHICH MUST BE CONTROLLED WITHIN CON EDISON AS:
"CLASS A" ITEMS PER CI-240-1

Docket # 50-247
Accession # 9403110117
Date 2/28/94
Regulatory Docket File
of Ltr

REVISIONS

0 — THIS ISSUE IS NON-CLASS "A" PER CI 240-1. RELEASE FOR RECORD. P.N. 7076 11-3-78

1 — THIS REVISION IS NON-CLASS "A" PER CI-240.1. ADDED REF. DRAWING. ADDED LATEST REV. No TO REF. DWG'S. RELEASE FOR RECORD. P.N. 7076 RT/AS EBASCO SERVICES, INC. 1-10-80

2 — THIS REVISION IS NON CLASS "A" PER CI-240-1. ADDED LATEST REV. No TO REF. DWG'S. RELEASED FOR RECORD. P.N. 21368 TREADWELL CORP. 11-12-82.

3 — THIS REV. IS NON CLASS PER CI-240-1 CHANGED DISCIPLINE CODE FROM MJ TO ML. RELEASE FOR RECORD P.N. 69911-E1 AG

4 — THIS REVISION IS CLASS "A" PER CI-240-1 UPDATED DWG. PER AS BUILT INFORMATION AND SERVICE INSPECTION FIELD REVISION INFORMATION. RELEASED FOR RECORD P/N 69982-AD-4 NPS 12/17/93 AAA

NOT FOR FABRICATION OR INSTALLATION

B206908-4

CONSOLIDATED EDISON CO. OF NEW YORK, INC.

STATION LOCATION: INDIAN POINT NUMBER 2
INSERVICE INSPECTION ISOMETRIC OF SAFETY INJECTION SYSTEM
LINE No 358 INSIDE CONTAINMENT (RHR RETURN)

SCALE: NONE | DRAWN BY: C. ZAPATA | RECORDED: 11/21/78
P.N. 7076 | CHECKED BY: M. STEINAUER | ENG
DIAG | ELECT | MECH | STRUCT | DIST

APPROVALS: GENERAL ENGINEERING — CHIEF DESIGN ENGINEER; MECHANICAL ENGINEERING — MECH PLANT ENGINEER; CIVIL ENGINEERING — PLANT STRUCT ENGINEER; T & D STRUCT ENGINEER; ELECTRICAL ENGINEERING — STATION ELECT ENGINEER; T & D ENGINEER; GAS & STEAM OPERATIONS — STRUCT ENGINEER; PRODUCTION — CONVENTIONAL POWER; NUCLEAR POWER

ML

FORM 989D21