INDIAN POINT No 2	ISOMETRIC OF SAFETY INJECTION LINE # 155 PRIMARY AUX BLDG - SHT 1 OF 2	B206724

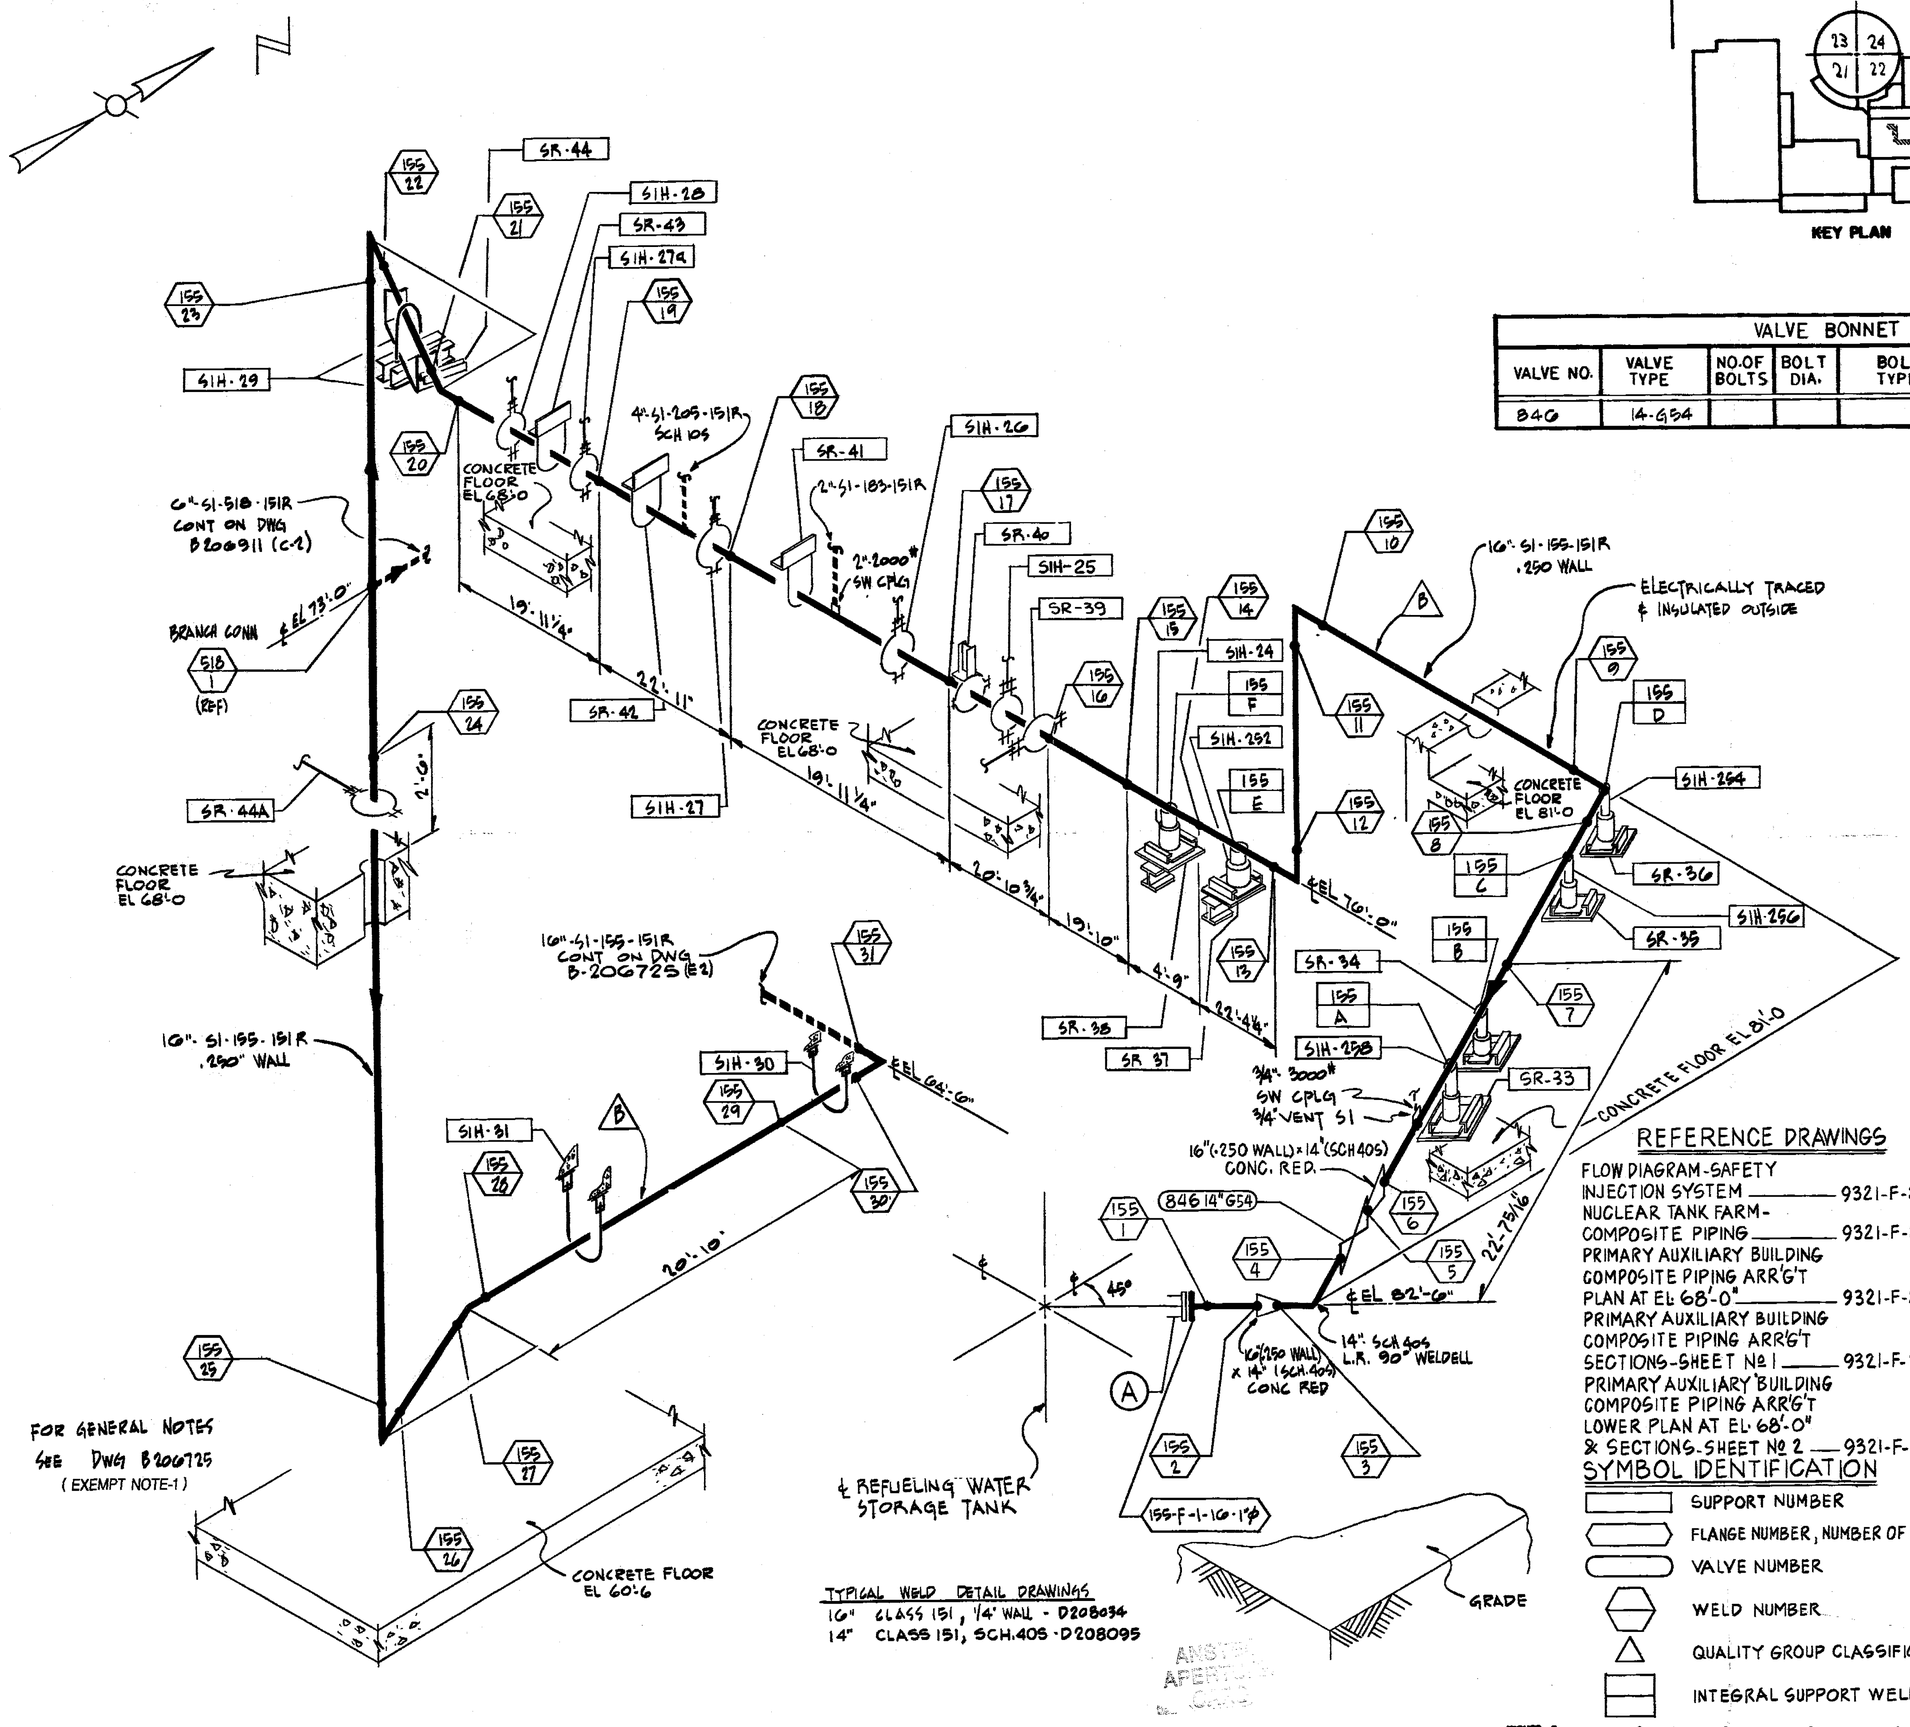

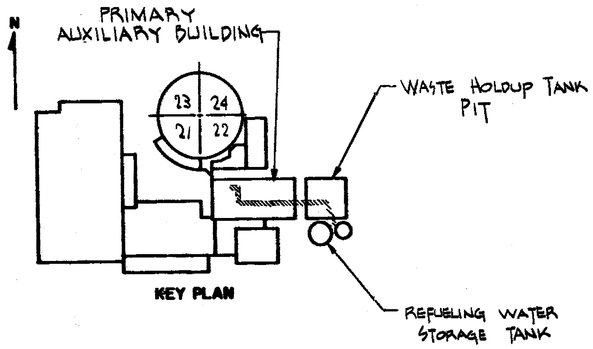

KEY PLAN

VALVE BONNET BOLTING						
VALVE NO.	VALVE TYPE	NO. OF BOLTS	BOLT DIA.	BOLT TYPE	VALVE MANUFACTURER	MANUFACTURER DWG. NO.
846	14-G54				DARLING	94-12168

NOT FOR FABRICATION OR INSTALLATION

THIS DRAWING CONTAINS ITEMS WHICH MUST BE CONTROLLED WITHIN CON EDISON AS:
"CLASS A" ITEMS PER CI-240-1

REFERENCE DRAWINGS

FLOW DIAGRAM-SAFETY
INJECTION SYSTEM ——— 9321-F-2735
NUCLEAR TANK FARM-
COMPOSITE PIPING ——— 9321-F-2633
PRIMARY AUXILIARY BUILDING
COMPOSITE PIPING ARR'G'T
PLAN AT EL 68'-0" ——— 9321-F-2570
PRIMARY AUXILIARY BUILDING
COMPOSITE PIPING ARR'G'T
SECTIONS-SHEET No 1 ——— 9321-F-2586
PRIMARY AUXILIARY BUILDING
COMPOSITE PIPING ARR'G'T
LOWER PLAN AT EL 68'-0"
& SECTIONS-SHEET No 2 ——— 9321-F-2587

SYMBOL IDENTIFICATION

- SUPPORT NUMBER
- FLANGE NUMBER, NUMBER OF BOLTS, & BOLT DIAMETER
- VALVE NUMBER
- WELD NUMBER
- QUALITY GROUP CLASSIFICATION
- INTEGRAL SUPPORT WELD NUMBER

TYPICAL WELD DETAIL DRAWINGS
16" CLASS 151, 1/4" WALL - D208034
14" CLASS 151, SCH.40S - D208095

Docket # 50-247
Accession # 9401311 0117
Date 1/28/94 of Ltr
Regulatory Docket File

REVISIONS

0 — 11-3-78 — THIS ISSUE IS NON-CLASS "A" PER CI240-1. RELEASE FOR RECORD. P.N. 7076 11-3-78

1 — THIS REVISION IS NON-CLASS "A" PER CI-240-1. ADDED REF. DRAWING. ADDED LATEST REV. No TO REF. DWG'S. RELEASE FOR RECORD. P.N. 7076 RT/AS EBASCO SERVICES, INC. 1-10-80

2 — THIS REVISION IS NON-CLASS "A" PER CI-240-1. ADDED LATEST REV. No. TO REF. DWG'S. RELOCATE SIH-30, SIH-31, SIH-25, SR-39. RELEASE FOR RECORD. P.N. 21368 TREADWELL CORP. 11-12-82.

3 — THIS REVISION IS NON-CLASS PER CI-240-1. CHANGED DISCIPLINE CODE FROM MJ TO ML. RELEASE FOR RECORD P.N. 69911-EJ A.G.

4 — THIS REVISION IS CLASS A PER CI-240-1 UPDATED DWG PER AS-BUILT INFORMATION AND SERVICE INSPECTION FIELD REVISION INFORMATION. RELEASED FOR RECORD P/N 69982-AD-4 NPS 12/17/93 AAA

NOT FOR FABRICATION OR INSTALLATION

B206724-4

CONSOLIDATED EDISON CO. OF NEW YORK, INC.

STATION LOCATION: INDIAN POINT No 2
INSERVICE INSPECTION
ISOMETRIC OF SAFETY INJECTION LINE No 2
155- PRIMARY AUXILIARY BUILDING
SHEET 1 OF 2

SCALE	DRAWN BY	RECORDED
NONE	P. DENE	11/6/78
P.N. 7076	CHECKED BY SIMONE	DWG
DWG.	SUBST.	MECH.	STRUCT.	SHEET

APPROVALS: GENERAL ENGINEERING — CHIEF DESIGN ENGINEER; MECHANICAL ENGINEERING — MECH. ENGINEER; CIVIL ENGINEERING — PLANT STRUCT. ENGINEER, T & D STRUCT. ENGINEER; ELECTRICAL ENGINEERING — STATION ELECT. ENGINEER, T & D ENGINEER; GAS & STEAM OPERATIONS — STRUCT. ENGINEER; PRODUCTION — CONVENTIONAL POWER, NUCLEAR POWER

ML