ISOMETRIC OF CVCS SEAL INJECTION LINE #44 INSIDE CONTAINMENT-SHT 1 of 2	INDIAN POINT N2	B206692

7		
THIS REVISION IS CLASS 'A' AS PER CI-240-1. UPDATED DWG AS PER IN-SERVICE INSPECTION FIELD REVISION INFORMATION RELEASED FOR RECORD		
P.N. 69982-AD-3 JM/BV 12/17/93		
ATOMETRICS INC.		
12/17/93	FCM	

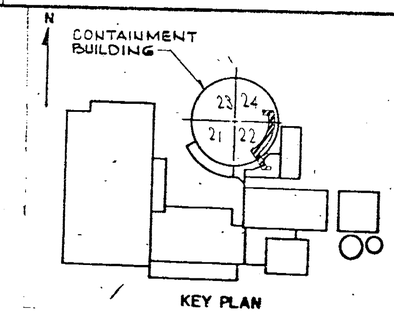

REVISIONS	
0	THIS ISSUE IS NON-CLASS "A" PER CI 240-1. RELEASE FOR RECORD. P.N. 7076 11-3-78
1	THIS REVISION IS NON-CLASS "A" PER CI-240-1. ADDED LATEST REV. Nº TO REF. DWG'S., RELEASE FOR RECORD. P.N. 7076 7076/AS EBASCO SERVICES, INC. 1-10-80
2	THIS REVISION IS NON-CLASS "A" PER CI-240-1. ADDED LATEST REV. Nº TO REF. DWG'S. RELEASE FOR RECORD. P.N. 21368, TREADWELL CORP 11-12-82
3	THIS REVISION IS NON-CLASS "A" PER CI-240-1. ADDED CONT. OF LINE 44 OUTSIDE CONTAINMENT TO CONNECTION WITH LINE NO. 41. P.N. 21368; TREADWELL CORP C.S./P.H. 2-4-83
4	THIS REVISION IS NON-CLASS 'A' PER CI-240-1. UPDATED DWG. PER INFORMATION FROM FIELD. RELEASE FOR RECORD. P.N. 21368 WB/RC. 5-1-84
5	THIS REVISION IS NON CLASS PER CI-240-1. UPDATED DWG. TO SHOW WORK OF MOD. PROC. MMS-80-2-05 RELEASE AS CONSTRUCTED. P.N. 90049.50 R.M./F.A. 4/29/85
6	THIS REV. IS NON CLASS PER CI-240-1 CHANGED DISC. CODE FROM MJ TO ML REL. FOR RECORD P/N 69911-E1

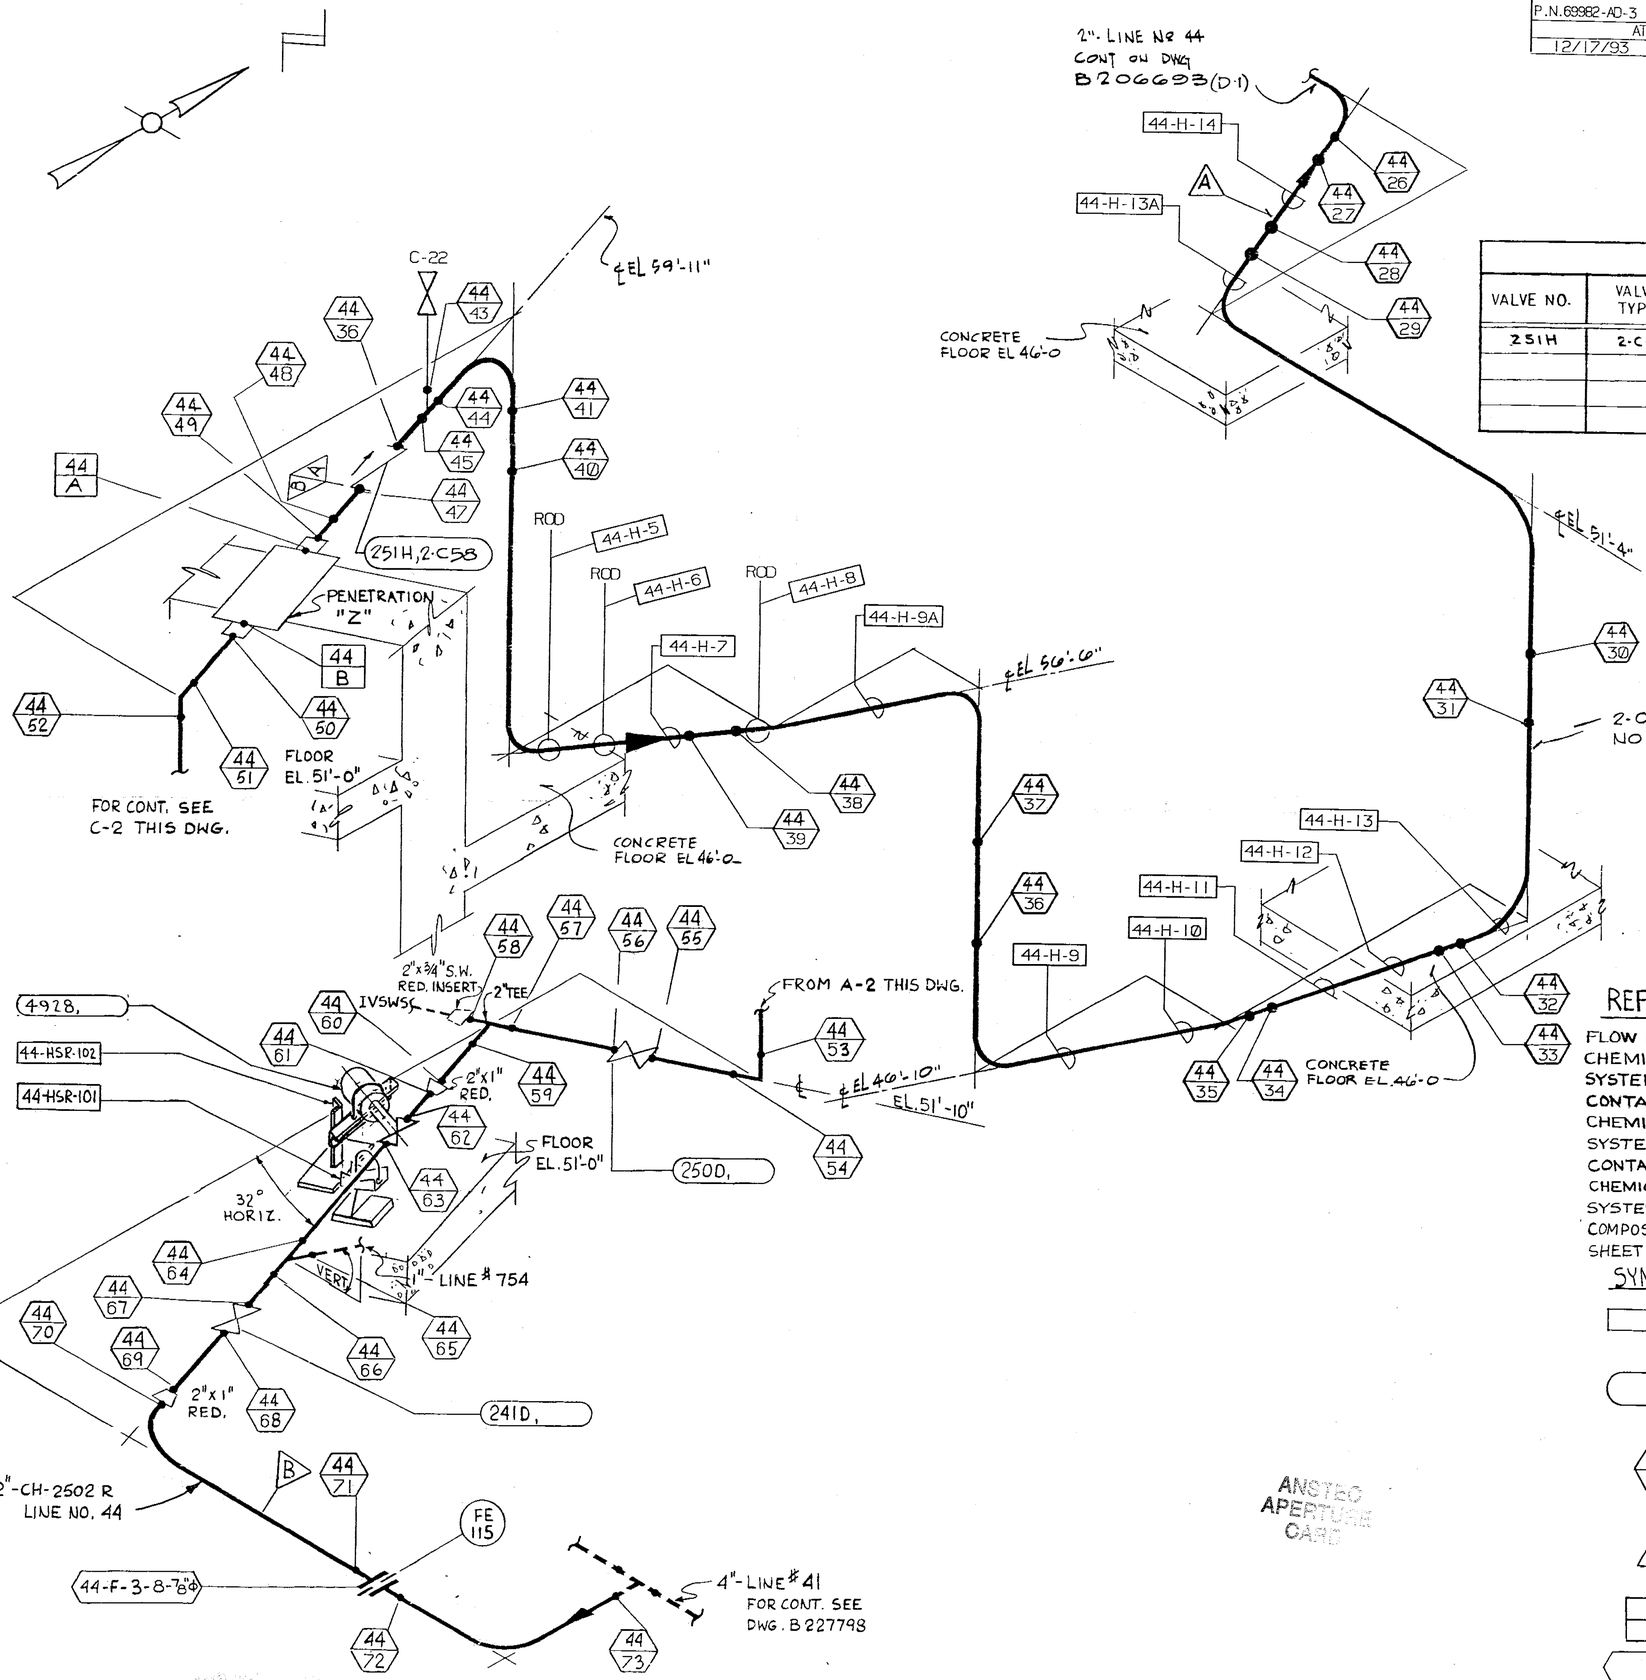

FOR GENERAL NOTES SEE DWG B 206687

NOT FOR FABRICATION OR INSTALLATION

THIS DRAWING CONTAINS ITEMS WHICH MUST BE CONTROLLED WITHIN CON EDISON AS:
"CLASS A" ITEMS PER CI-240-1

VALVE BONNET BOLTING

VALVE NO.	VALVE TYPE	NO. OF BOLTS	BOLT DIA.	BOLT TYPE	VALVE MANUFACTURER	MANUFACTURER DWG. NO.
251H	2-C58	NONE	N.A.	N.A.	ROCKWELL-EDWARDS	C-70819

REFERENCE DRAWINGS

FLOW DIAGRAM
CHEMICAL & VOLUME CONTROL
SYSTEM - SHEET NO. 1 ——— A208168
CONTAINMENT BUILDING
CHEMICAL & VOLUME CONTROL
SYSTEM - SHEET NO. 1 ——— 9321-F-2581
CONTAINMENT BUILDING
CHEMICAL & VOLUME CONTROL
SYSTEM - SHEET NO. 2 ——— 9321-F-2582
COMPOSITE PIPING IN TRENCHES
SHEET NO. 2 ——— 9321-F-2678

SYMBOL IDENTIFICATION

- SUPPORT NUMBER
- VALVE NUMBER
- WELD NUMBER
- QUALITY GROUP CLASSIFICATION
- INTEGRAL SUPPORT WELD NUMBER
- FLANGE NO. NUMBER OF BOLTS AND BOLT DIAMETER

INCHES 0 1 2 3 4 5 6

Docket # 50-247
Accession # 9403110117
Date 2/28/94
Regulatory Docket File

ANSTEC APERTURE CARD

NOT FOR FABRICATION OR INSTALLATION

B206692-7

CONSOLIDATED EDISON CO.
OF NEW YORK, INC.

STATION LOCATION: INDIAN POINT Nº 2
INSERVICE INSPECTION
ISOMETRIC OF CVCS SEAL INJECTION
LINE Nº 44 - INSIDE & OUTSIDE CONTAINMENT

SCALE	DRAWN BY	RECORDED
NONE	P. DENE	
P.N. 7076	CHECKED BY M. STEINAUER	END
DIAG / ELECT / MECH	STRUCT / DIST	

APPROVALS

GENERAL ENGINEERING	CHIEF DESIGN ENGINEER	John J. Lawrence 11/8/84
MECHANICAL ENGINEERING	MECH PLANT ENGINEER	
CIVIL ENGINEERING	PLANT STRUCT ENGINEER	
	T & D STRUCT ENGINEER	
ELECTRICAL ENGINEERING	STATION ELECT ENGINEER	
	T & D ENGINEER	
GAS & STEAM OPERATIONS	STRUCT ENGINEER	
PRODUCTION	CONVENTIONAL POWER	
	NUCLEAR POWER	

ML

FORM 929D21