ISOMETRIC OF SAFETY INJECTION LINE Nº 56	INDIAN POINT Nº2
SHEET 1 OF 5	B-206698

VALVE BONNET BOLTING

VALVE NO.	VALVE TYPE	NO. OF BOLTS	BOLT DIA.	BOLT TYPE	VALVE MANUFACTURER	MANUFACTURER DWG. NO.
850A	4-C57Y					
849A	4-C57					

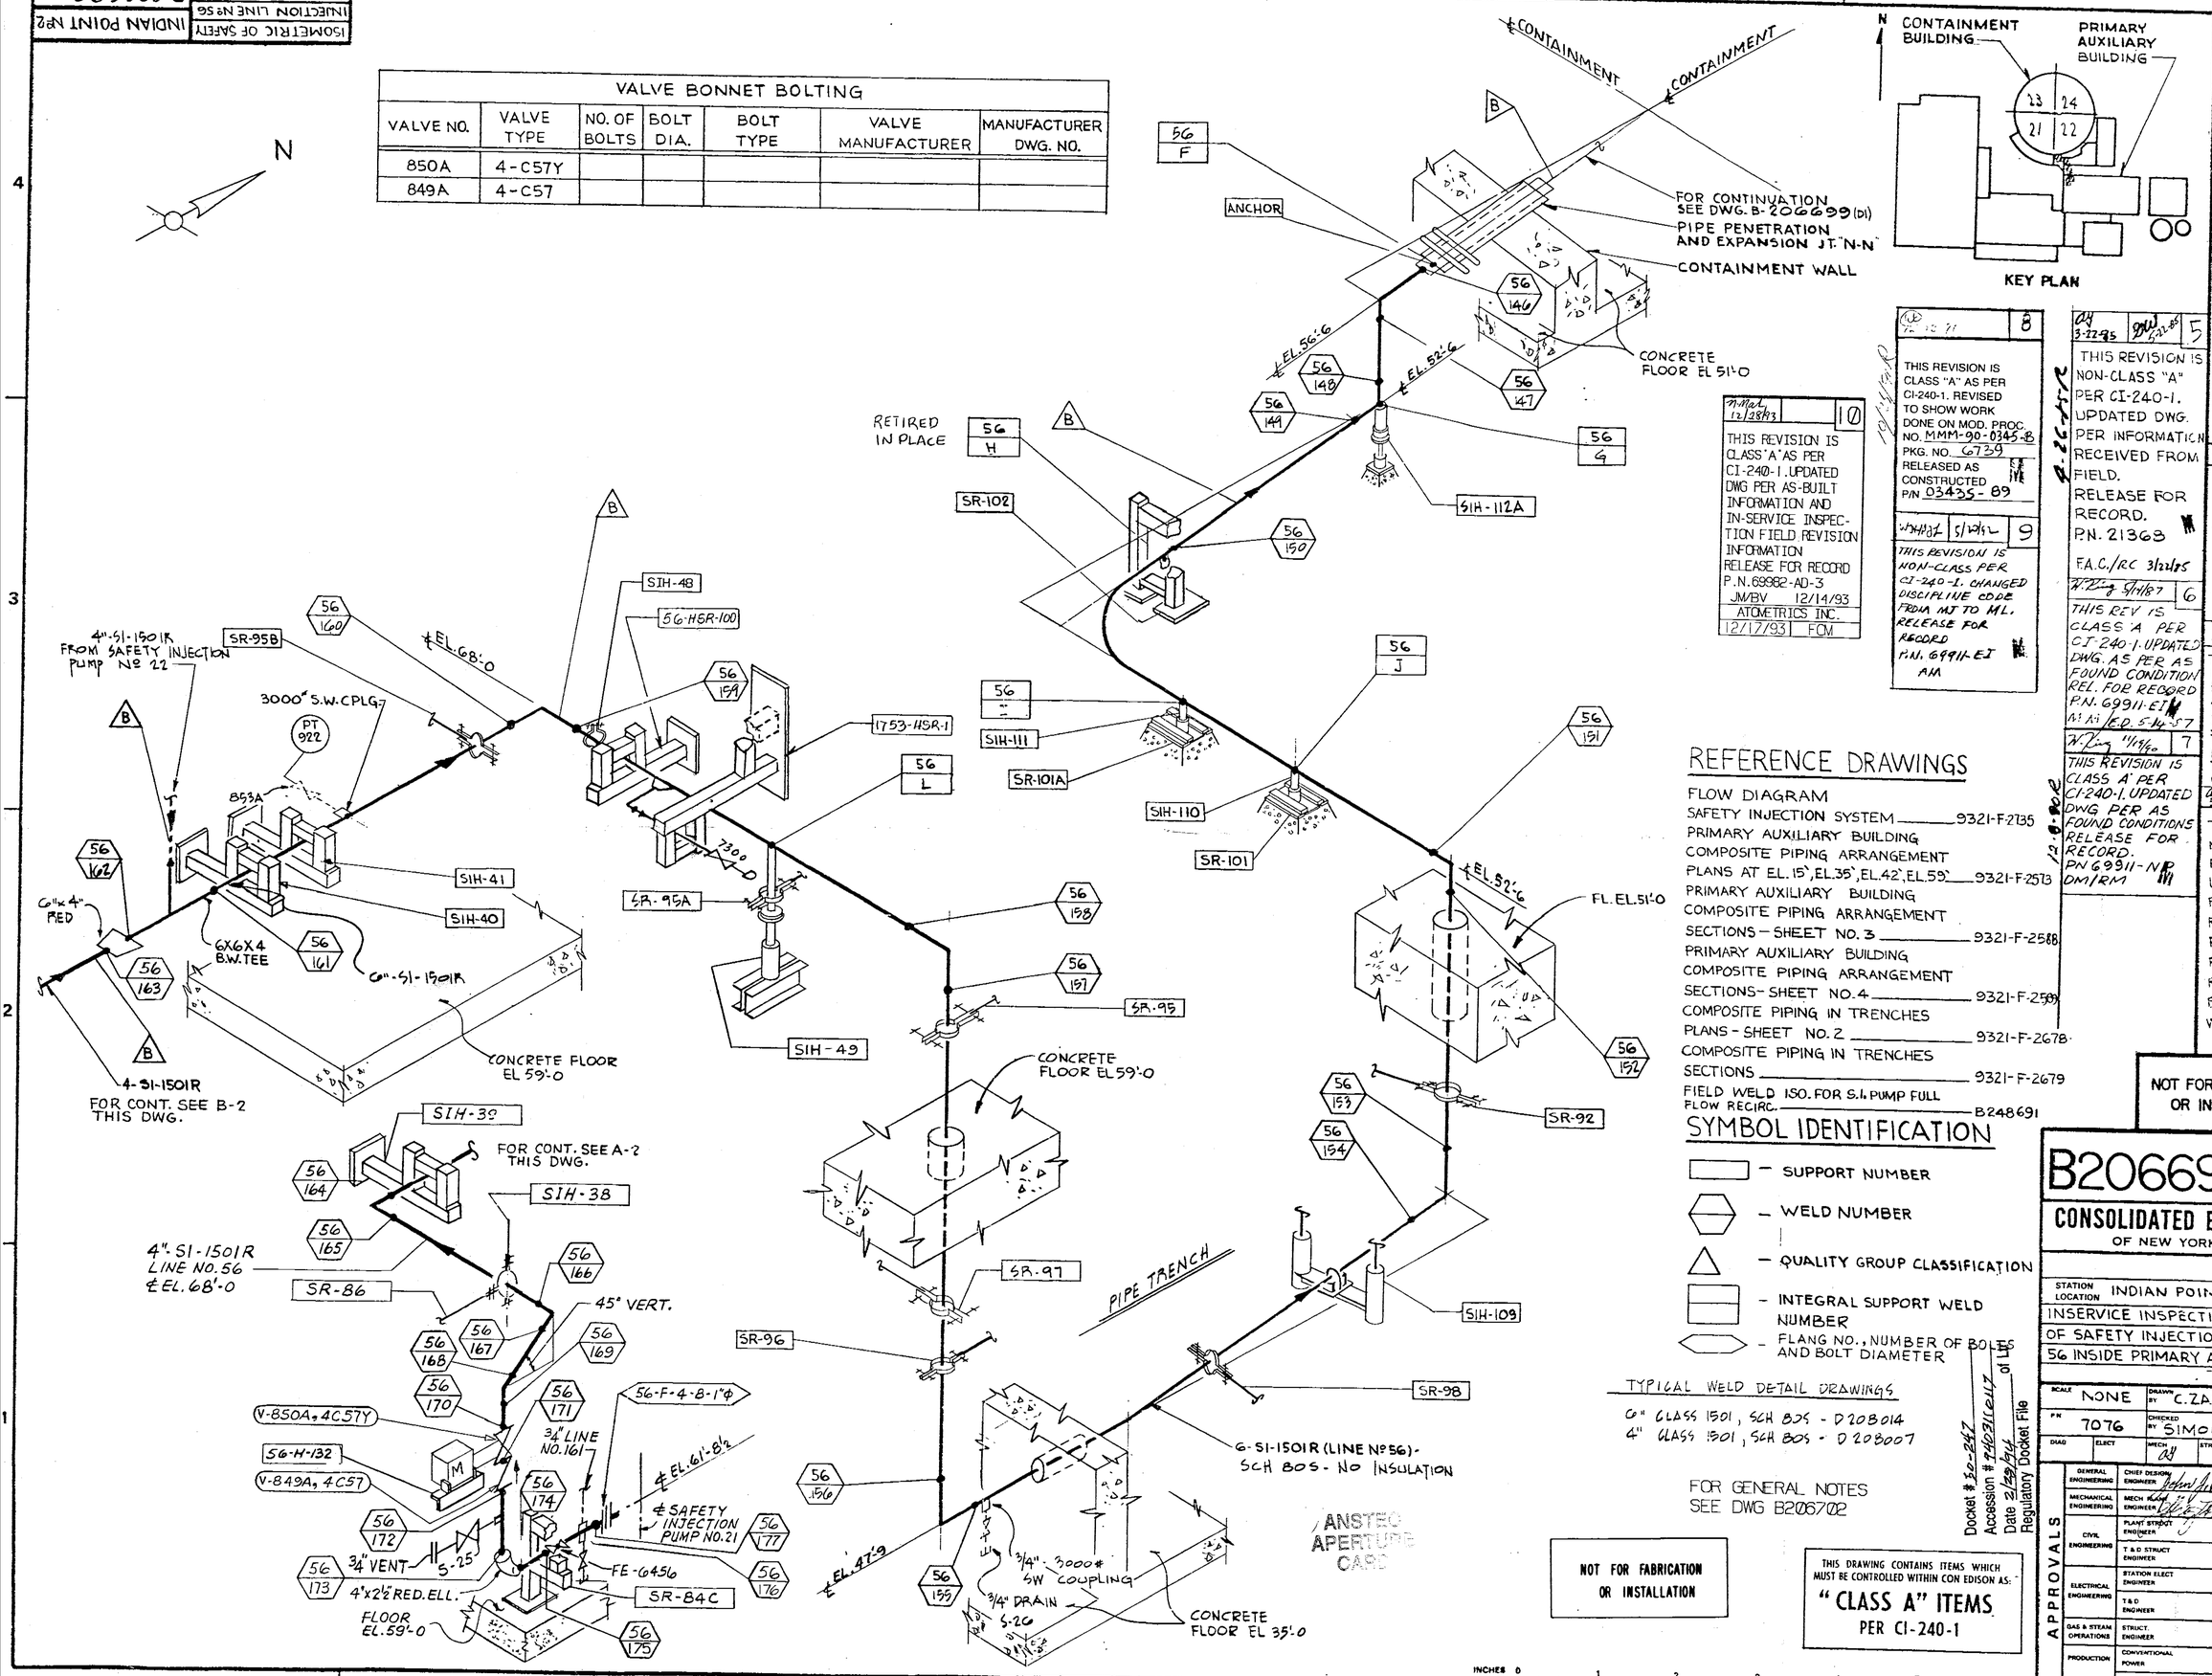

REFERENCE DRAWINGS

FLOW DIAGRAM
SAFETY INJECTION SYSTEM ____ 9321-F-2735
PRIMARY AUXILIARY BUILDING
COMPOSITE PIPING ARRANGEMENT
PLANS AT EL. 15', EL. 35', EL. 42', EL. 59' ____ 9321-F-2573
PRIMARY AUXILIARY BUILDING
COMPOSITE PIPING ARRANGEMENT
SECTIONS – SHEET NO. 3 ____ 9321-F-2588
PRIMARY AUXILIARY BUILDING
COMPOSITE PIPING ARRANGEMENT
SECTIONS – SHEET NO. 4 ____ 9321-F-2589
COMPOSITE PIPING IN TRENCHES
PLANS – SHEET NO. 2 ____ 9321-F-2678
COMPOSITE PIPING IN TRENCHES
SECTIONS ____ 9321-F-2679
FIELD WELD ISO. FOR S.I. PUMP FULL FLOW RECIRC. ____ B248691

SYMBOL IDENTIFICATION

- SUPPORT NUMBER
- WELD NUMBER
- QUALITY GROUP CLASSIFICATION
- INTEGRAL SUPPORT WELD NUMBER
- FLANG NO., NUMBER OF BOLTS AND BOLT DIAMETER

TYPICAL WELD DETAIL DRAWINGS
6" CLASS 1501, SCH 80S - D208014
4" CLASS 1501, SCH 80S - D208007

FOR GENERAL NOTES SEE DWG B2067702

NOT FOR FABRICATION OR INSTALLATION

THIS DRAWING CONTAINS ITEMS WHICH MUST BE CONTROLLED WITHIN CON EDISON AS:
"CLASS A" ITEMS PER CI-240-1

Docket # 50-247
Accession # 7403110117
Date 2/29/74
Regulatory Docket File

REVISIONS

0 — THIS ISSUE IS NON-CLASS "A" PER CI 240-1 RELEASE FOR RECORD. P.N. 7076 11-3-78

1 — THIS REVISION IS NON-CLASS "A" PER CI-240-1 ADDED REF. DRAWINGS. ADDED LATEST REV. Nº TO REF. DWG'S. RELEASE FOR RECORD. PN 7076 7076/AS EBASCO SERVICES, INC. 1-10-80

2 — THIS REVISION IS NON-CLASS "A" PER CI-240-1. ADDED LATEST REV. Nº TO REF. DWG'S. RELEASE FOR RECORD. P.N. 21368, TREADWELL CORP. 11-12-82

3 — THIS ISSUE IS NON-CLASS "A" PER CI-240-1. ADDED CONT. OF LINE NO. 56 TO SAFETY INJECTION PUMP #21 P.N. 21368 TREADWELL CORP. C.S./P.H. 2-4-83

4 — THIS REVISION IS NON-CLASS "A" PER CI-240-1. UPDATED DWG. PER INFORMATION RECEIVED FROM FIELD. RELEASE FOR RECORD. P.N. 21368 VB/RC 5-1-84


6 — THIS REV IS CLASS A PER CI-240-1. UPDATED DWG. AS PER AS FOUND CONDITION REL. FOR RECORD P.N. 69911-EI AM

7 — THIS REVISION IS CLASS A PER CI-240-1. UPDATED DWG PER AS FOUND CONDITIONS RELEASE FOR RECORD. PN 69911-NP DM/RM

8 — THIS REVISION IS CLASS "A" AS PER CI-240-1. REVISED TO SHOW WORK DONE ON MOD. PROC. NO. MMM-90-0345-B PKG. NO. 6739 RELEASED AS CONSTRUCTED P/N 03435-89

9 — THIS REVISION IS NON-CLASS PER CI-240-1. CHANGED DISCIPLINE CODE FROM MT TO ML. RELEASE FOR RECORD P.N. 69911-EI AM

10 — THIS REVISION IS CLASS "A" AS PER CI-240-1. UPDATED DWG PER AS-BUILT INFORMATION AND IN-SERVICE INSPECTION FIELD REVISION INFORMATION RELEASE FOR RECORD P.N. 69982-AD-3 JM/BV 12/14/93 ATOMETRICS INC. 12/17/93 FCM

NOT FOR FABRICATION OR INSTALLATION

B206698-10

CONSOLIDATED EDISON CO.
OF NEW YORK, INC.

STATION LOCATION: INDIAN POINT Nº 2
INSERVICE INSPECTION ISOMETRIC OF SAFETY INJECTION LINE Nº 56 INSIDE PRIMARY AUX. BLDG.

SCALE	DRAWN BY	RECORDED
NONE	C. ZAPATA	
P.N. 7076	CHECKED BY SIMONE	ENG
DIAG / ELECT / MECH	STRUCT	CHIEF

APPROVALS

GENERAL ENGINEERING	CHIEF DESIGN ENGINEER	
MECHANICAL ENGINEERING	MECH ENGINEER	
	PLANT STRUCT ENGINEER	
CIVIL ENGINEERING	T & D STRUCT ENGINEER	
ELECTRICAL ENGINEERING	STATION ELECT ENGINEER	
	T & D ENGINEER	
GAS & STEAM OPERATIONS	STRUCT. ENGINEER	
PRODUCTION	CONVENTIONAL POWER	
	NUCLEAR POWER	

ML