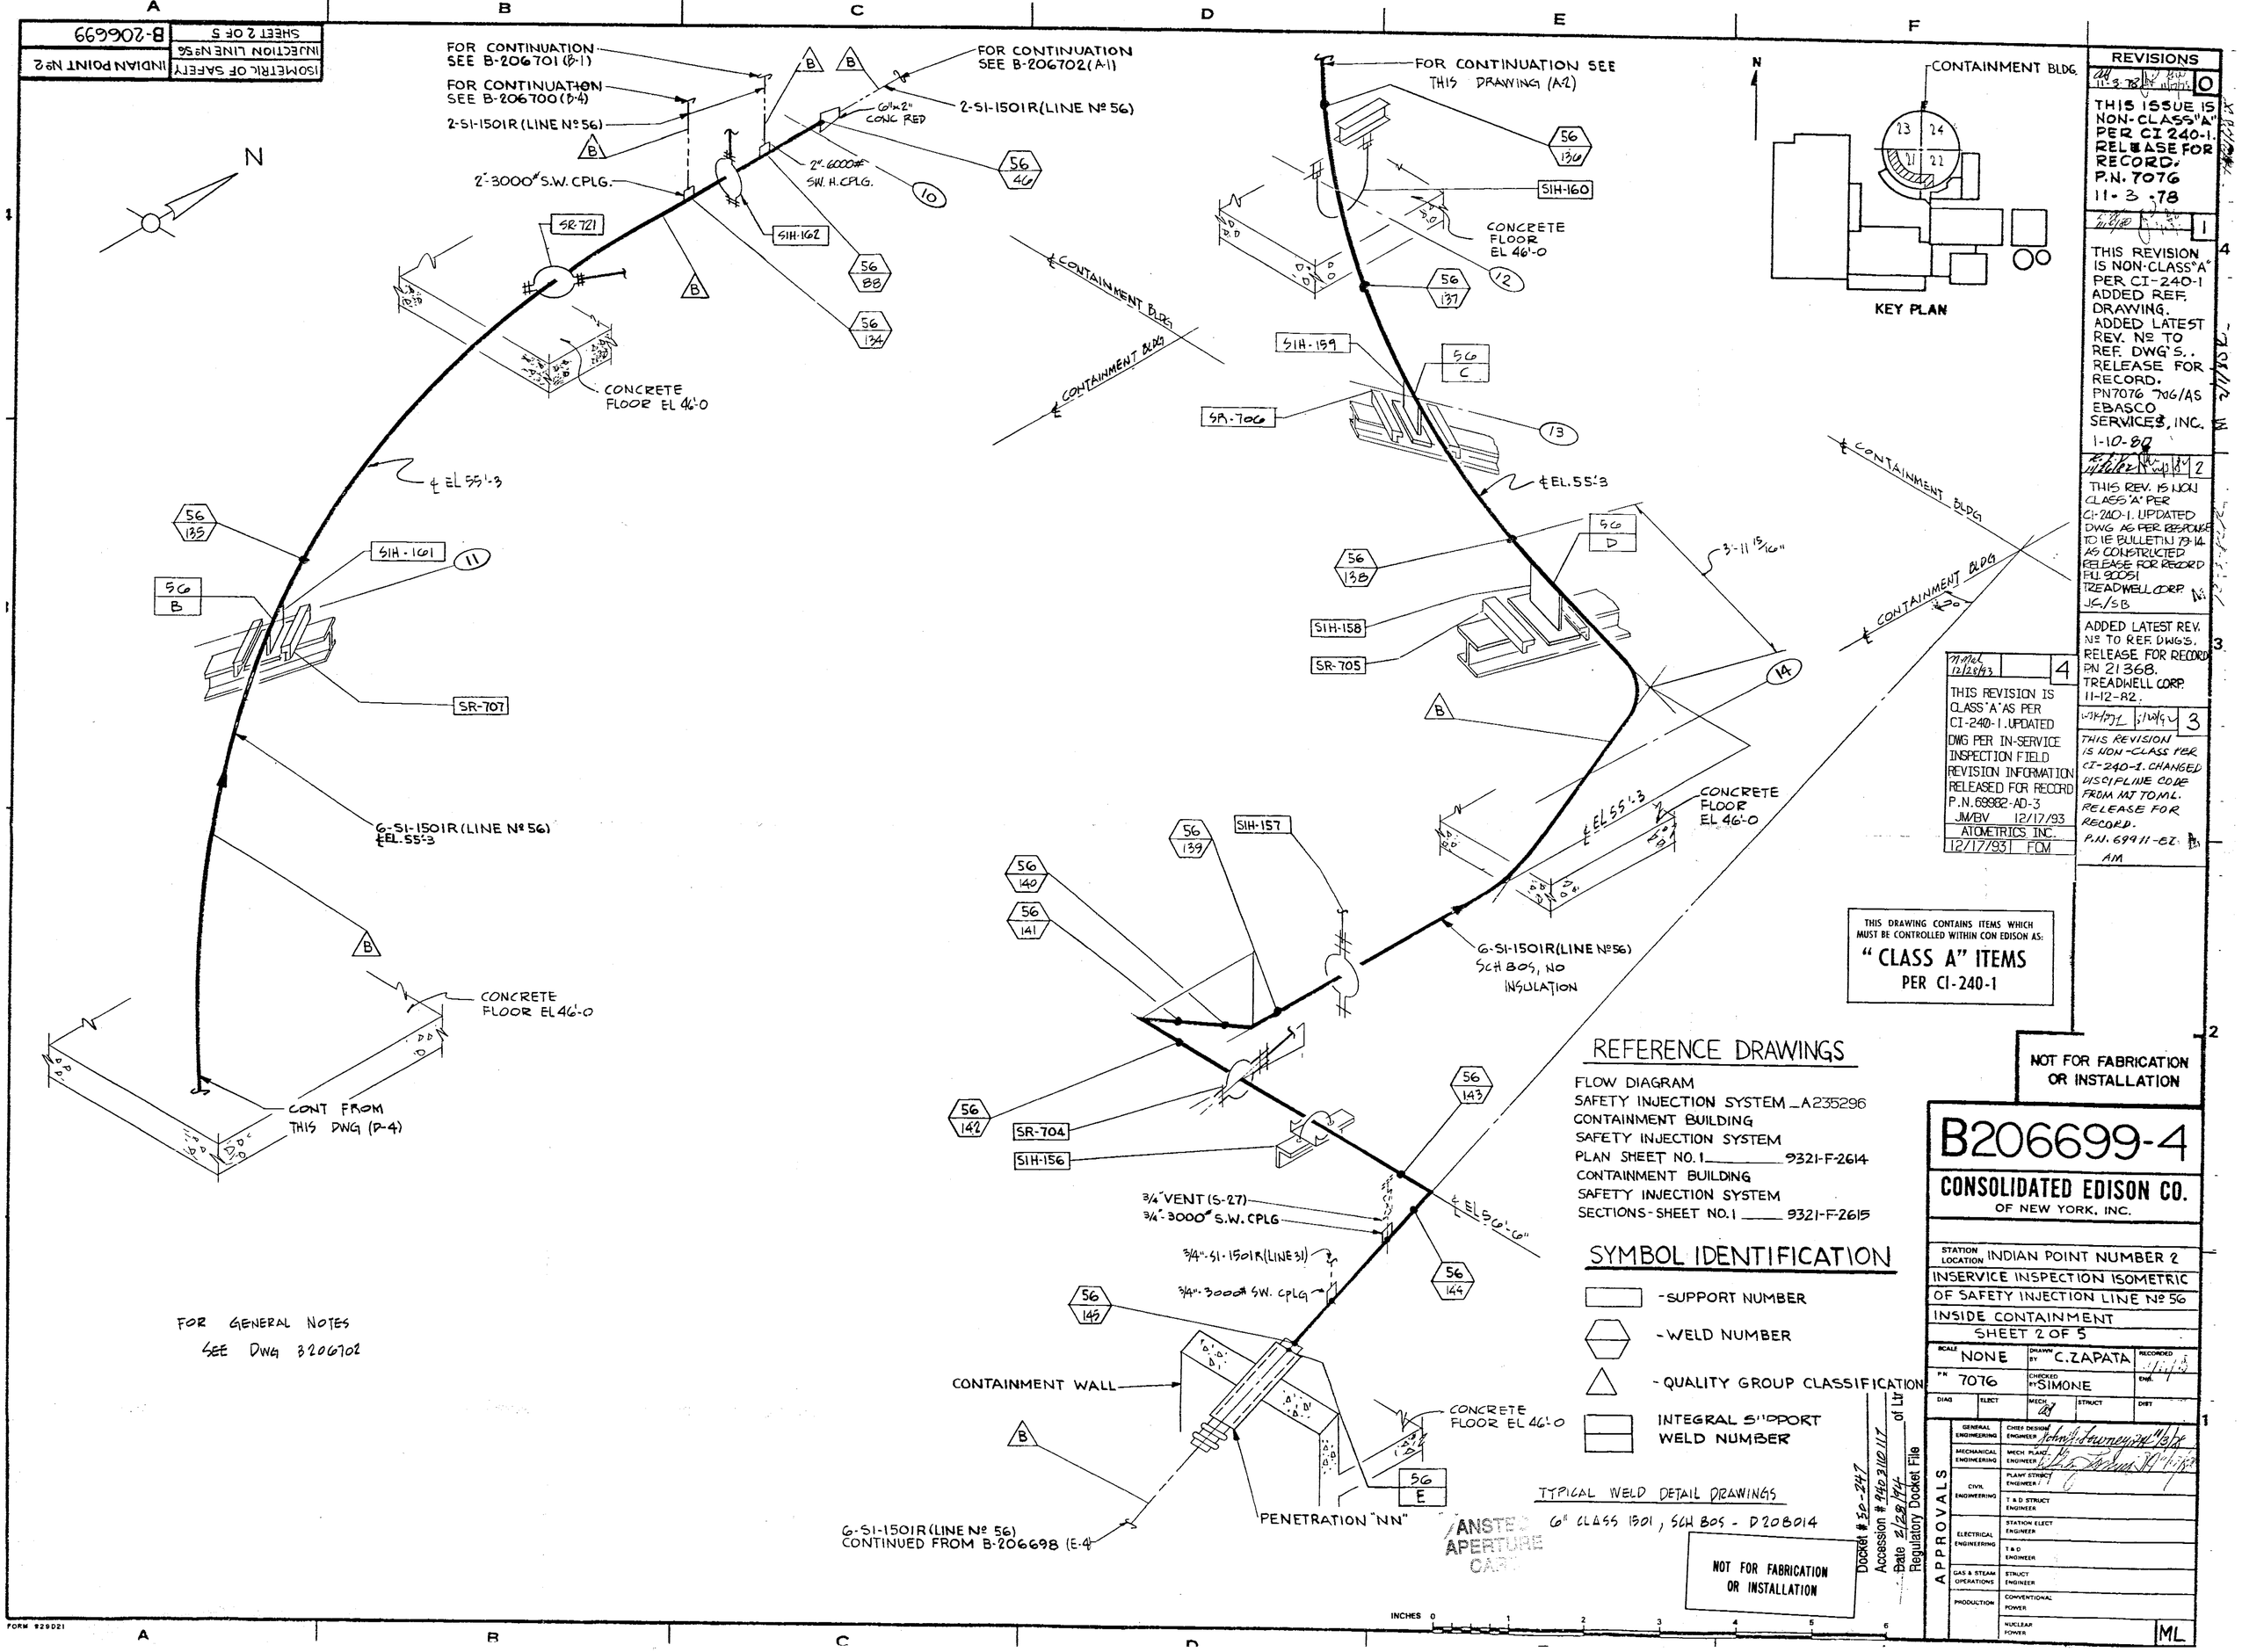

ISOMETRIC OF SAFETY INJECTION LINE Nº 56
INDIAN POINT Nº 2
SHEET 2 OF 5
B-206699
FOR CONTINUATION SEE B-206701 (B-1)
FOR CONTINUATION SEE B-206700 (B-4)
2-SI-1501R (LINE Nº 56)
2"-3000# S.W. CPLG.
FOR CONTINUATION SEE B-206702 (A-1)
2-SI-1501R (LINE Nº 56)
6"x2" CONC RED
2"-6000# SW. H. CPLG.
SR-721
SIH-162
CONCRETE FLOOR EL 46'-0
℄ EL 55'-3
SIH-161
SR-707
6-SI-1501R (LINE Nº 56) ℄ EL. 55'-3
CONCRETE FLOOR EL 46'-0
CONT FROM THIS DWG (D-4)
FOR GENERAL NOTES SEE DWG B206702
FOR CONTINUATION SEE THIS DRAWING (A-2)
SIH-160
CONCRETE FLOOR EL 46'-0
SIH-159
SR-706
℄ EL. 55'-3
SIH-158
SR-705
3'-11 15/16"
CONCRETE FLOOR EL 46'-0
SIH-157
6-SI-1501R (LINE Nº 56) SCH 80S, NO INSULATION
SR-704
SIH-156
3/4" VENT (S-27)
3/4"-3000# S.W. CPLG
3/4"-SI-1501R (LINE 31)
3/4"-3000# SW. CPLG
℄ EL 56'-6"
CONTAINMENT WALL
CONCRETE FLOOR EL 46'-0
PENETRATION "NN"
6-SI-1501R (LINE Nº 56) CONTINUED FROM B-206698 (E-4)
℄ CONTAINMENT BLDG
CONTAINMENT BLDG
KEY PLAN
REFERENCE DRAWINGS
FLOW DIAGRAM
SAFETY INJECTION SYSTEM _ A235296
CONTAINMENT BUILDING
SAFETY INJECTION SYSTEM
PLAN SHEET NO. 1 _____ 9321-F-2614
CONTAINMENT BUILDING
SAFETY INJECTION SYSTEM
SECTIONS - SHEET NO. 1 _____ 9321-F-2615
SYMBOL IDENTIFICATION
- SUPPORT NUMBER
- WELD NUMBER
- QUALITY GROUP CLASSIFICATION
INTEGRAL SUPPORT WELD NUMBER
TYPICAL WELD DETAIL DRAWINGS
6" CLASS 1501, SCH 80S - D208014
ANSTEC APERTURE CARD
NOT FOR FABRICATION OR INSTALLATION
REVISIONS
THIS ISSUE IS NON-CLASS "A" PER CI 240-1. RELEASE FOR RECORD. P.N. 7076 11-3-78
THIS REVISION IS NON-CLASS "A" PER CI-240-1 ADDED REF. DRAWING. ADDED LATEST REV. Nº TO REF. DWG'S. RELEASE FOR RECORD. PN7076 7076/AS EBASCO SERVICES, INC. 1-10-80
THIS REV. IS NON CLASS 'A' PER CI-240-1. UPDATED DWG AS PER RESPONSE TO IE BULLETIN 79-14 AS CONSTRUCTED RELEASE FOR RECORD P.N. 90051 TREADWELL CORP. JC/SB
ADDED LATEST REV. Nº TO REF. DWG'S. RELEASE FOR RECORD PN 21368. TREADWELL CORP. 11-12-82.
THIS REVISION IS CLASS 'A' AS PER CI-240-1. UPDATED DWG PER IN-SERVICE INSPECTION FIELD REVISION INFORMATION RELEASED FOR RECORD P.N. 69982-AD-3 JM/BV 12/17/93 ATOMETRICS INC. 12/17/93 FCM
THIS REVISION IS NON-CLASS PER CI-240-1. CHANGED DISCIPLINE CODE FROM MT TO ML. RELEASE FOR RECORD. P.N. 69911-EZ AM
THIS DRAWING CONTAINS ITEMS WHICH MUST BE CONTROLLED WITHIN CON EDISON AS: "CLASS A" ITEMS PER CI-240-1
NOT FOR FABRICATION OR INSTALLATION
B206699-4
CONSOLIDATED EDISON CO. OF NEW YORK, INC.
STATION LOCATION INDIAN POINT NUMBER 2
INSERVICE INSPECTION ISOMETRIC OF SAFETY INJECTION LINE Nº 56 INSIDE CONTAINMENT
SHEET 2 OF 5
SCALE NONE
DRAWN BY C. ZAPATA
P.N. 7076
CHECKED BY SIMONE
APPROVALS
GENERAL ENGINEERING
MECHANICAL ENGINEERING
CIVIL ENGINEERING
ELECTRICAL ENGINEERING
GAS & STEAM OPERATIONS
PRODUCTION
CHIEF DESIGN ENGINEER
MECH PLANT ENGINEER
PLANT STRUCT ENGINEER
T & D STRUCT ENGINEER
STATION ELECT ENGINEER
T & D ENGINEER
STRUCT ENGINEER
CONVENTIONAL POWER
NUCLEAR POWER
ML
Docket # 50-247
Accession # 9403110117
Date 2/28/94
Regulatory Docket File