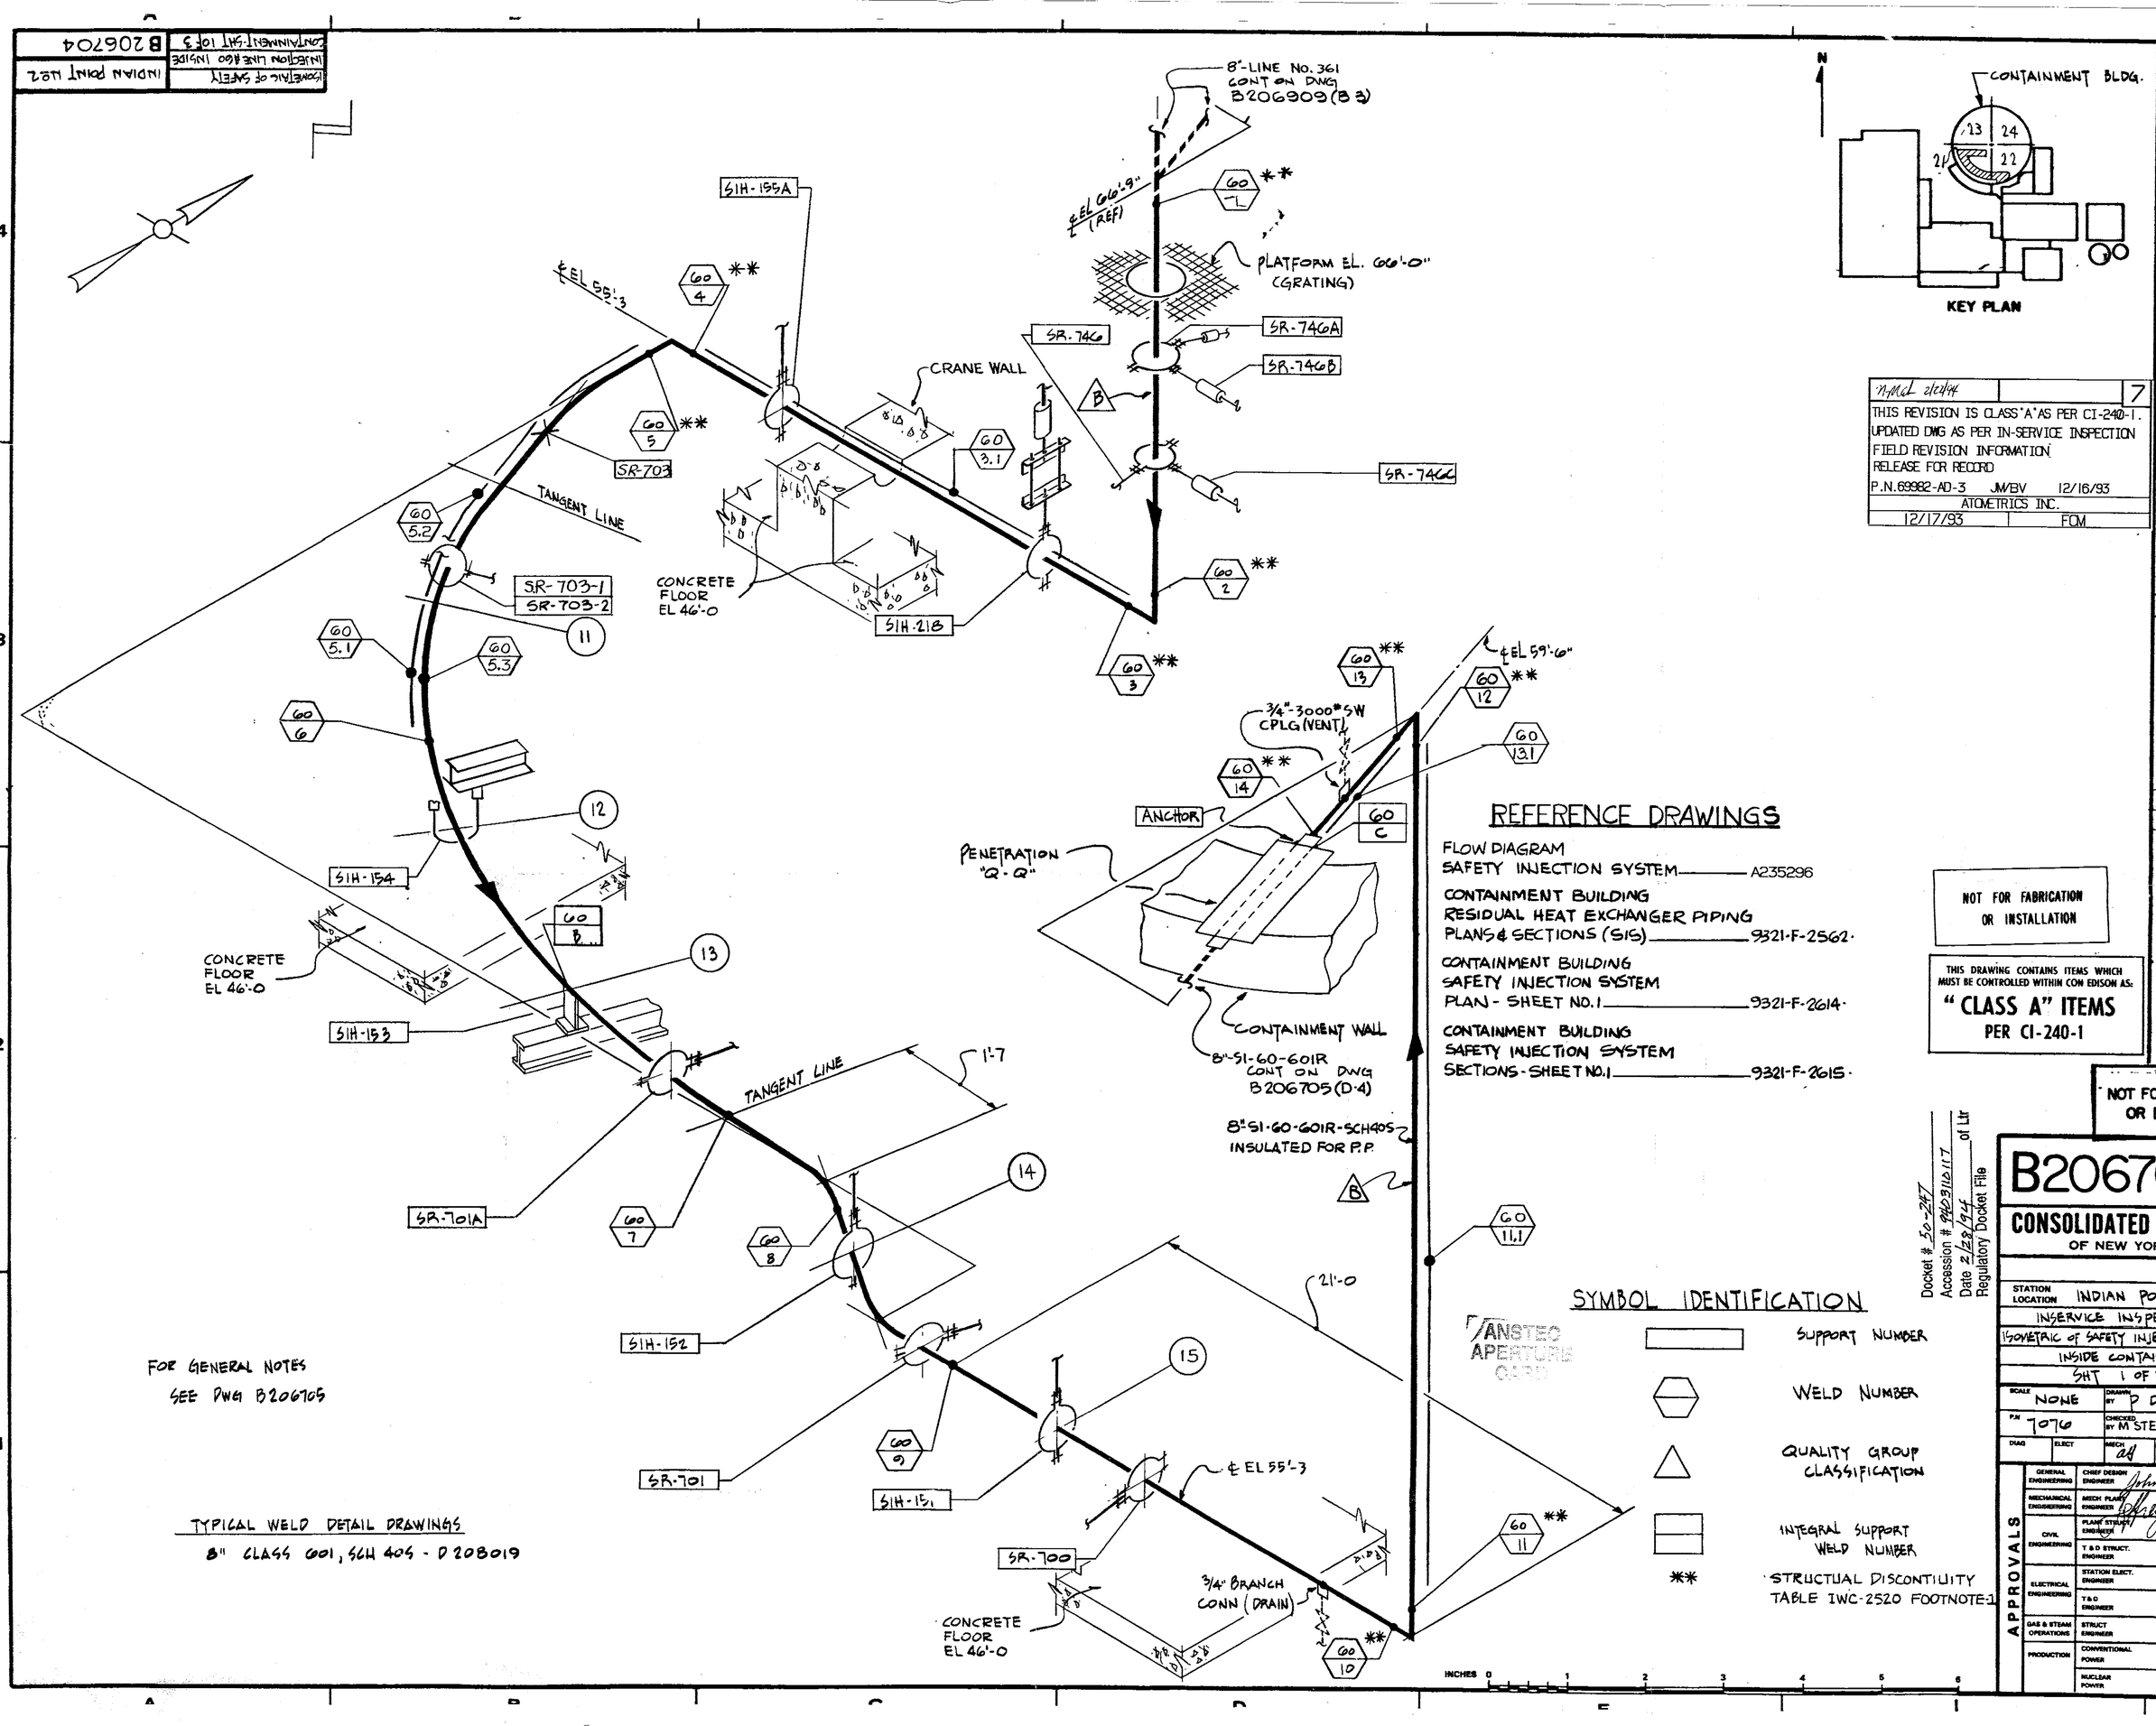

FOR GENERAL NOTES
SEE DWG B206705

TYPICAL WELD DETAIL DRAWINGS
8" CLASS 601, SCH 40S - D208019

KEY PLAN

REFERENCE DRAWINGS

FLOW DIAGRAM
SAFETY INJECTION SYSTEM ——— A235296

CONTAINMENT BUILDING
RESIDUAL HEAT EXCHANGER PIPING
PLANS & SECTIONS (SIS) ——— 9321-F-2562

CONTAINMENT BUILDING
SAFETY INJECTION SYSTEM
PLAN - SHEET NO. 1 ——— 9321-F-2614

CONTAINMENT BUILDING
SAFETY INJECTION SYSTEM
SECTIONS - SHEET NO. 1 ——— 9321-F-2615

SYMBOL IDENTIFICATION

- SUPPORT NUMBER
- WELD NUMBER
- QUALITY GROUP CLASSIFICATION
- INTEGRAL SUPPORT WELD NUMBER
- ** STRUCTUAL DISCONTINUITY TABLE IWC-2520 FOOTNOTE-1

ANSTEC APERTURE CARD

NOT FOR FABRICATION OR INSTALLATION

THIS DRAWING CONTAINS ITEMS WHICH MUST BE CONTROLLED WITHIN CON EDISON AS:
"CLASS A" ITEMS
PER CI-240-1

NOT FOR FABRICATION OR INSTALLATION

Docket # 50-247
Accession # 9403110117
Date 2/28/94 of Ltr
Regulatory Docket File

REVISIONS

0 — THIS ISSUE IS NON-CLASS "A" PER CI 240-1. RELEASE FOR RECORD. P.N. 7076 11-3-78

4 — THIS REVISION IS NON CLASS PER CI-240-1 UPDATED DWG PER AS FOUND CONDITION PKG # 6928 RELEASE FOR RECORD P.N 69911-CI LWS/KE

5 — THIS REVISION IS NON-CLASS PER CI-240-1. CHANGED DISCIPLINE CODE FROM MT TO ML. RELEASE FOR RECORD. P.N. 69911-E AM

6 — THIS REVISION IS CLASS "A" PER CI-240-1 REVISED TO SHOW WORK DONE ON IND. PT PKG. N° 7441 RELEASED AS BUILT P.N. 69911-CI ET/DB 7/29/92

ATOMETRICS, INC. 11/19/92 FCM

7 — THIS REVISION IS CLASS "A" AS PER CI-240-1. UPDATED DWG AS PER IN-SERVICE INSPECTION FIELD REVISION INFORMATION RELEASE FOR RECORD P.N. 69982-AD-3 JM/BV 12/16/93

ATOMETRICS INC. 12/17/93 FCM

B206704-7

CONSOLIDATED EDISON CO.
OF NEW YORK, INC.

STATION LOCATION: INDIAN POINT N°2
INSERVICE INSPECTION
ISOMETRIC OF SAFETY INJECTION-LINE N° 60
INSIDE CONTAINMENT
SHT 1 OF 3

SCALE	DRAWN BY	RECORDED
NONE	P DENE	1/4/78
P.N. 7076	CHECKED BY M STEINAUER	ENG.
DIAG / ELECT	MECH / STRUCT	DIST

APPROVALS

GENERAL ENGINEERING	CHIEF DESIGN ENGINEER	John J. Sloconey 11/3/78
MECHANICAL ENGINEERING	MECH PLANT ENGINEER	[signature] 11/17/78
CIVIL ENGINEERING	PLANT STRUCT. ENGINEER	
	T & D STRUCT. ENGINEER	
ELECTRICAL ENGINEERING	STATION ELECT. ENGINEER	
	T & D ENGINEER	
GAS & STEAM OPERATIONS	STRUCT ENGINEER	
PRODUCTION	CONVENTIONAL POWER	
	NUCLEAR POWER	ML

ISOMETRIC OF SAFETY INJECTION LINE #60 INSIDE CONTAINMENT-SHT 1 OF 3 — INDIAN POINT N°2 — B206704