VALVE BONNET BOLTING

VALVE NO.	VALVE TYPE	NO. OF BOLTS	BOLT DIA.	BOLT TYPE	VALVE MANUFACTURER	MANUFACTURER DWG. NO.
PCV-455B	BALL				FISHER GOVENER	
4154	GATE				WESTINGHOUSE	8372D38

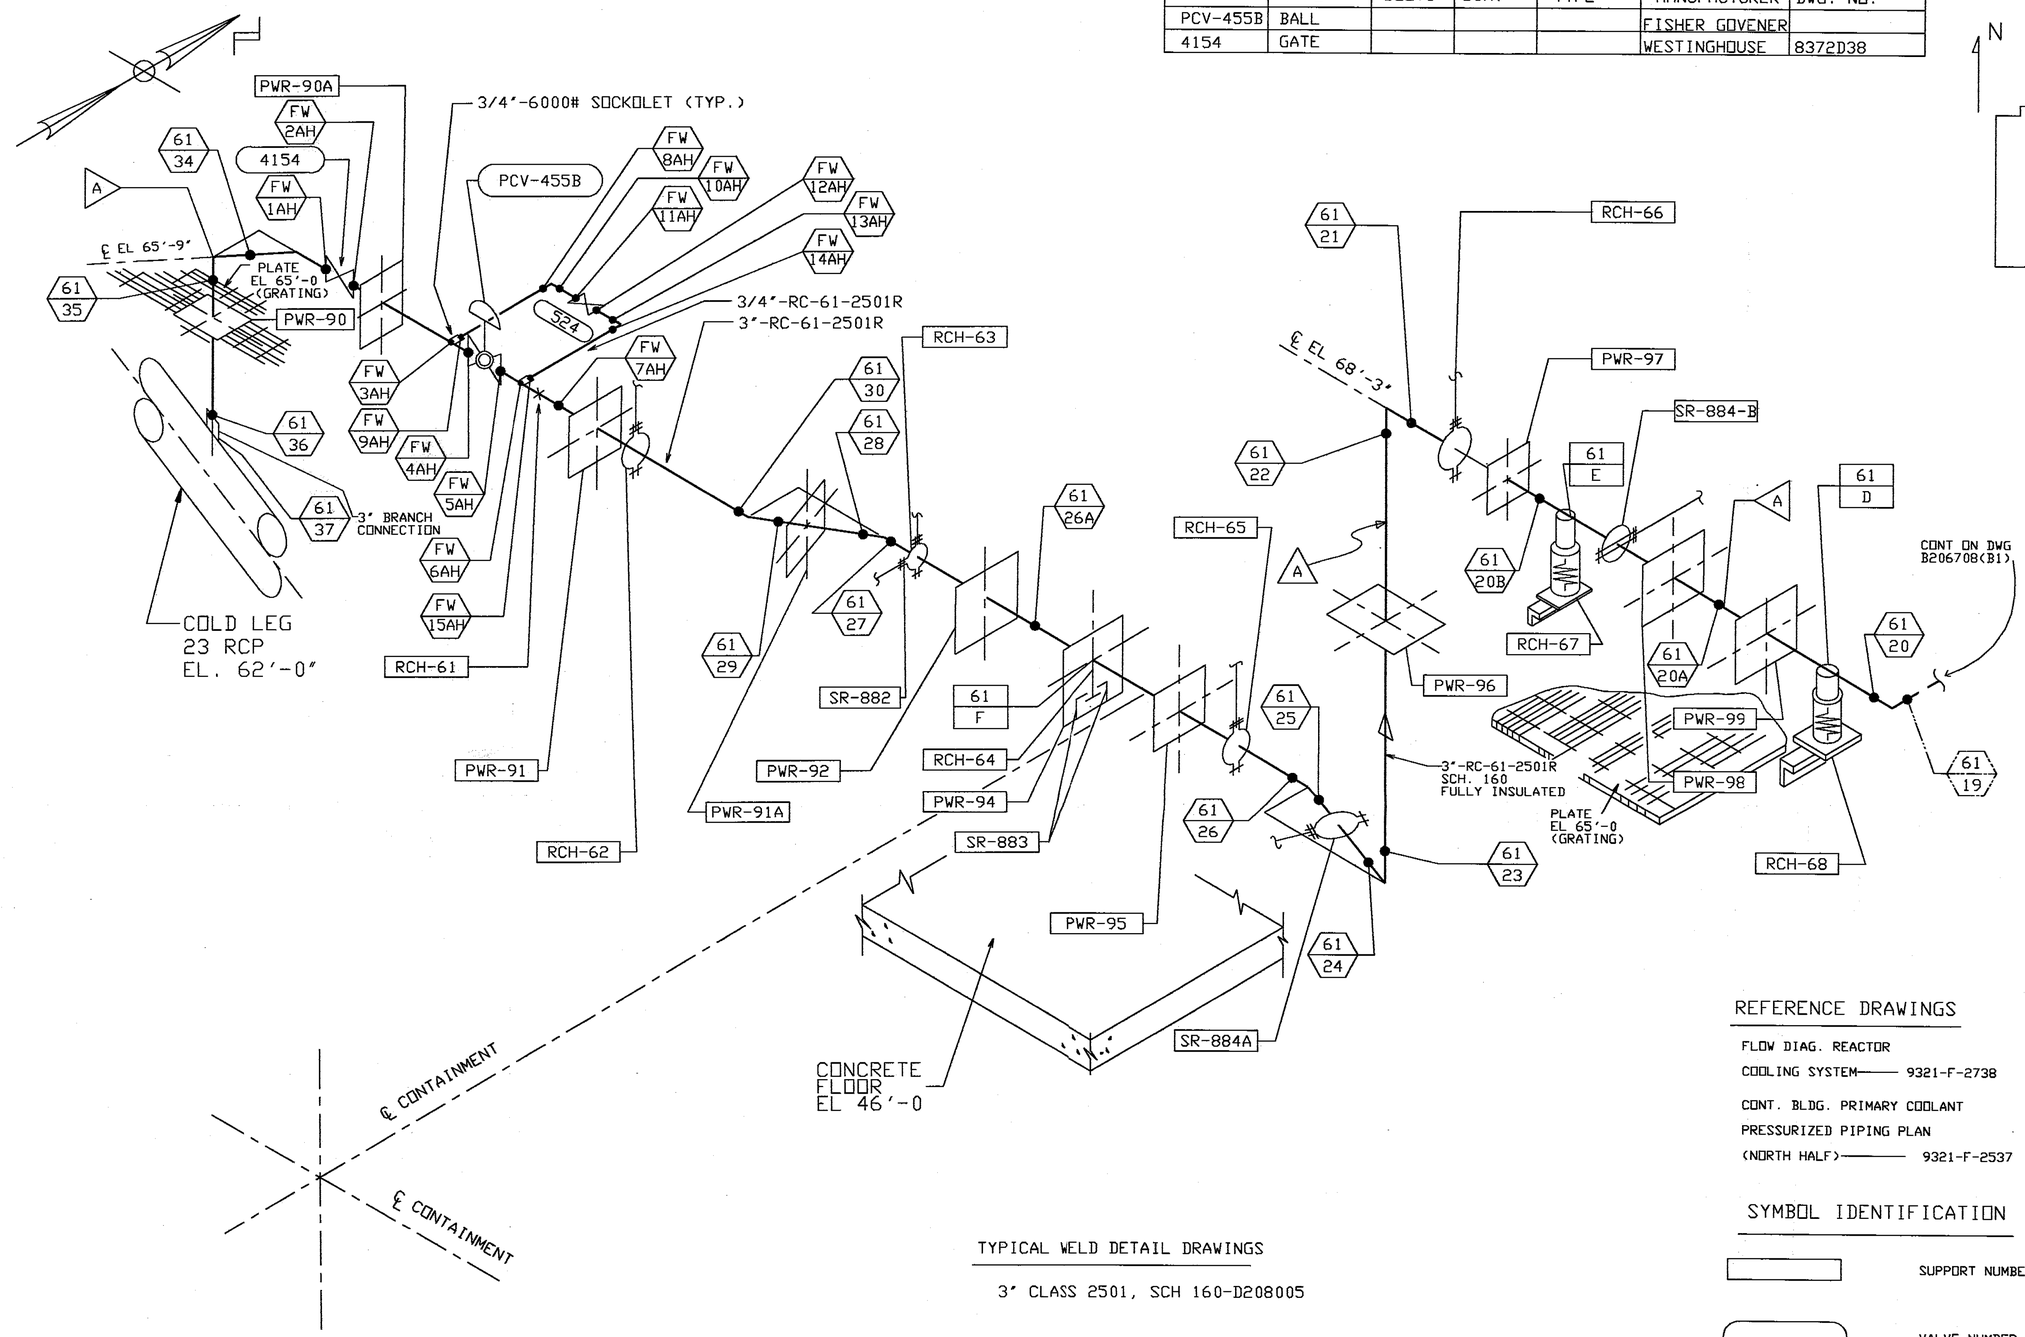

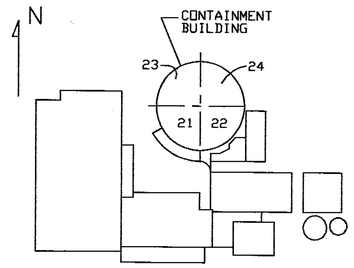

FOR GENERAL NOTES SEE DWG B206708

TYPICAL WELD DETAIL DRAWINGS

3" CLASS 2501, SCH 160-D208005

REFERENCE DRAWINGS

FLOW DIAG. REACTOR COOLING SYSTEM——— 9321-F-2738

CONT. BLDG. PRIMARY COOLANT PRESSURIZED PIPING PLAN (NORTH HALF)——— 9321-F-2537

SYMBOL IDENTIFICATION

- SUPPORT NUMBER
- VALVE NUMBER
- WELD NUMBER
- QUALITY GROUP IDENTIFICATION
- INTEGRAL SUPPORT WELD NUMBER

NOT FOR FABRICATION OR INSTALLATION

THIS DRAWING CONTAINS ITEMS WHICH MUST BE CONTROLLED WITHIN CON EDISON AS:
"CLASS A" ITEMS
PER CI-240-1

Docket #50-247
Accession #9403110017
Date 2/28/94 of Ltr
Regulatory Docket File

DATE: 12-11-93

COMPUTER GENERATED DRAWING NOT TO BE HAND REVISED

REVISION			DATE	CKR.	SUPV.	DESIGN ENG	DISC. ENG.	ENG. MGR.
	DES	REV.07-THIS REV. IS CLASS "A" PER CI-240-1 UPDATED DWG. AS PER AS-BUILT INFORMATION AND SERVICE INSPECTION FIELD REVISION INFORMATION. RELEASED FOR RECORD P/N 69982-AD-4 NPS 12-15-93 /AAA						
	ENG	NPS ENG'G & TECHNICAL SERVICES		REVIEW		APPROVALS		

TITLE: INSERVICE INSPECTION
ISOMETRIC OF PRESSURIZER SPRAY
LINE #61 INSIDE CONTAINMENT
SHT. 1 OF 2

DRWN. BY P. DENE | SCALE NONE | REC'D

Con Edison

SHE 1-2
STATION INDIAN POINT #2

DWG. NO. B206707-07 MJ