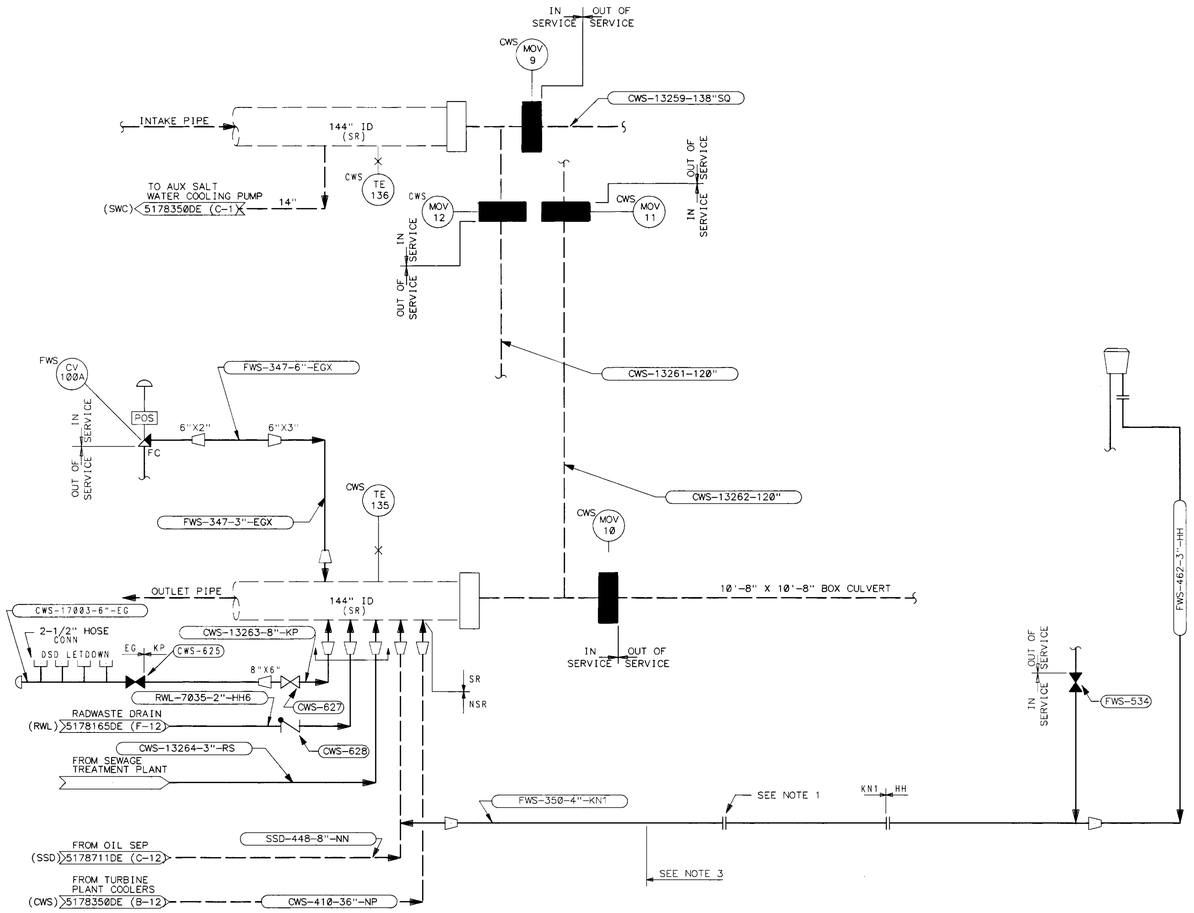

NOTES:

1. INSULATING FLANGE IS DISABLED.
2. ~~SEE DWG 5178331DE FOR SH 2.~~ MB 4/19/00
3. LINES ORIGINALLY SHOWN ON SUPERSEDED DWG 5178206.

NO	DESCRIPTION	RE	IRE	GS	DM	CHK	OTHER	DATE
0	S/S DWG. 5178206 & 5178330 ISSUED AS-BUILT INCORPORATES DCN #25 ~~CHECKED~~ FROM DWG 5178330	MB	4/14/00				DCWS	04/14/00

REVISIONS

DRAWING NUMBER	DESCRIPTION

REFERENCES

APRIL 14, 2000 15:58

QC SR-AN UNIT 1

SAN ONOFRE NUCLEAR GENERATING STATION

DECOMMISSIONING
P & I DIAGRAM
CIRCULATING WATER SYSTEM SH. 1

SOUTHERN CALIFORNIA EDISON

Scale: NONE DRAWN BY: A. MARTINEZ

5178330DE REV 0

Site File Copy