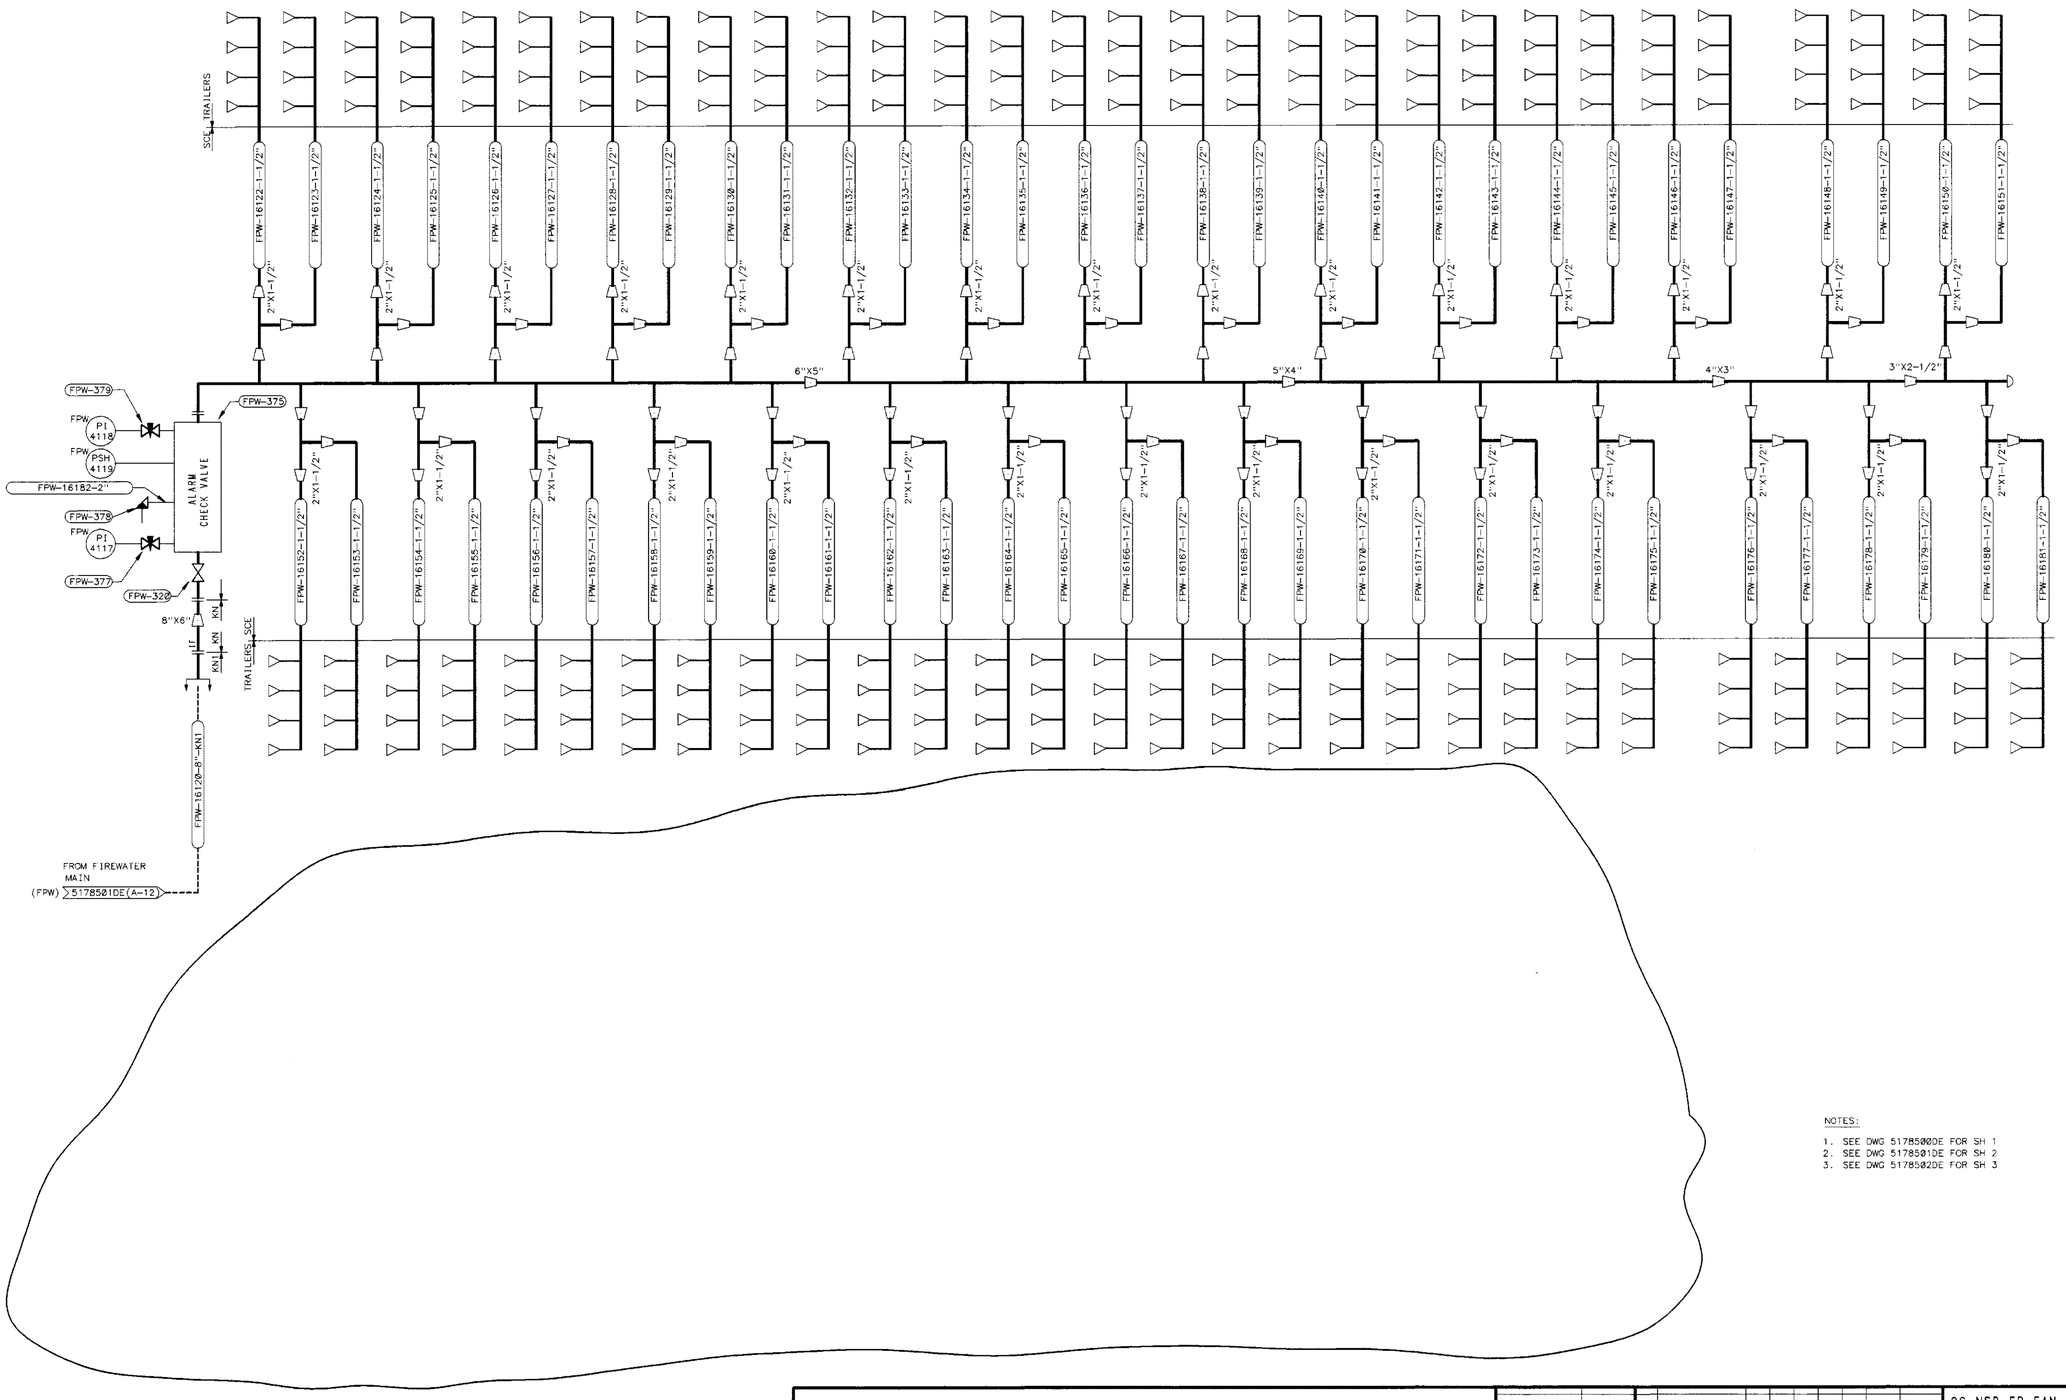

NOTES:

1. SEE DWG 5178500DE FOR SH 1
2. SEE DWG 5178501DE FOR SH 2
3. SEE DWG 5178502DE FOR SH 3

M.REVIEW DCMS STATUS = APRV MAY 21, 2003 14:11

DRAWING NUMBER	DESCRIPTION

REFERENCES

NO	DESCRIPTION	RE	IRE	FLS	DM	CHK	OTHER	DATE
2	INCORPORATED DCN #1					DCMS		05/21/03
1	REVISED AS-BUILT					DCMS		07/31/01
0	AS BUILT CATIA DWG.					DCMS		05/01/00

REVISIONS

QC NSR-FP-EAN UNIT 1

SAN ONOFRE NUCLEAR GENERATING STATION

DECOMMISSIONING
P & I DIAGRAM
FIRE PROTECTION WATER SYSTEM SH. 4

SOUTHERN CALIFORNIA EDISON

Scale: NONE DRAWN BY: MOUYEN, L.

5178503DE REV 2

Site File Copy