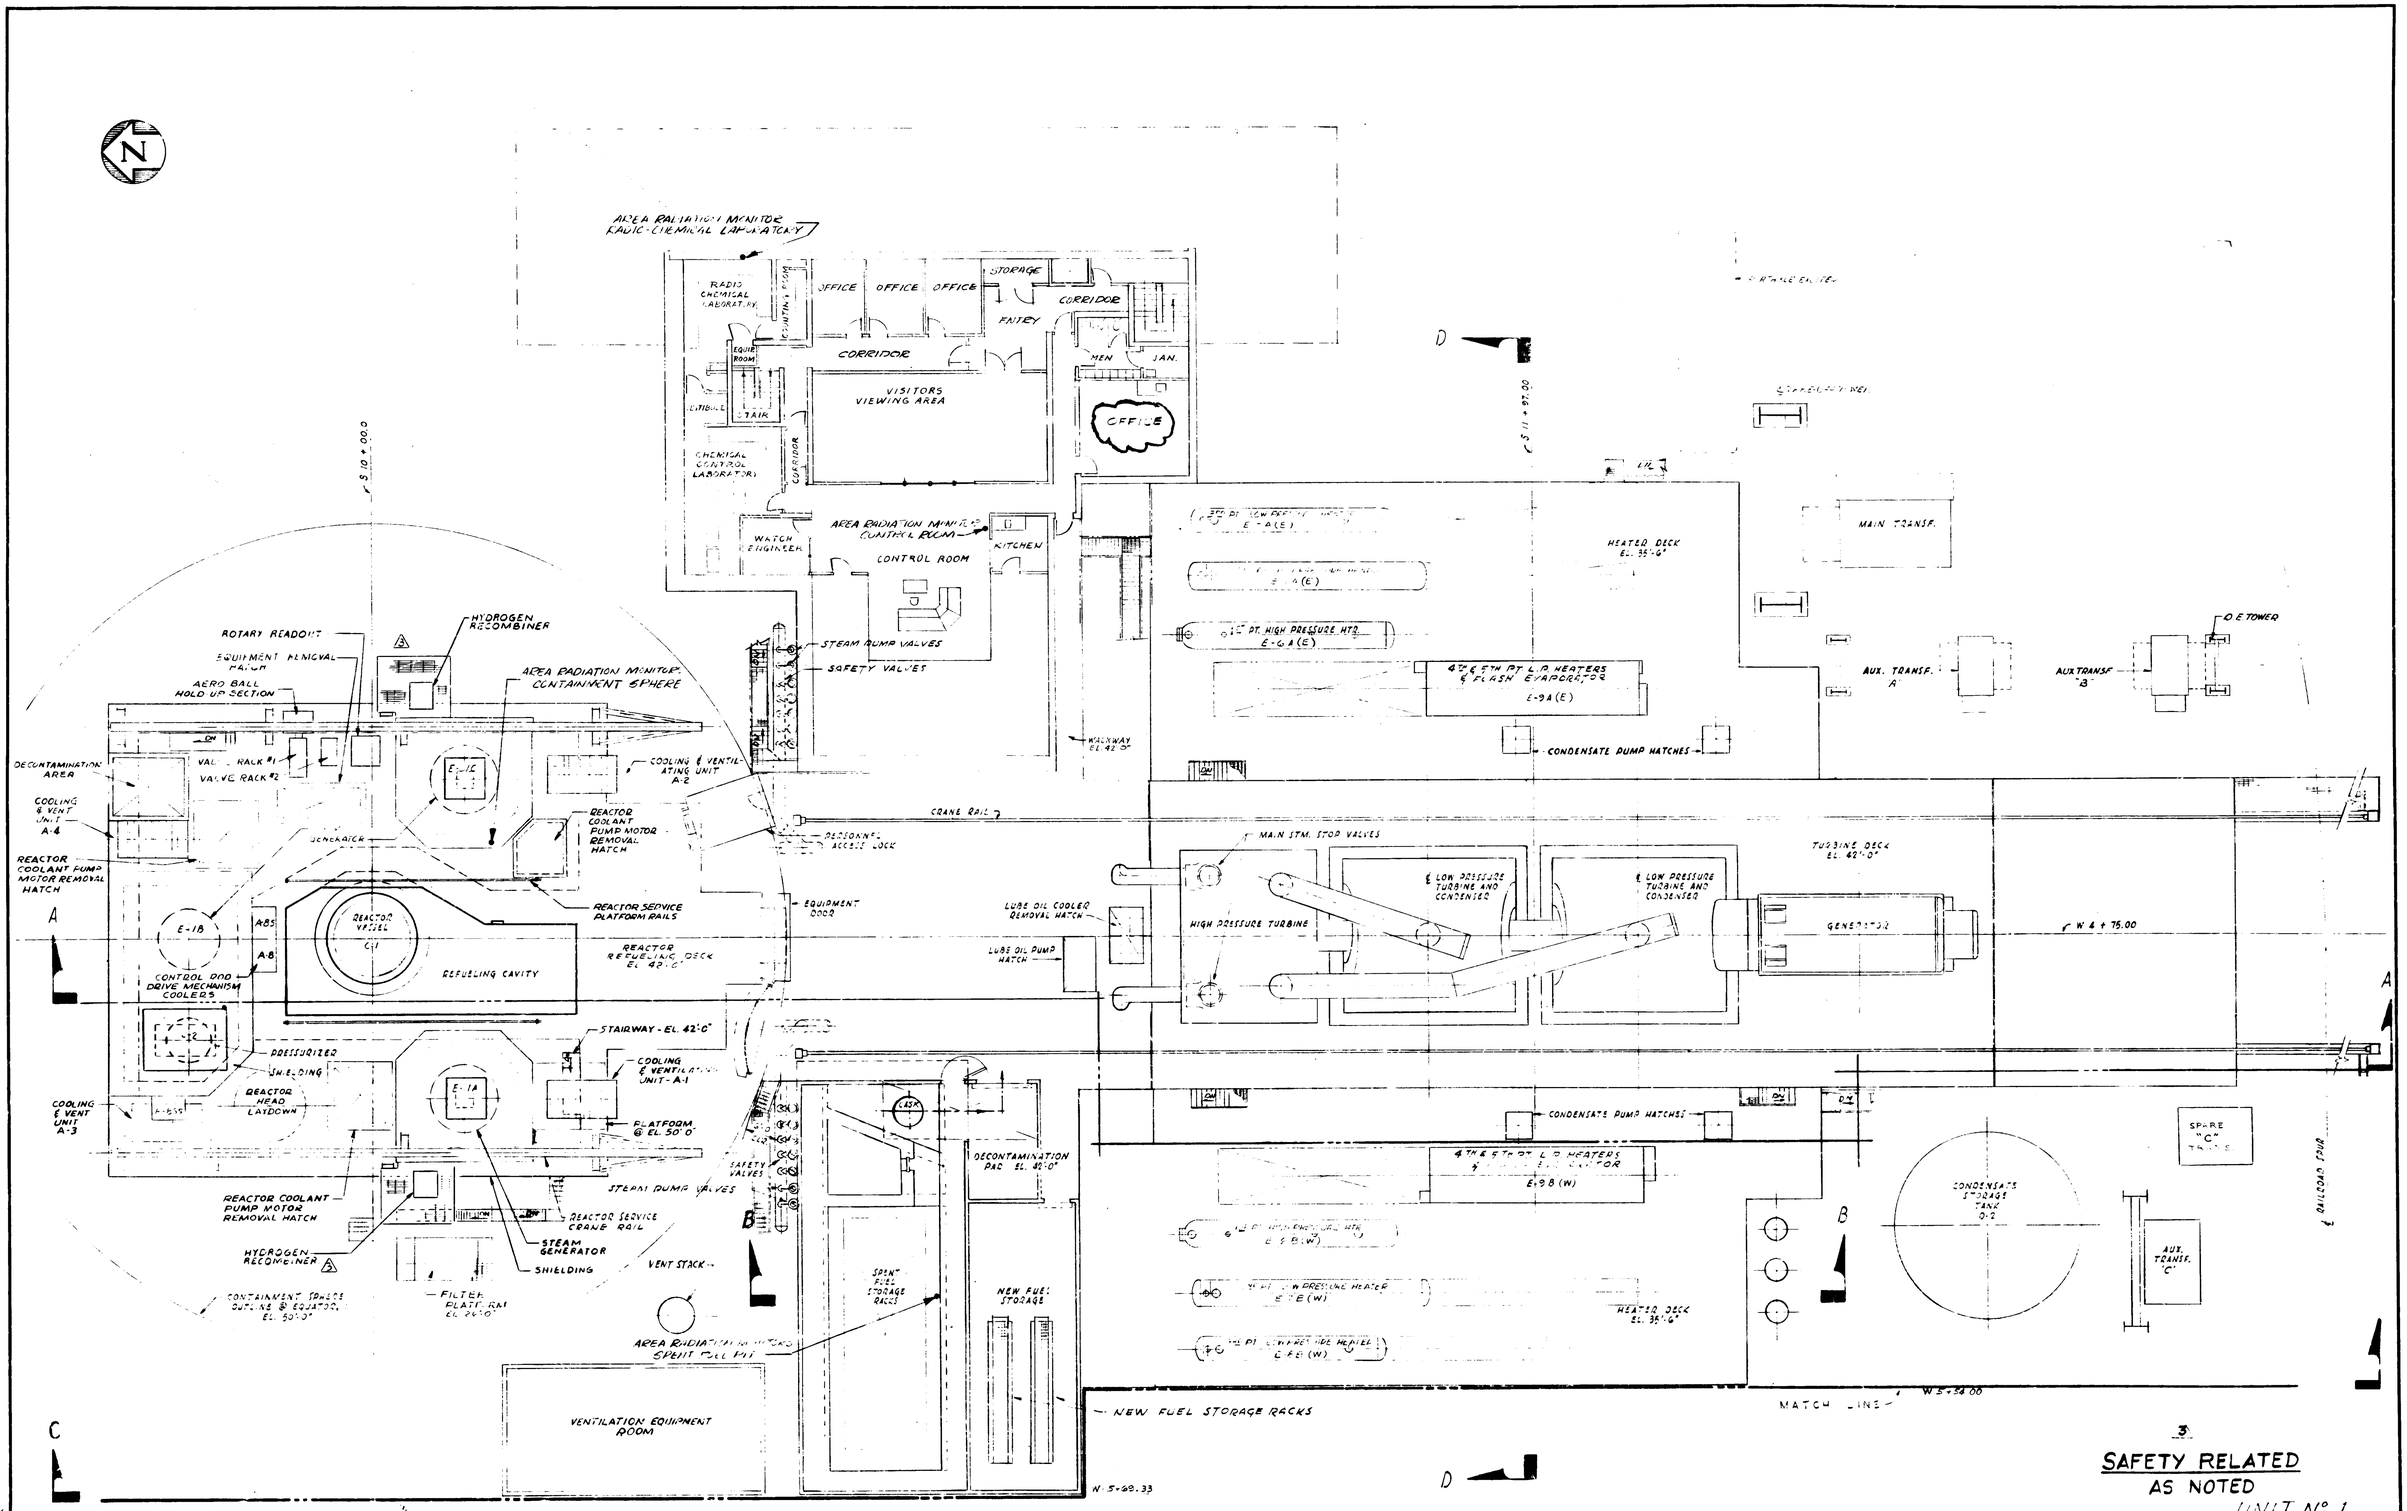

BECHTEL CORPORATION ENGINEERS & CONSTRUCTORS LOS ANGELES, CALIF.		
JOB NO.	DATE	APPROVED
3246	12-22-64	

DRWG. NO.	CROSS REFERENCES	No.	REVISIONS	DATE	APPROVED	O.K.	O.K.	CHECKED	MADE	J.O.No.
		4	AS BUILT-INCORP. DCN & 2	6/15/67			AAR	AR	8851	
		3	INCORP. CC #1 & ADDED SAFETY RELATED AS NOTED	5/27/61			LAM	GC	7764	
		2	GENERAL REVISION	7-26-66					8780	
		1	GENERAL REVISION	9-22-65						
		0	ISSUED FOR CONSTRUCTION	12-22-64				MCE	K	5780
		D	GENERAL REVISIONS	5-18-64						
		C	GENERAL REVISIONS	OCT 17-63						
		B	GENERAL REVISIONS	AUG 9-63						
		A	ISSUED FOR PRELIMINARY INFORMATION	MAY 1-63						

LOCATION SAN ONOFRE NUCLEAR GEN. STATION			
GENERAL ARRANGEMENT PLAN OF ELEV. 35'-6"			
SOUTHERN CALIFORNIA EDISON COMPANY			
SCALE 3/32" = 1'-0"	LOS ANGELES, CALIF.		

568700-4

Southern California Edison Company

MICROFILMED FROM

Amended: June 2010