


FOR DIESEL GENERATOR BLDG & RELATED FACILITIES & LOCATION OF DSD EQUIPMENT STORAGE SEE DWG. 5149208

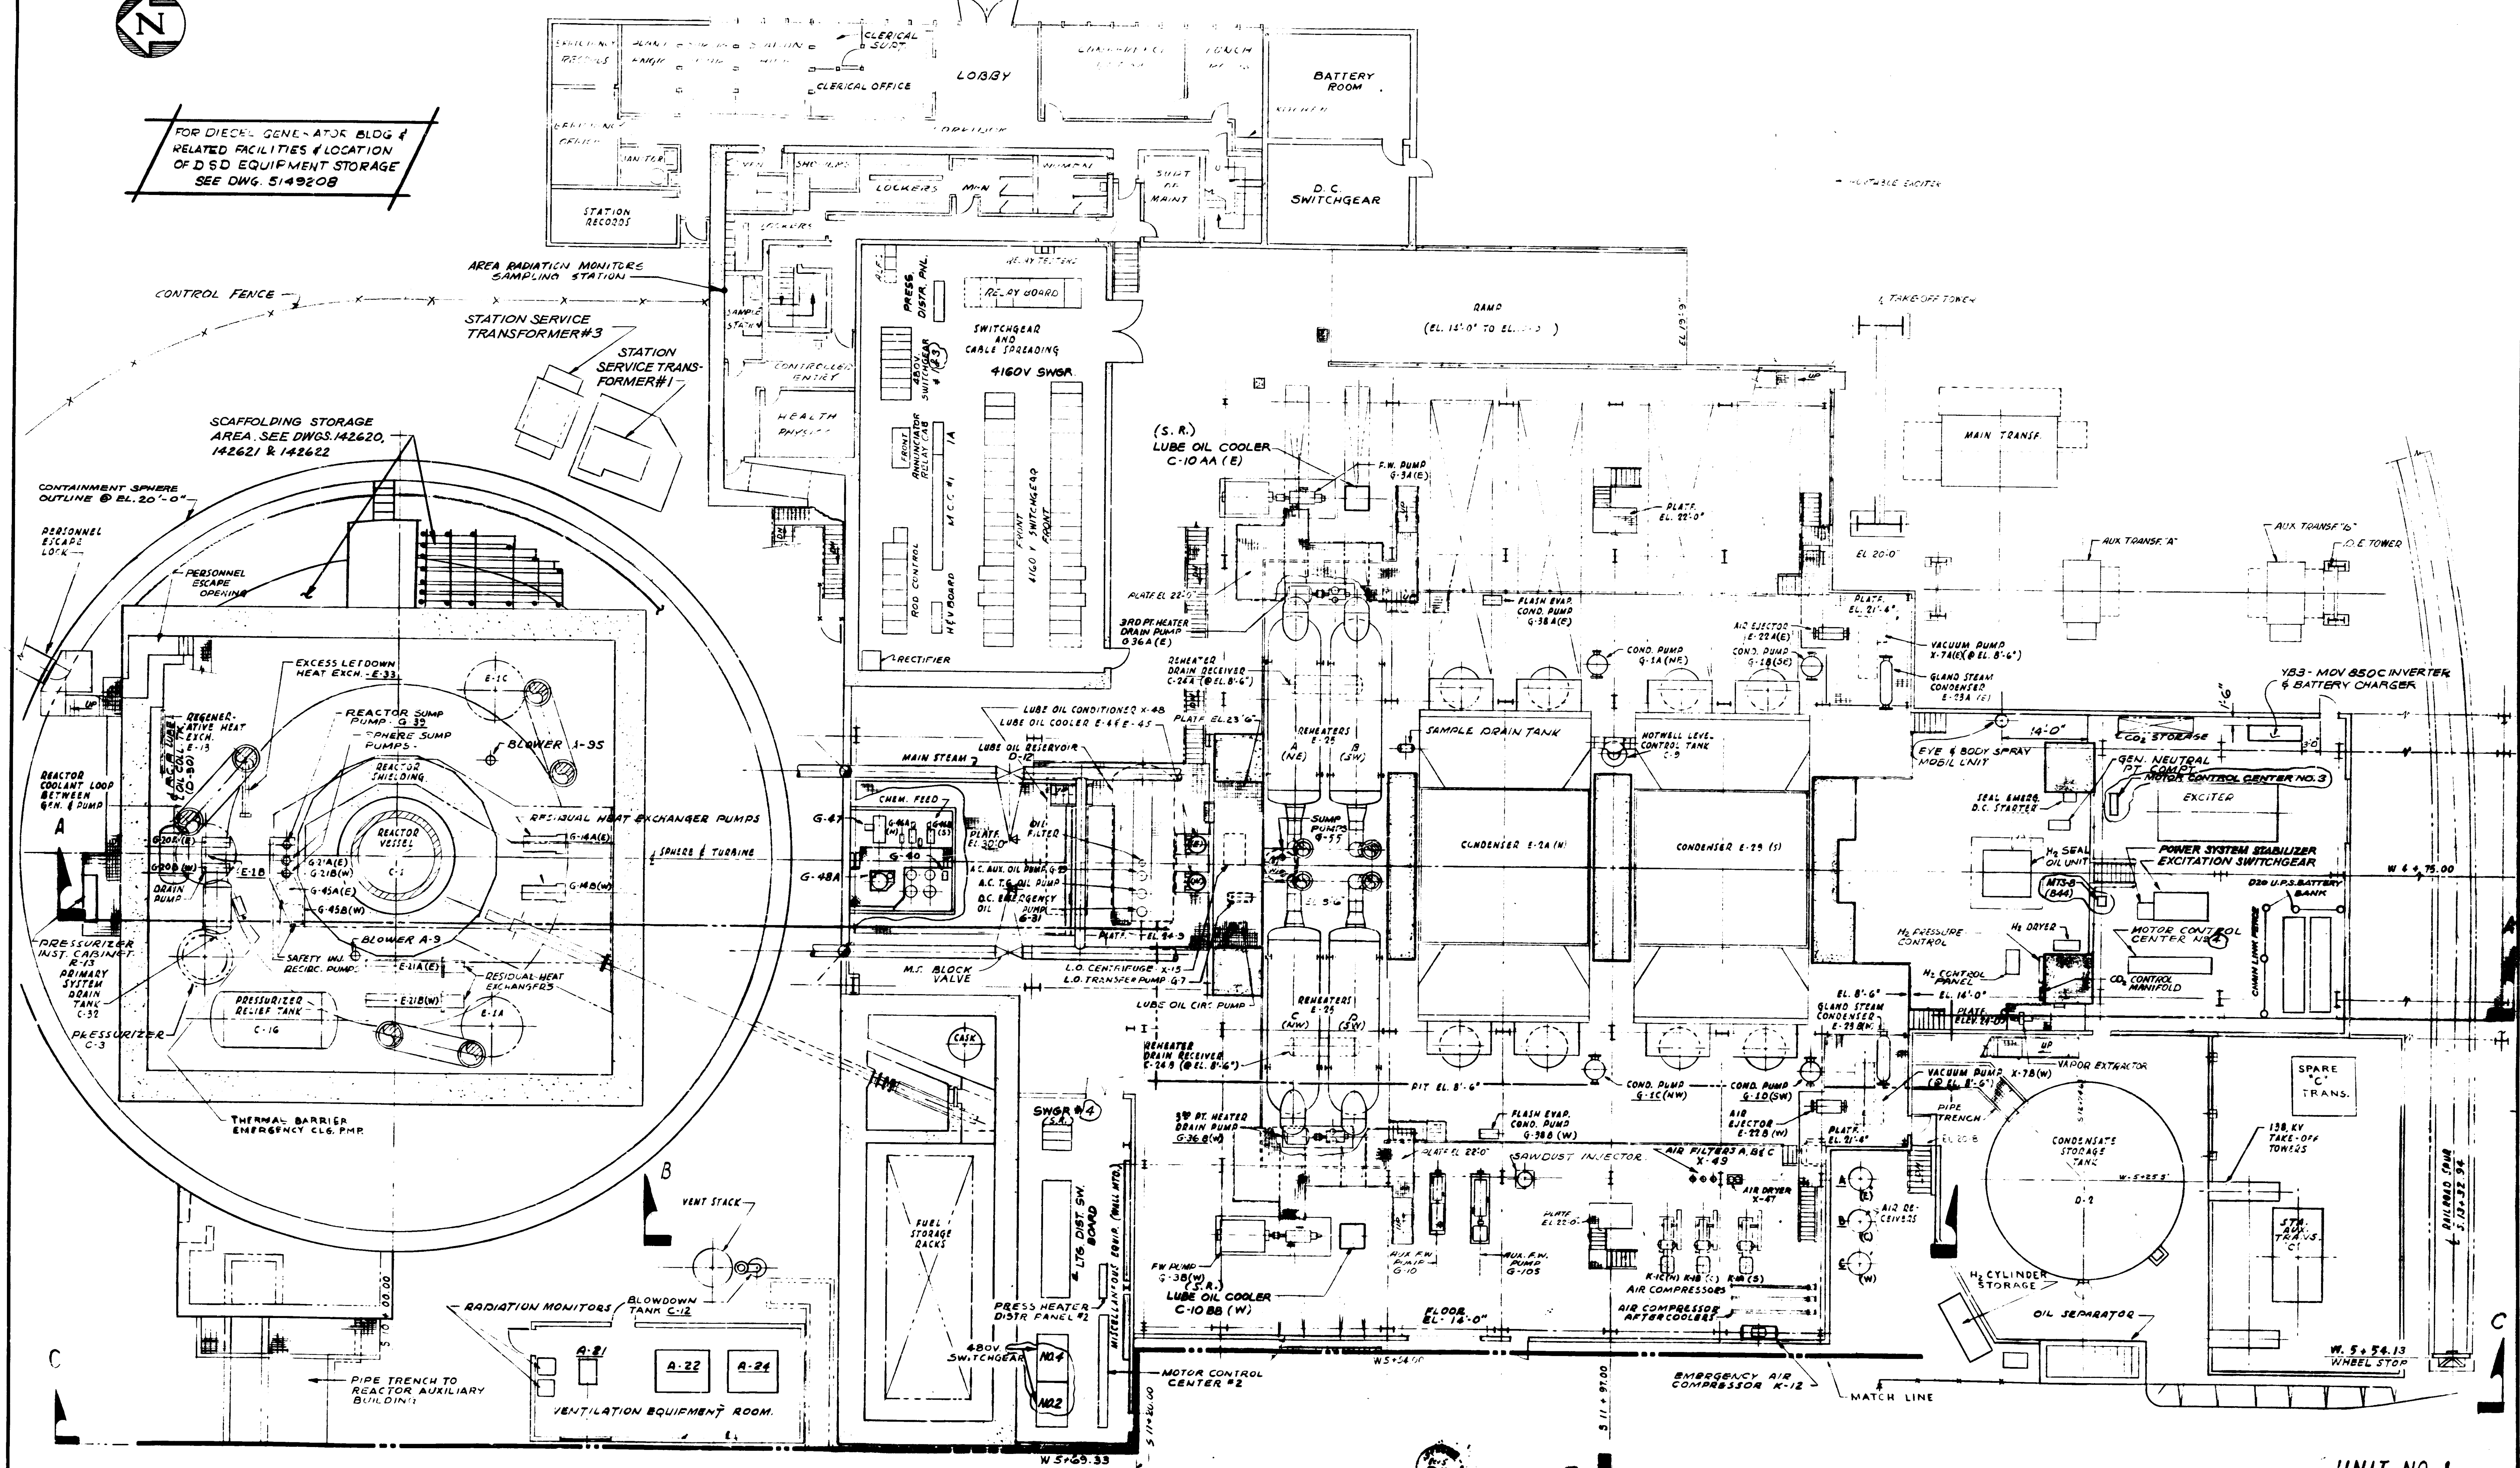

BECHTEL CORPORATION
ENGINEERS & CONSTRUCTORS
LOS ANGELES, CALIF.

JOB NO. 37246 DATE 12-22-64 APPROVED [Signature]


UNIT NO. 1
SAFETY RELATED AS NOTED
LOCATION SAN ONOFRE NUCLEAR STATION
GENERAL ARRANGEMENT
PLAN OF ELEV. 14'-0"
SOUTHERN CALIFORNIA EDISON COMPANY
SCALE 1/32" = 1'-0"
LOS ANGELES, CALIF.

568701-14