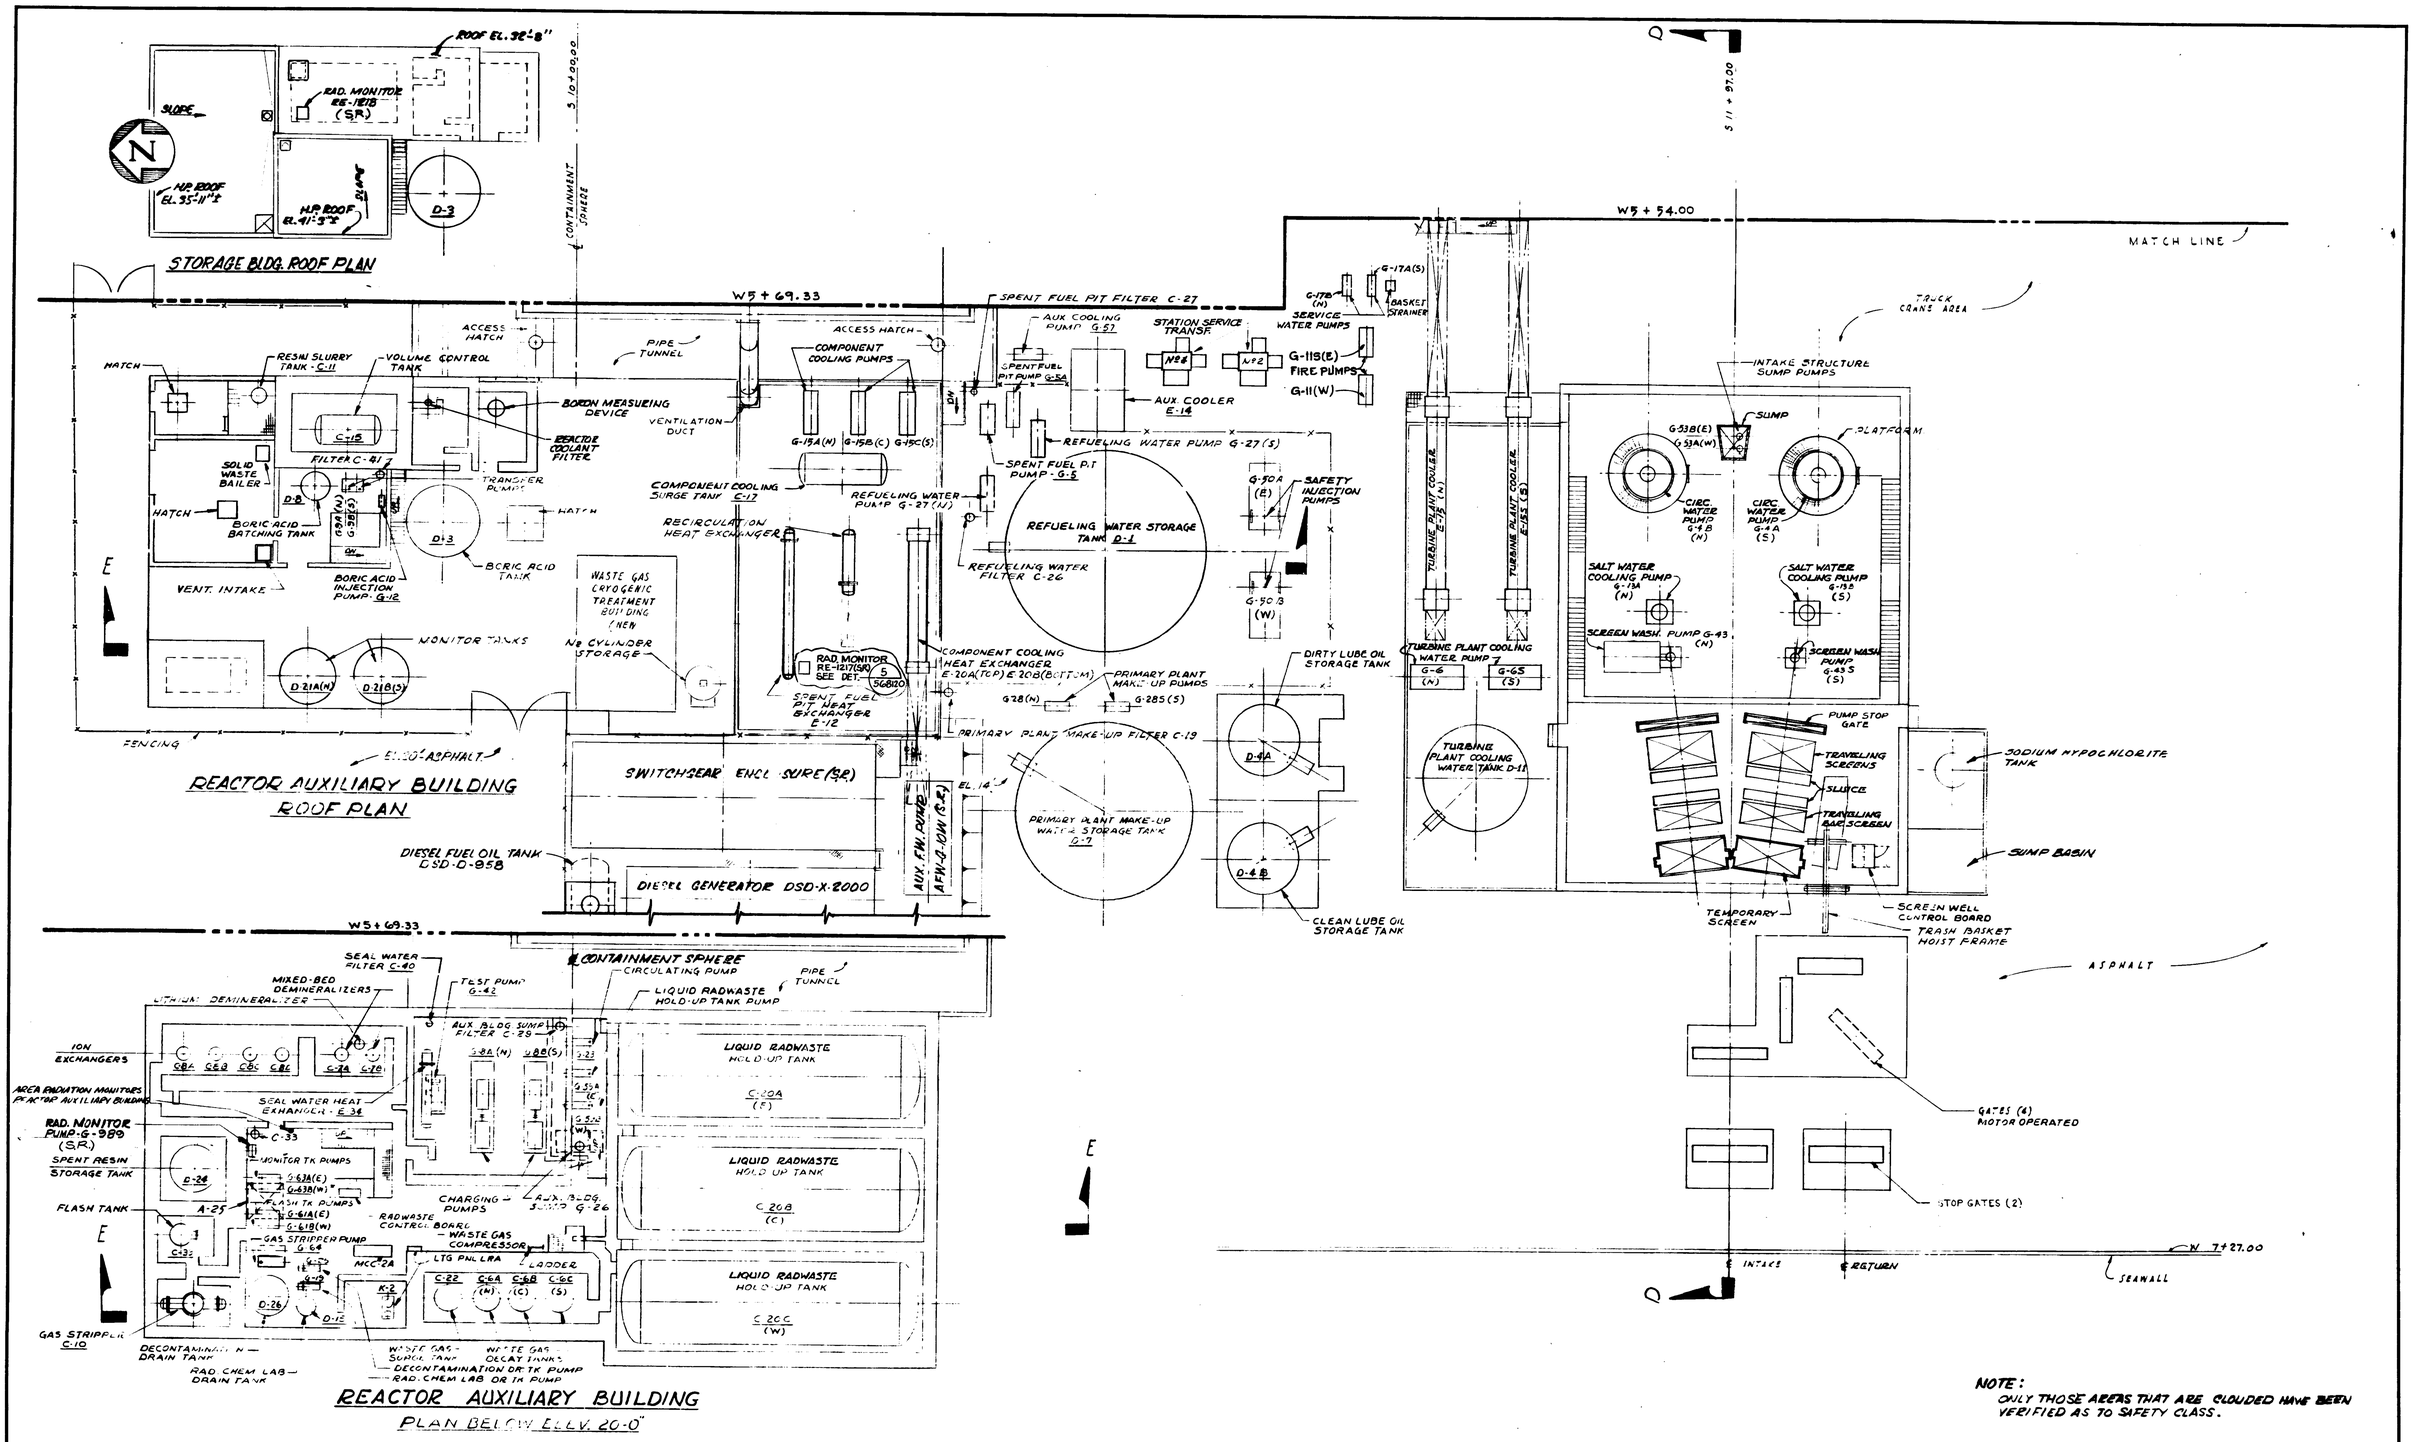

NOTE:
ONLY THOSE AREAS THAT ARE CLOUDED HAVE BEEN VERIFIED AS TO SAFETY CLASS.

SAFETY RELATED AS NOTED
(SRAN)

CONTROL ROOM 1

UNIT Nº 1

BECHTEL CORPORATION
ENGINEERS & CONSTRUCTORS
LOS ANGELES, CALIF.

JOB NO.	DATE	APPROVED
3246	12-22-64	

DWG. NO.	CROSS REFERENCES

No.	REVISIONS	DATE	APPROVED	C.K.	O.K.	CHECKED	MADE	J.O.No.
9	AS BUILT BY FLUOR, INC. DCN 14 (FCN #F-7355C)	6-24-71			—		LS	ABS	—
8	AS BUILT BY FLUOR, INC. DCN 13 (DCP1-3552, 00 SEE 1/0	10-16-68			—	DAH	RR	DHSY	—
7	AS BUILT BY FLUOR, INC. DCN 12 (MMP1-3606, 00 SEE 1/0	8-1-68					LS	ABS	—
6	AS-BUILT, INCORP. DCN # 9, 10, 11 & MINOR CHNG	3-29-67				DH		LAM	3085
5	AS-BUILT, INCORP. DCN # 8	5-16-66				DH		LAM	3085
4	AS BUILT - INCORP. DCN # 3, 4, 5, 6, 7 & MINOR CHNG	11-5-65				DH		LAM	3085

No.	REVISIONS	DATE	APPROVED	O.K.	O.K.	CHECKED	MADE	J.O.No.
3	INCORPORATED CCN #1	9-1-67						
2	GENERAL REVISION	7-26-66					HE	5780
1	GENERAL REVISION.	9-22-65					HS	5780
0	ISSUED FOR CONSTRUCTION	12-22-64					MCE	5780
B	GENERAL REVISIONS	5-18-64					JFK	5780
A	ISSUED FOR PRELIMINARY INFORMATION	OCT 1964					LS	5780

LOCATION: SAN ONOFRE NUCLEAR GEN STATION

GENERAL ARRANGEMENT
REACTOR AUXILIARY BUILDING
AND INTAKE STRUCTURE

SOUTHERN CALIFORNIA EDISON COMPANY

SCALE 3/32" = 1'-0" LOS ANGELES, CALIF.

M20

568703 - 9

Amended: June 2010

MICROFILMED FROM