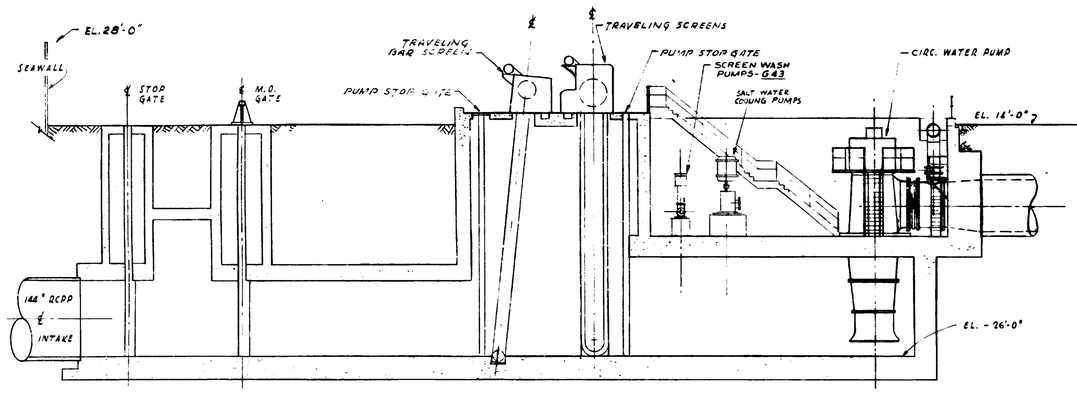

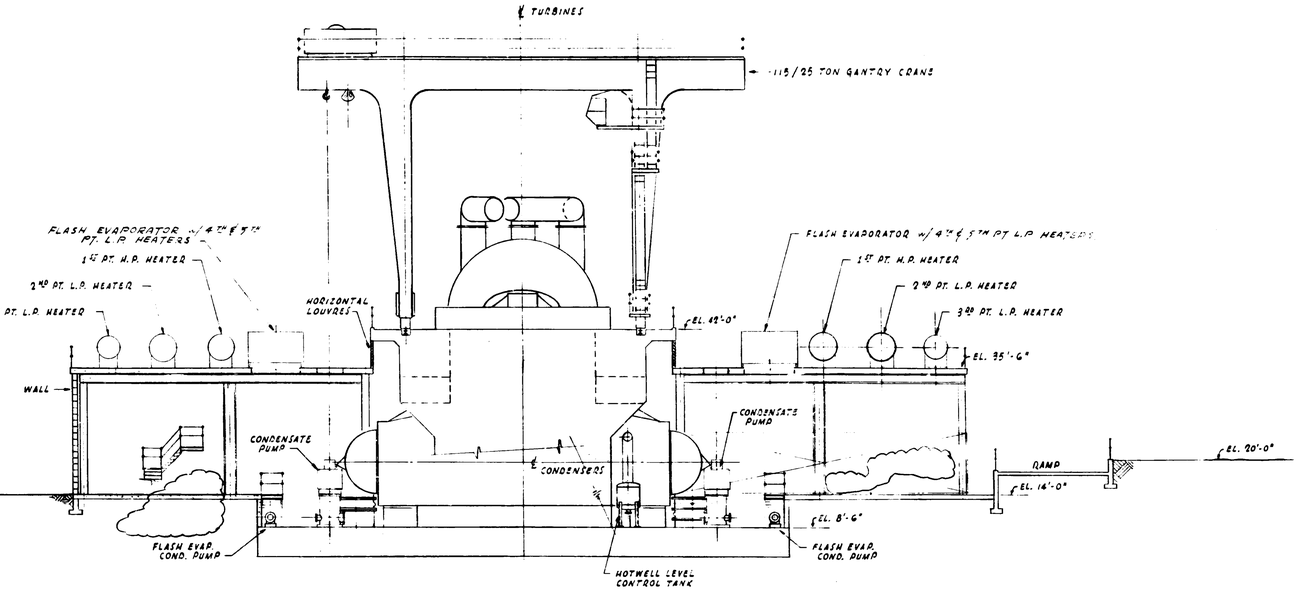

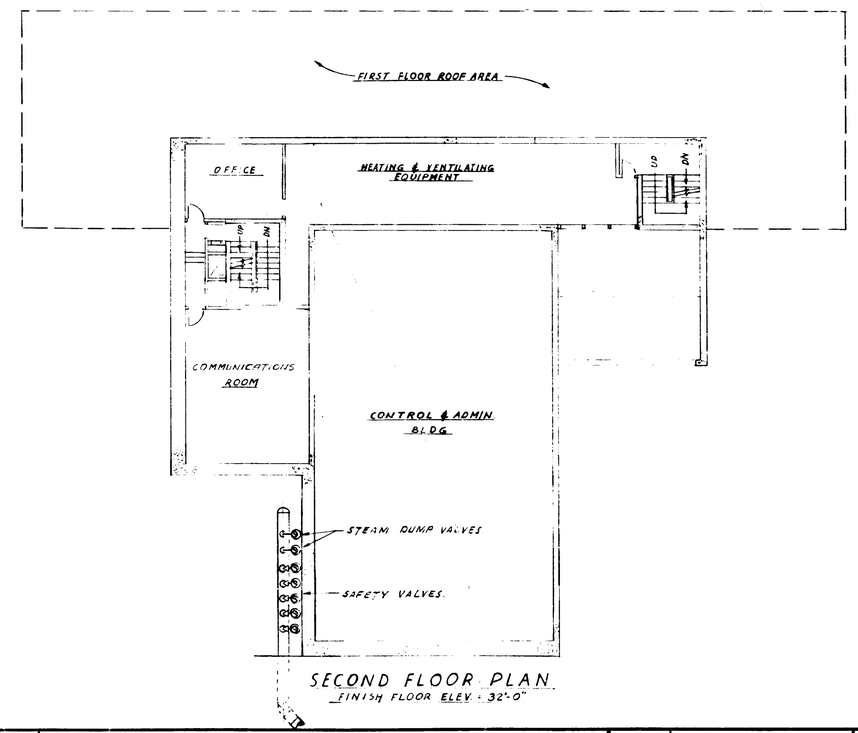

SECOND FLOOR PLAN
FINISH FLOOR ELEV. 32'-0"

SECTION D-D

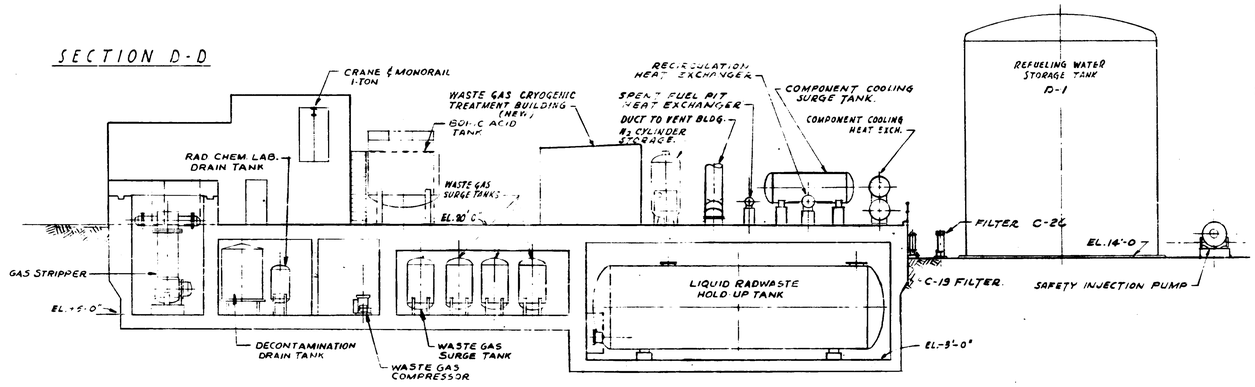

SECTION E-E

SAFETY RELATED AS NOTED

UNIT NO. 1

3	AS BUILT BY PLANT, INC. DCN 1 (FCN 5-5184-M)	2-5-70			—	6-64	R.R.	S.S.	—													
2	GENERAL REVISION.	7-26-66						MC	5780													
1	GENERAL REVISION	9-22-65						H.J.	5780													
0	ISSUED FOR CONSTRUCTION	12-22-64						MCE		5780												
A	GENERAL REVISIONS	3-13-64							UB	5780												
	REVISIONS	DATE	APPROVED	O.K.	O.K.	CHECKED	MADE	J.O.No.														

BECHTEL CORPORATION
ENGINEERS & CONSTRUCTORS
LOS ANGELES, CALIF.

JOB NO.	DATE	APPROVED
3246	12-22-64	

DRWG. NO.	CROSS REFERENCES	No.	REVISIONS	DATE	APPROVED	O.K.	O.K.	CHECKED	MADE	J.O.No.

LOCATION SAN ONOFRE NUCLEAR GEN. STATION

GENERAL ARRANGEMENT
SECTIONS - SHEET 2

SOUTHERN CALIFORNIA EDISON COMPANY
SCALE 3/32" = 1'-0" LOS ANGELES, CALIF.

M2

Plate No. 5

568704-3

Southern California Edison Company

26X

Amended: June 2010