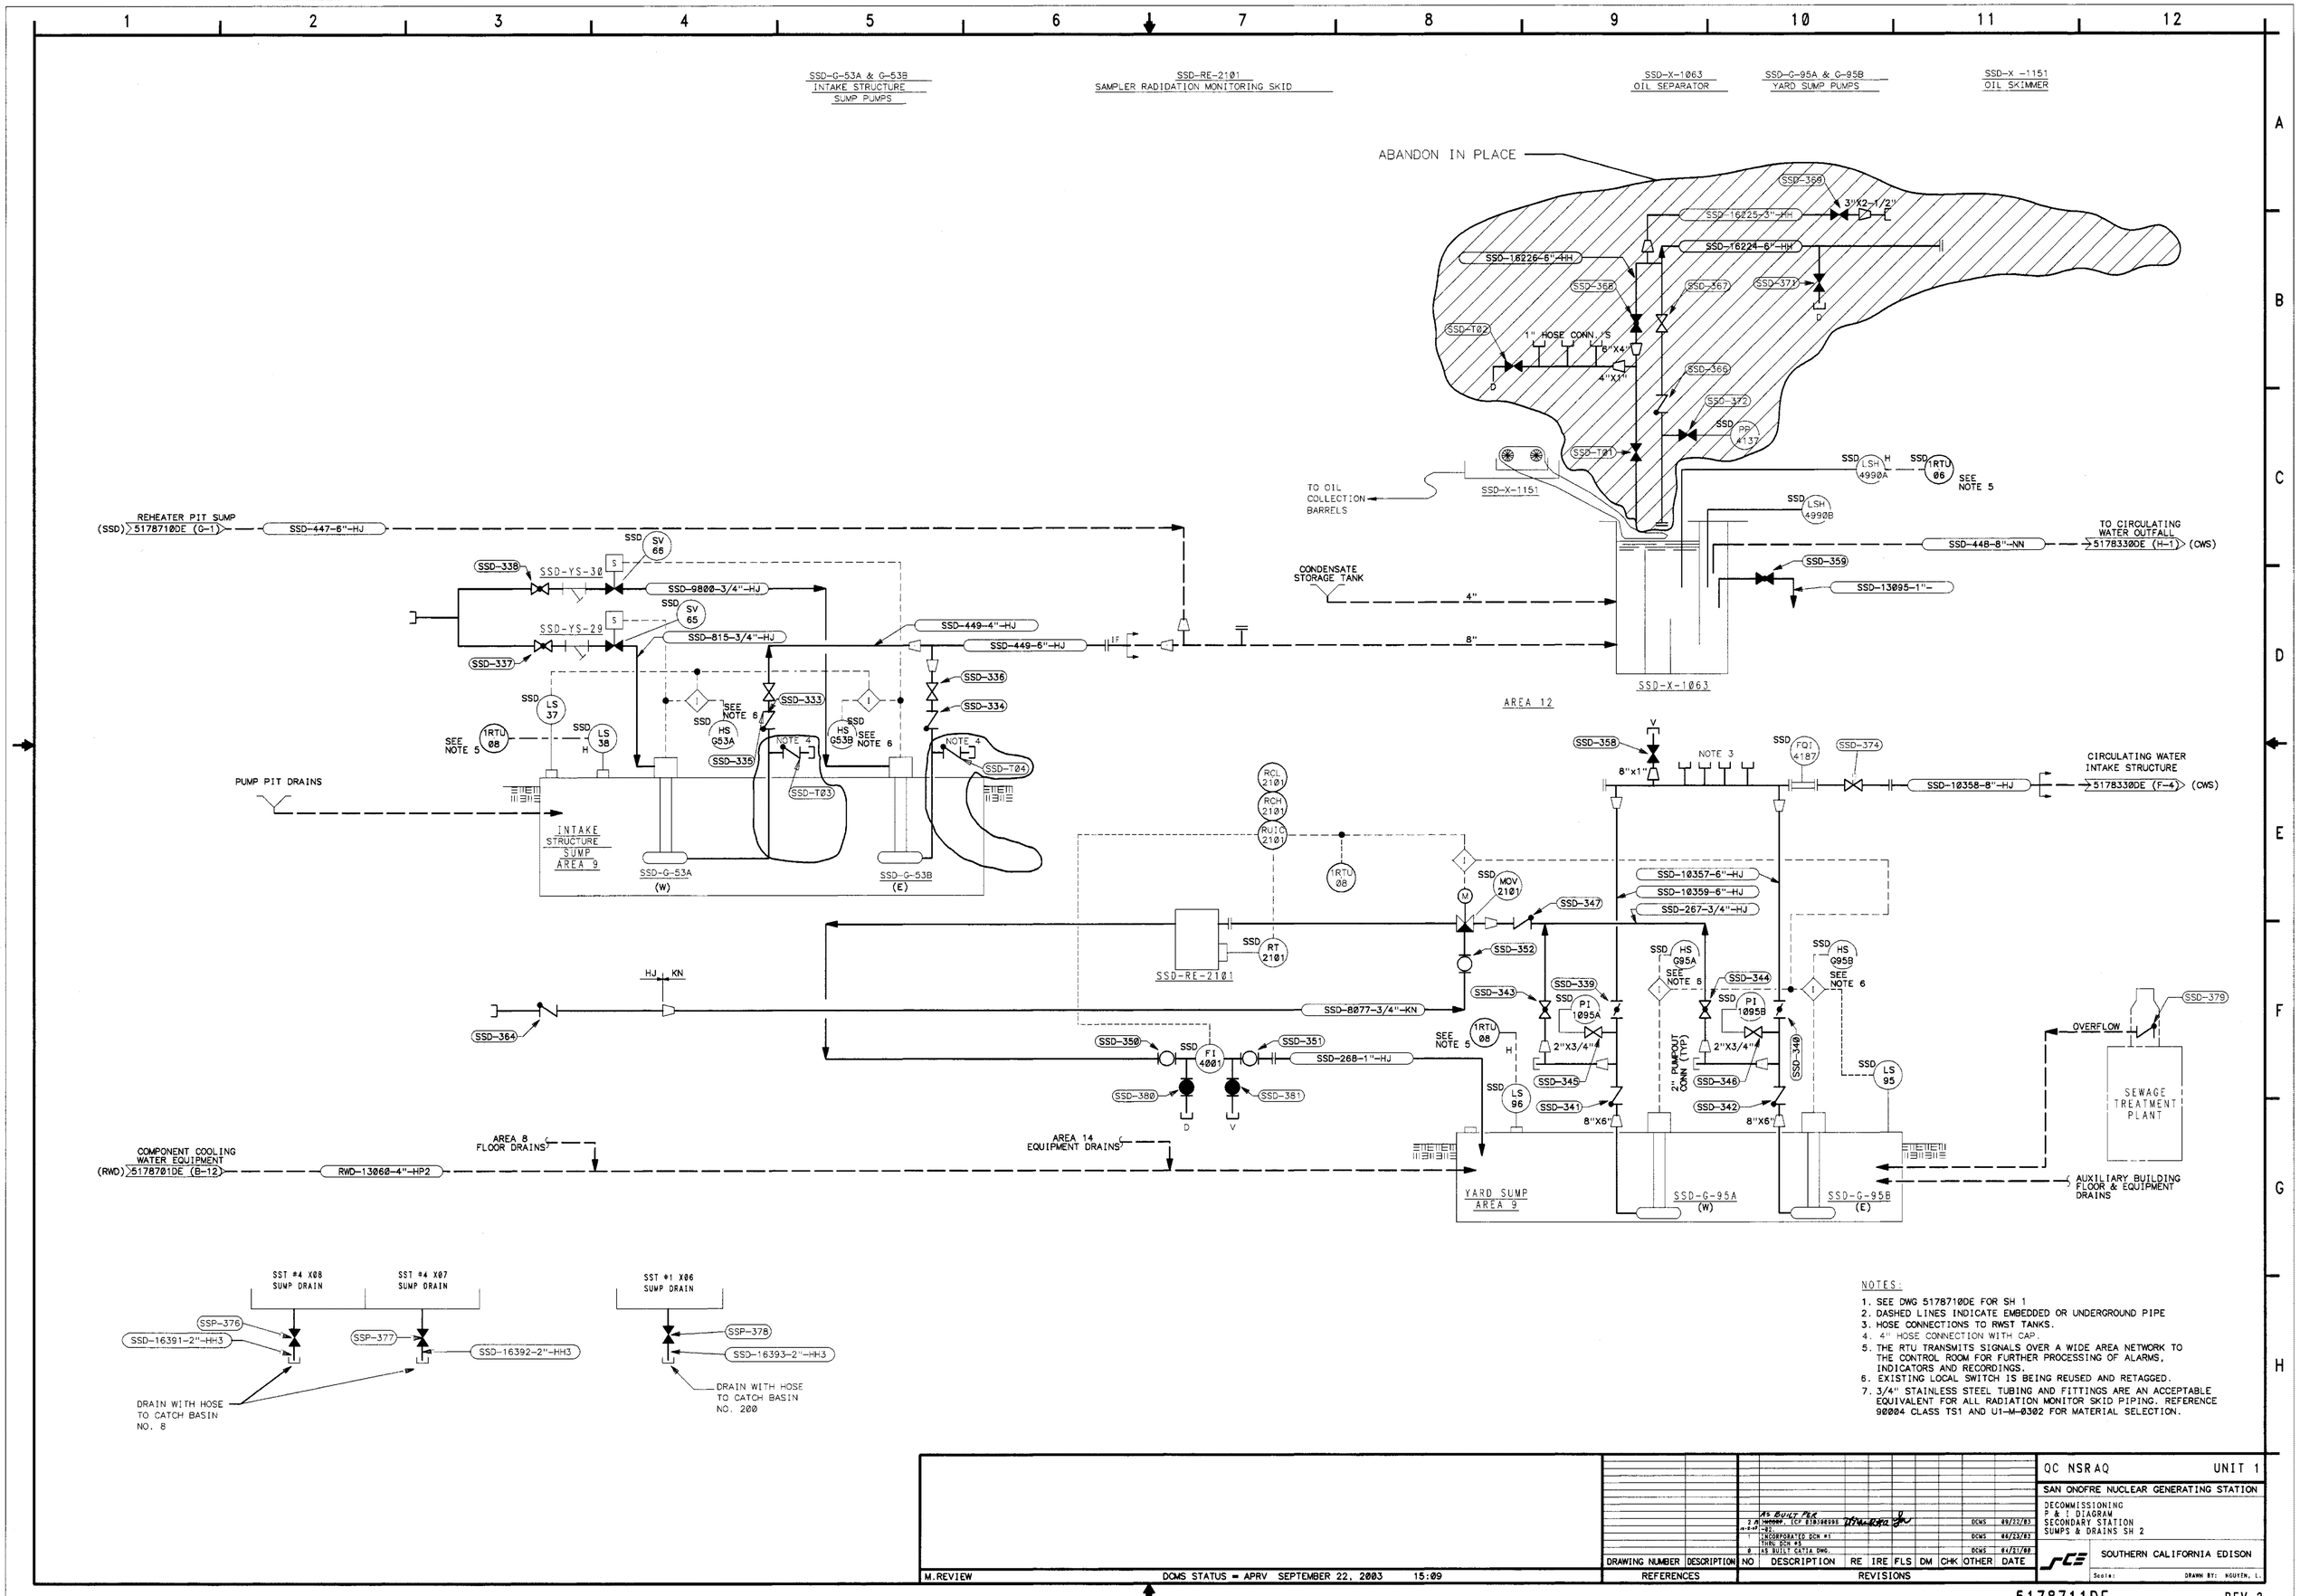

NOTES:

1. SEE DWG 5178710DE FOR SH 1
2. DASHED LINES INDICATE EMBEDDED OR UNDERGROUND PIPE
3. HOSE CONNECTIONS TO RWST TANKS.
4. 4" HOSE CONNECTION WITH CAP.
5. THE RTU TRANSMITS SIGNALS OVER A WIDE AREA NETWORK TO THE CONTROL ROOM FOR FURTHER PROCESSING OF ALARMS, INDICATORS AND RECORDINGS.
6. EXISTING LOCAL SWITCH IS BEING REUSED AND RETAGGED.
7. 3/4" STAINLESS STEEL TUBING AND FITTINGS ARE AN ACCEPTABLE EQUIVALENT FOR ALL RADIATION MONITOR SKID PIPING. REFERENCE 90004 CLASS TS1 AND U1-M-0302 FOR MATERIAL SELECTION.

DRAWING NUMBER	DESCRIPTION	NO	DESCRIPTION	RE	IRE	FLS	DM	CHK	OTHER	DATE
		2	AS BUILT PER ~~NOORP~~, ECP 030390995 -02.						DCMS	09/22/03
		1	INCORPORATED DCN #1 THRU DCN #5						DCMS	06/23/03
		0	AS BUILT CATIA DWG.						DCMS	04/21/00

REFERENCES — REVISIONS

QC NSRAQ UNIT 1

SAN ONOFRE NUCLEAR GENERATING STATION

DECOMMISSIONING
P & I DIAGRAM
SECONDARY STATION
SUMPS & DRAINS SH 2

SOUTHERN CALIFORNIA EDISON

Scale: DRAWN BY: NGUYEN, L.

M.REVIEW DCMS STATUS = APRV SEPTEMBER 22, 2003 15:09

5178711DE REV 2

Amended: June 2010

Site File Copy