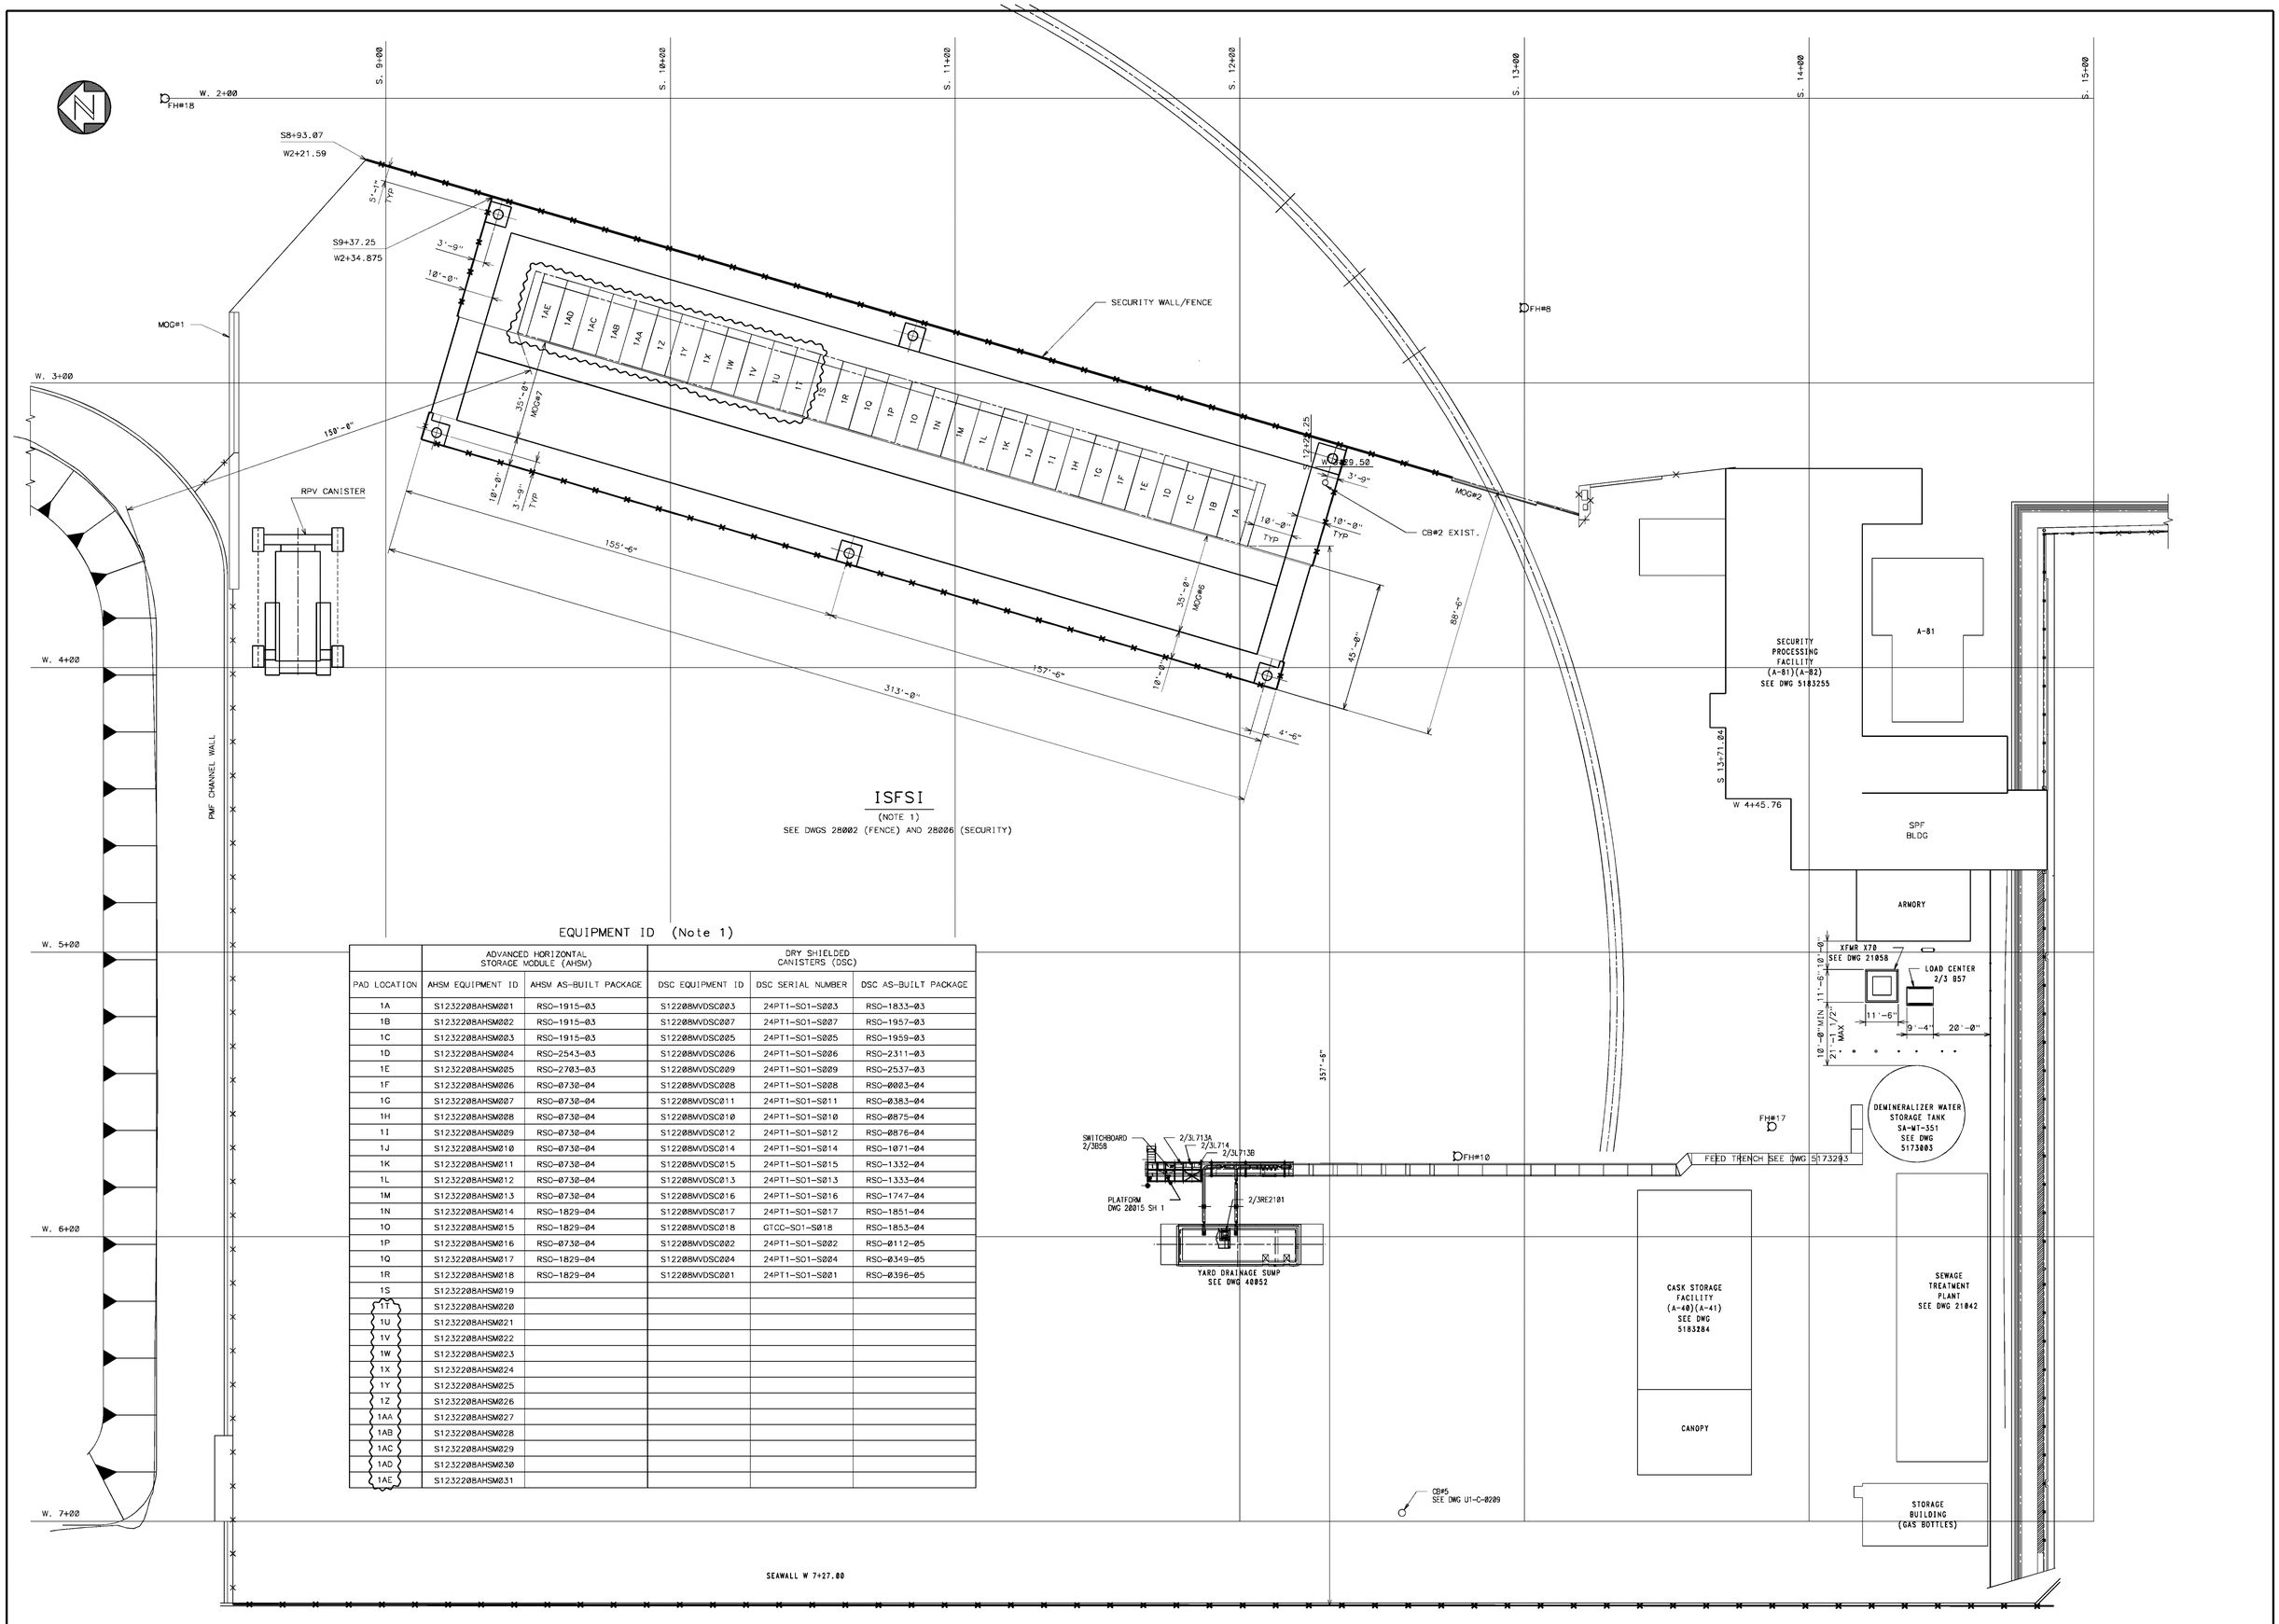

EQUIPMENT ID (Note 1)

	ADVANCED HORIZONTAL STORAGE MODULE (AHSM)		DRY SHIELDED CANISTERS (DSC)		
PAD LOCATION	AHSM EQUIPMENT ID	AHSM AS-BUILT PACKAGE	DSC EQUIPMENT ID	DSC SERIAL NUMBER	DSC AS-BUILT PACKAGE
1A	S123220BAHSM001	RSO-1915-03	S12208MVDSC003	24PT1-SO1-S003	RSO-1833-03
1B	S123220BAHSM002	RSO-1915-03	S12208MVDSC007	24PT1-SO1-S007	RSO-1957-03
1C	S123220BAHSM003	RSO-1915-03	S12208MVDSC005	24PT1-SO1-S005	RSO-1959-03
1D	S123220BAHSM004	RSO-2543-03	S12208MVDSC006	24PT1-SO1-S006	RSO-2311-03
1E	S123220BAHSM005	RSO-2703-03	S12208MVDSC009	24PT1-SO1-S009	RSO-2537-03
1F	S123220BAHSM006	RSO-0730-04	S12208MVDSC008	24PT1-SO1-S008	RSO-0003-04
1G	S123220BAHSM007	RSO-0730-04	S12208MVDSC011	24PT1-SO1-S011	RSO-0383-04
1H	S123220BAHSM008	RSO-0730-04	S12208MVDSC010	24PT1-SO1-S010	RSO-0875-04
1I	S123220BAHSM009	RSO-0730-04	S12208MVDSC012	24PT1-SO1-S012	RSO-0876-04
1J	S123220BAHSM010	RSO-0730-04	S12208MVDSC014	24PT1-SO1-S014	RSO-1071-04
1K	S123220BAHSM011	RSO-0730-04	S12208MVDSC015	24PT1-SO1-S015	RSO-1332-04
1L	S123220BAHSM012	RSO-0730-04	S12208MVDSC013	24PT1-SO1-S013	RSO-1333-04
1M	S123220BAHSM013	RSO-0730-04	S12208MVDSC016	24PT1-SO1-S016	RSO-1747-04
1N	S123220BAHSM014	RSO-1829-04	S12208MVDSC017	24PT1-SO1-S017	RSO-1851-04
1O	S123220BAHSM015	RSO-1829-04	S12208MVDSC018	GTCC-SO1-S018	RSO-1853-04
1P	S123220BAHSM016	RSO-0730-04	S12208MVDSC002	24PT1-SO1-S002	RSO-0112-05
1Q	S123220BAHSM017	RSO-1829-04	S12208MVDSC004	24PT1-SO1-S004	RSO-0349-05
1R	S123220BAHSM018	RSO-1829-04	S12208MVDSC001	24PT1-SO1-S001	RSO-0396-05
1S	S123220BAHSM019				
1T	S123220BAHSM020				
1U	S123220BAHSM021				
1V	S123220BAHSM022				
1W	S123220BAHSM023				
1X	S123220BAHSM024				
1Y	S123220BAHSM025				
1Z	S123220BAHSM026				
1AA	S123220BAHSM027				
1AB	S123220BAHSM028				
1AC	S123220BAHSM029				
1AD	S123220BAHSM030				
1AE	S123220BAHSM031				

NOTES:

1. COMPONENT IDs WILL BE ADDED AS AHSMS ARE INSTALLED AND AS DSCs ARE LOADED INTO THE AHSMS.
2. DEPICTS POST DECOMMISSIONING STATE OF NORTH INDUSTRIAL AREA.

DRAWING NUMBER	DESCRIPTION
28002	ISFSI PHASE 1
21058	SYWR TOW
21042	SLW TREAT PL
5183284	RADWASTE BLDG
40052	GEN ARR
U1-C-0209	UNIDENT UTLT
5173293	FWTR TRENCH
SO1-027-1-0187	ASHW GEN ARRG
5173003	FWTR STOR TK
5183255	WAIWT BLDG
36001	ISFSI CAMERA
28006	ISFSI SEC FNC
28015 SH 1 & SH 2	ELECTR PLATF
SO1-027-1-0143	DSC MAIN ASSY

REFERENCES

NO	DESCRIPTION	RE	IRE	FLS	ORIG	CHK	OTHER	DATE
4	INCORP. ECN A28518				MJK	KGO	DCMS	02/14/07

REVISIONS

QC I — UNITS 1,2 & 3

SAN ONOFRE NUCLEAR GENERATING STATION

NORTH INDUSTRIAL AREA
GENERAL ARRANGEMENT

SOUTHERN CALIFORNIA EDISON

Scale: NONE — DRAWN BY: W. KIERZIE

M.REVIEW — DCMS STATUS = APRV FEBRUARY 14, 2007 13:36

40028 — REV 4

Amended: June 2010