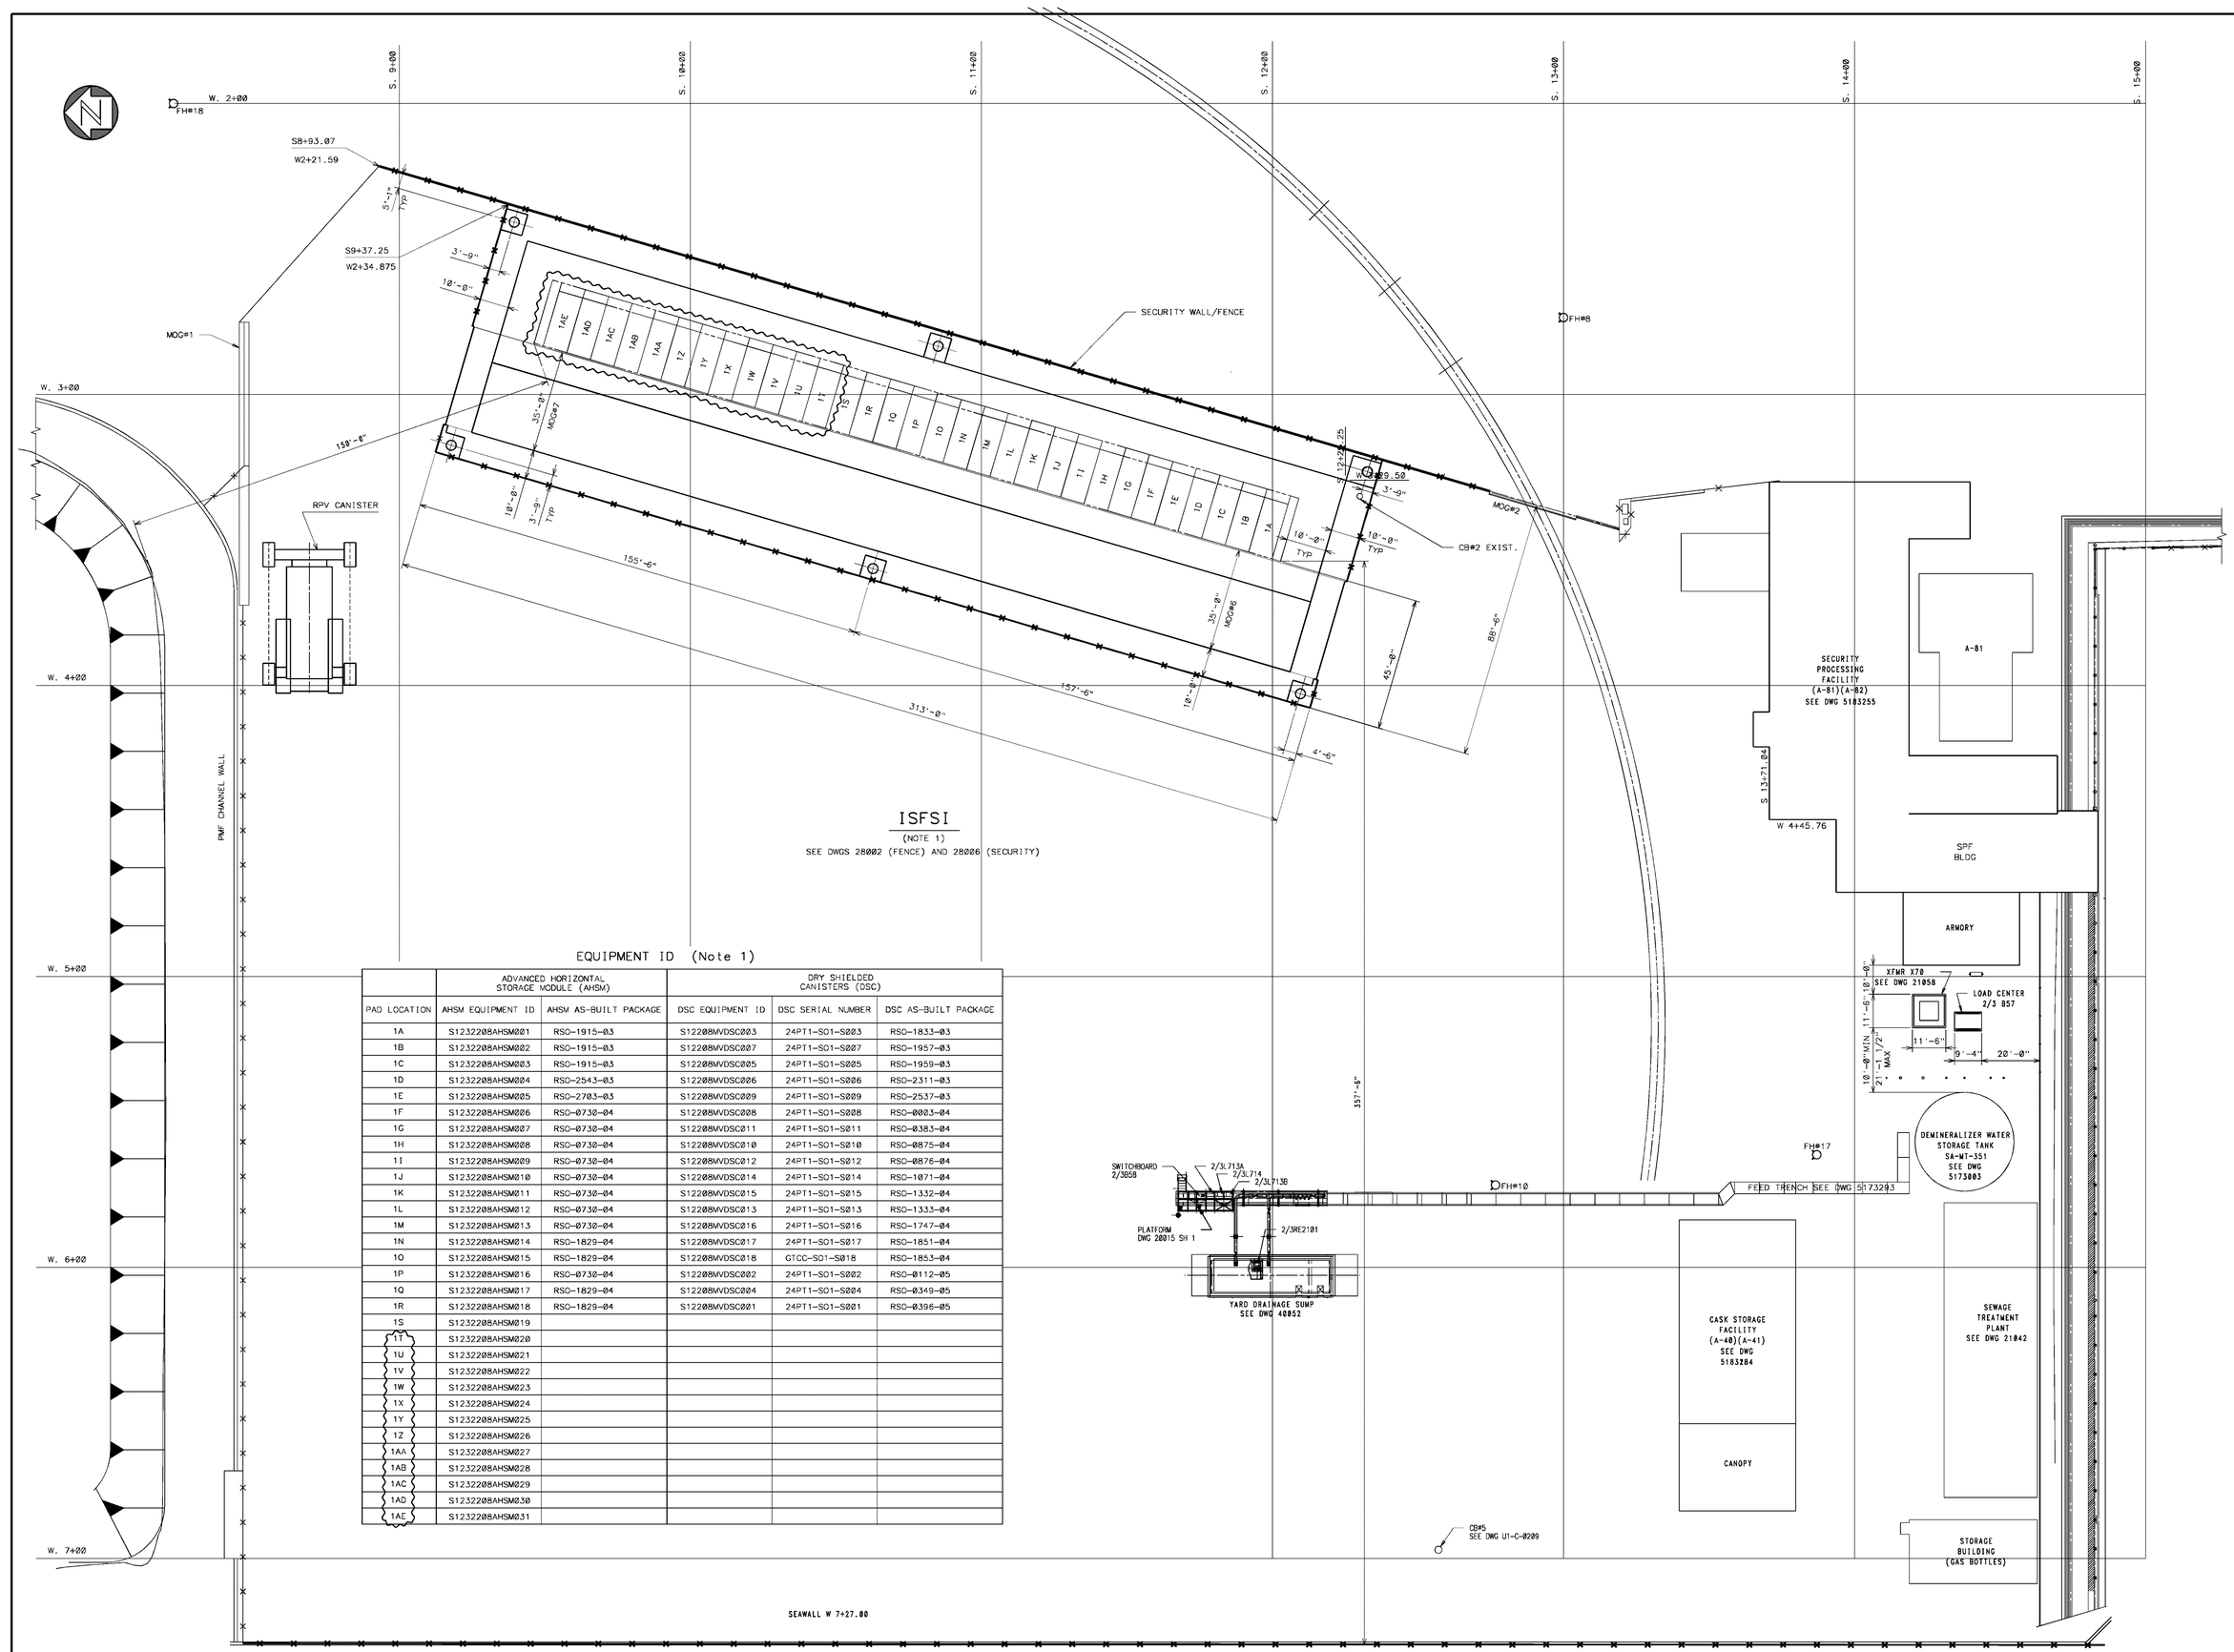

ISFSI

(NOTE 1)

SEE DWGS 28002 (FENCE) AND 28006 (SECURITY)

EQUIPMENT ID (Note 1)

	ADVANCED HORIZONTAL STORAGE MODULE (AHSM)		DRY SHIELDED CANISTERS (DSC)		
PAD LOCATION	AHSM EQUIPMENT ID	AHSM AS-BUILT PACKAGE	DSC EQUIPMENT ID	DSC SERIAL NUMBER	DSC AS-BUILT PACKAGE
1A	S123220BAHSM001	RSC-1915-03	S1220BMVDSC003	24PT1-SO1-S003	RSC-1833-03
1B	S123220BAHSM002	RSC-1915-03	S1220BMVDSC007	24PT1-SO1-S007	RSC-1957-03
1C	S123220BAHSM003	RSC-1915-03	S1220BMVDSC005	24PT1-SO1-S005	RSC-1959-03
1D	S123220BAHSM004	RSC-2543-03	S1220BMVDSC006	24PT1-SO1-S006	RSC-2311-03
1E	S123220BAHSM005	RSC-2703-03	S1220BMVDSC009	24PT1-SO1-S009	RSC-2537-03
1F	S123220BAHSM006	RSC-0730-04	S1220BMVDSC008	24PT1-SO1-S008	RSC-0003-04
1G	S123220BAHSM007	RSC-0730-04	S1220BMVDSC011	24PT1-SO1-S011	RSC-0383-04
1H	S123220BAHSM008	RSC-0730-04	S1220BMVDSC010	24PT1-SO1-S010	RSC-0875-04
1I	S123220BAHSM009	RSC-0730-04	S1220BMVDSC012	24PT1-SO1-S012	RSC-0876-04
1J	S123220BAHSM010	RSC-0730-04	S1220BMVDSC014	24PT1-SO1-S014	RSC-1071-04
1K	S123220BAHSM011	RSC-0730-04	S1220BMVDSC015	24PT1-SO1-S015	RSC-1332-04
1L	S123220BAHSM012	RSC-0730-04	S1220BMVDSC013	24PT1-SO1-S013	RSC-1333-04
1M	S123220BAHSM013	RSC-0730-04	S1220BMVDSC016	24PT1-SO1-S016	RSC-1747-04
1N	S123220BAHSM014	RSC-1829-04	S1220BMVDSC017	24PT1-SO1-S017	RSC-1851-04
1O	S123220BAHSM015	RSC-1829-04	S1220BMVDSC018	GTCC-SO1-S018	RSC-1853-04
1P	S123220BAHSM016	RSC-0730-04	S1220BMVDSC002	24PT1-SO1-S002	RSC-0112-05
1Q	S123220BAHSM017	RSC-1829-04	S1220BMVDSC004	24PT1-SO1-S004	RSC-0349-05
1R	S123220BAHSM018	RSC-1829-04	S1220BMVDSC001	24PT1-SO1-S001	RSC-0396-05
1S	S123220BAHSM019				
1T	S123220BAHSM020				
1U	S123220BAHSM021				
1V	S123220BAHSM022				
1W	S123220BAHSM023				
1X	S123220BAHSM024				
1Y	S123220BAHSM025				
1Z	S123220BAHSM026				
1AA	S123220BAHSM027				
1AB	S123220BAHSM028				
1AC	S123220BAHSM029				
1AD	S123220BAHSM030				
1AE	S123220BAHSM031				

NOTES:

1. COMPONENT IDs WILL BE ADDED AS AHSMS ARE INSTALLED AND AS DSCs ARE LOADED INTO THE AHSMS.
2. DEPICTS POST DECOMMISSIONING STATE OF NORTH INDUSTRIAL AREA.

DRAWING NUMBER	DESCRIPTION
28002	ISFSI PHASE 1
21058	SYWR TCN
21042	SEW TREAT PL
5183284	RADWASTE BLDG
40052	GEN ARR
U1-C-0209	UNIDENT UTLT
5173293	FWTR TRENCH
SO1-I207+1-0187	ASHW GEN ARRG
5173003	FWTR STOR TK
5183255	MAINT BLDG
36001	ISFSI CAMERA
28006	ISFSI SEC TRC
20015 SH 1 & SH 2	ELECTR PLATF
SO1-I207+1-0143	DSC MAIN ASSY

M.REVIEW — DCMS STATUS = APRV FEBRUARY 14, 2007 13:36

REFERENCES

NO	DESCRIPTION	RE	IRE	FLS	ORIG	CHK	OTHER	DATE
4	INCORP. ECN A28518				MJK	KGD		DCMS 02/14/07

REVISIONS

QC I — UNITS 1,2 & 3

SAN ONOFRE NUCLEAR GENERATING STATION

NORTH INDUSTRIAL AREA
GENERAL ARRANGEMENT

SCE — SOUTHERN CALIFORNIA EDISON

Scale: NONE — DRAWN BY: W. KERZIE

40028 — REV 4

Amended: June 2010