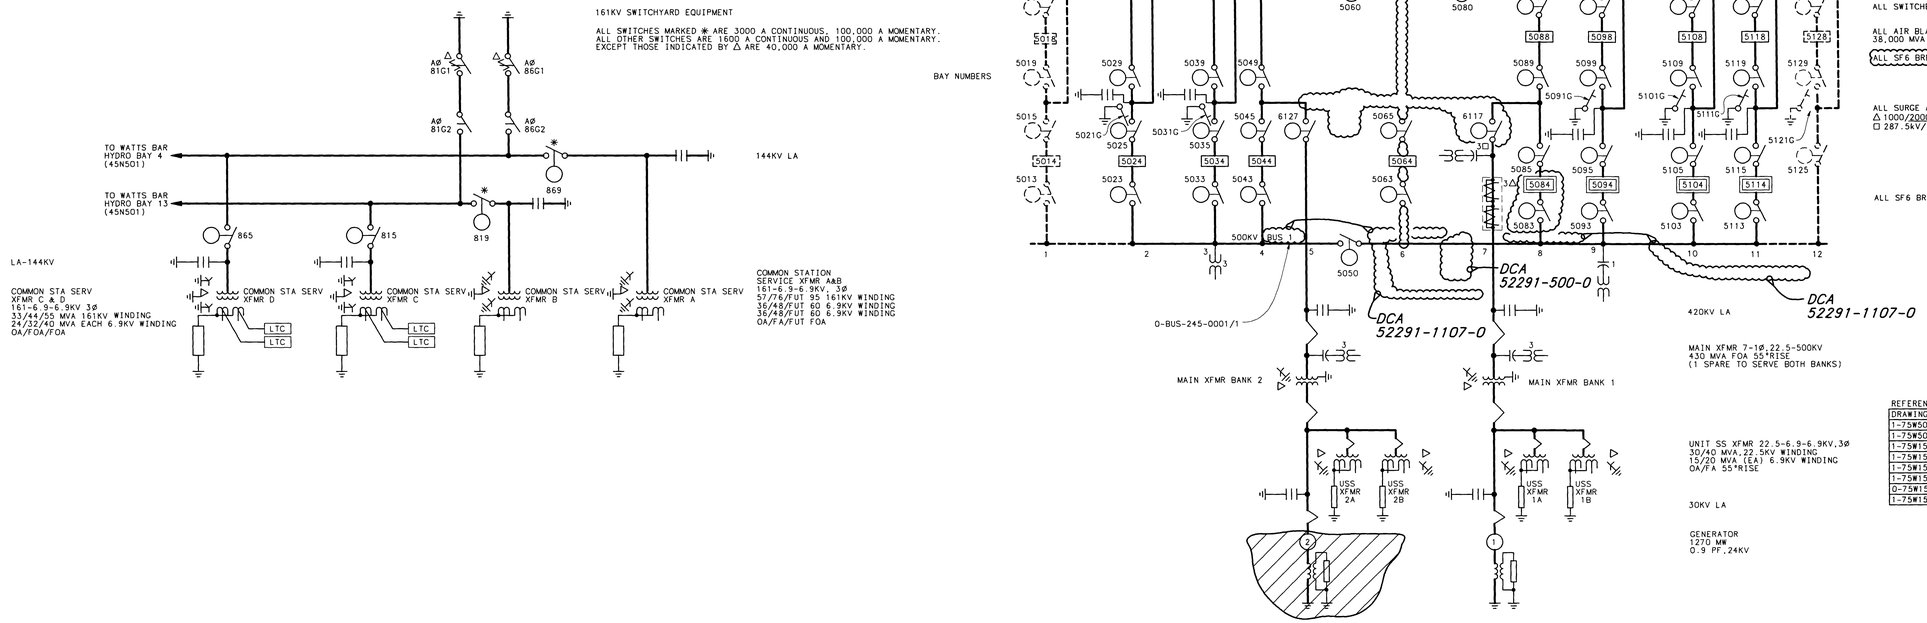

REFERENCE DRAWINGS:

DRAWING NO.	TITLE
1-75W502	161KV TRANSFORMERS MAIN SINGLE LINE
1-75W503	161KV TRANSFORMERS MAIN SINGLE LINE
1-75W1505	500KV SWITCHYARD MAIN SINGLE LINE
1-75W1506	500KV SWITCHYARD MAIN SINGLE LINE
1-75W1507	500KV SWITCHYARD MAIN SINGLE LINE
1-75W1508	500KV SWITCHYARD MAIN SINGLE LINE
0-75W1508-1	500KV SWITCHYARD MAIN SINGLE LINE
1-75W1509	500KV SWITCHYARD MAIN SINGLE LINE

FSAR FIG 8.2-1

THIS CONFIGURATION CONTROL DRAWING SUPERSEDES UNIT 1 AS-CONSTRUCTED DRAWING 75N500 REVISION J.

REV	CHANGE REF	PREPARER	CHECKER	APPROVED	DATE
18	52290/52291	RWE	ESJ	JKD	DTS

REVISED PER DCA'S 52290-01-0, -14-0, -16-0, -29-0, -132-0, 52291-500-0 AND -1107-0.

SCALE: NTS — EXCEPT AS NOTED

PROJECT FACILITY
POWERHOUSE
UNITS 1 & 2

TITLE
WIRING DIAGRAM DEVELOPMENT SINGLE LINE

1 — WATTS BAR NUCLEAR PLANT — TENNESSEE VALLEY AUTHORITY — N

DESIGN		INITIAL ISSUE	ENGINEERING APPROVAL
DRAFTER JEA/CNC	CHECKER J.D. MOYERS	RO ISSUE PER WBEP 5.17 & RIMS B26 '91 0129 377	1 S.M. ENRIQUEZ
DESIGNER MLC/MEB	REVIEWER R.L. FORESTER		2 S.G. HSIA
			3 C.C. LYKE FOR MCB

ISSUED BY: R.M. JOHNSON FOR WLE

DATE 5-31-91 | 85 | E | 1-75W500 | R18

PRINTS REQ'D R ____ PRINT SIZE F BR OR PROJ AB CE EE ME NE FE HE SE TE BL BF WB SQ — PRINT SIZE H BR OR PROJ AB CE EE ME NE FE HE SE TE BL BF WB SQ

CAD MAINTAINED DRAWING

CONFIGURATION CONTROL DRAWING