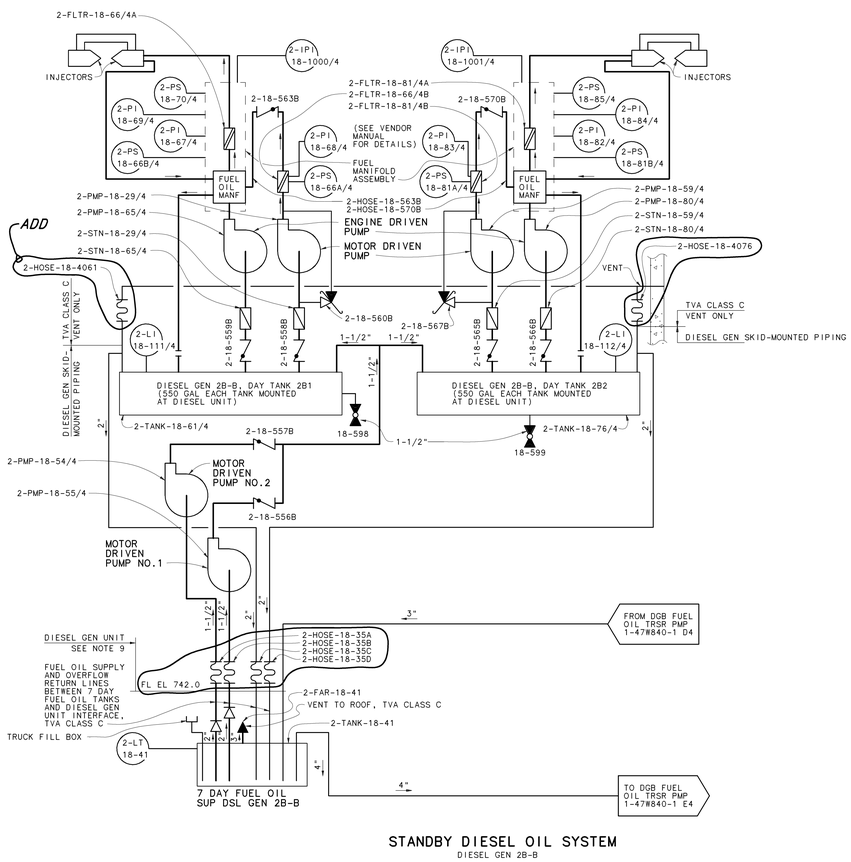

STANDBY DIESEL OIL SYSTEM

DIESEL GEN 2B-B

NOTES:

FOR GENERAL NOTES AND REFERENCE DRAWINGS SEE 1-47W840-1.

THIS CONFIGURATION CONTROL DRAWING SUPERSEDES UNIT 1 AS-CONSTRUCTED DRAWING 47W840-1 REVISION EE.

REV	CHANGE REF	PREPARER	CHECKER	APPROVED	DATE
11	50713 ADMIN	MAF	JEW	GJB	2-23-01

REVISED PER DCA 50713-07-0. DELETED SYSTEM BOUNDARY PER ADMIN.

SCALE: NTS — EXCEPT AS NOTED

PROJECT FACILITY
DIESEL GENERATOR BUILDING
UNIT 2

TITLE
FLOW DIAGRAM
FUEL OIL
ATOMIZING AIR & STEAM

1 — WATTS BAR NUCLEAR PLANT, TENNESSEE VALLEY AUTHORITY — Q

DESIGN		INITIAL ISSUE	ENGINEERING APPROVAL
DRAFTER J.K. ADAMS,JR.	CHECKER J.G. LOWE	RO ISSUE PER WBEP 5.17 & RIMS B26 '90 0620 376	1 L.S. CHAUNCEY
DESIGNER M.L. CHAPMAN	REVIEWER H.N.BENNINGHOFF,JR.		2 M.P. WASSOM
			3 L.W. BOYD

COMPANION DRAWINGS:
1-47W840-1A
1-47W840-2

ISSUED BY: R.M. JOHNSON/WLE

DATE 9-17-90 | 85 | M | 1-47W840-1B | R11

PRINTS REQ'D R ____ PRINT SIZE F BR OR PROJ AB CE EE ME NE FE HE SE TE BL BF WB SQ — PRINT SIZE H BR OR PROJ AB CE EE ME NE FE HE SE TE BL BF WB SQ

CAD MAINTAINED DRAWING

CONFIGURATION CONTROL DRAWING