133D9133 2A

REVISIONS		
5	NJ38894	11/29/84
6	NJ44534	11/23/03

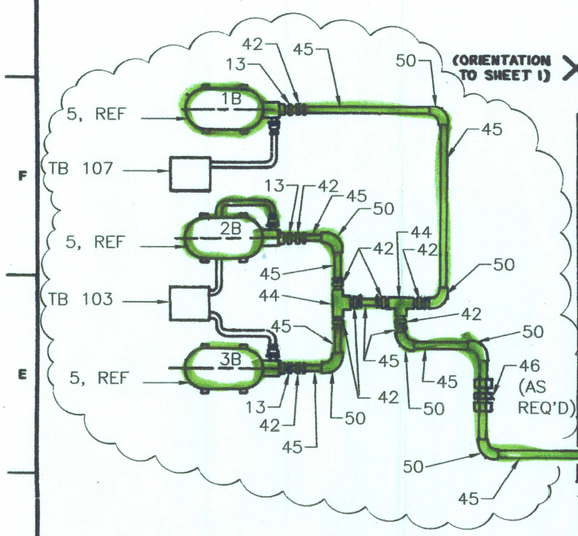

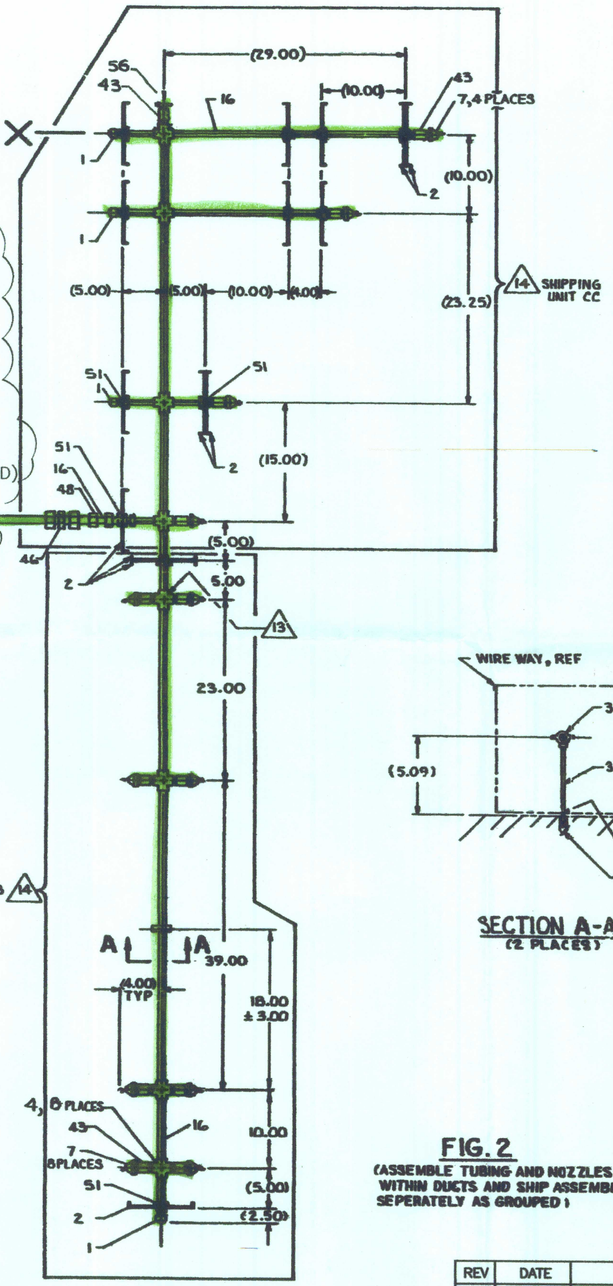

FIG. 2
(ASSEMBLE TUBING AND NOZZLES WITHIN DUCTS AND SHIP ASSEMBLIES SEPERATELY AS GROUPED)

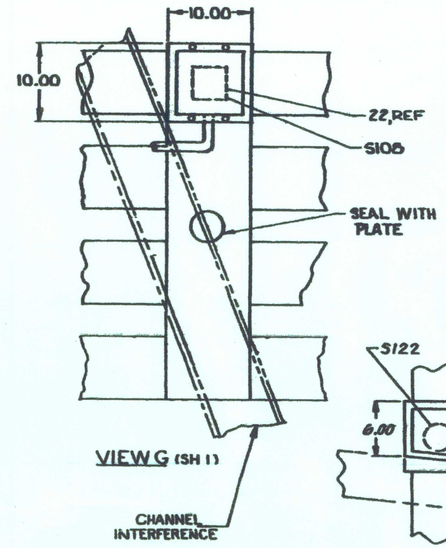

VIEW G (SH 1)

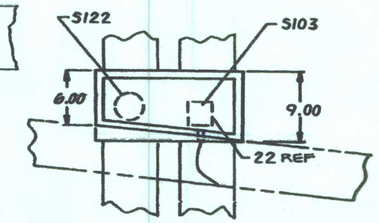

VIEW F (SH1)

NOTE:
1. SEE CVI 02H13-05.221.2 FOR NOZZLE SIZES.

LR NOTES:
A. FOR GENERAL LICENSE RENEWAL NOTES, SEE LR-M501-2.

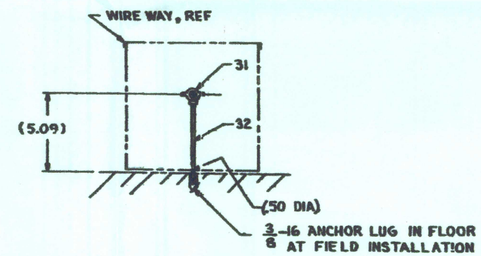

SECTION A-A
(2 PLACES)

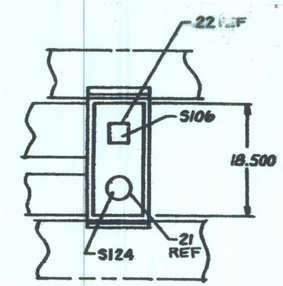

VIEW E (SH. 1)

CONTRACT
Washington Public Power Supply Sys
WPPSS Nuclear Project No. 2
W O 2858
BURNS AND ROE, INC.
ORADELL, N.J.-HEMPSTEAD, N.Y.-LOS ANGELES, CAL.
REVIEWED AS CHECKED BELOW
☐ Approved for Fabrication ..... A
☐ NOT Approved ..... NA
☐ Approved as noted for Fabrication See Acceptance Note Para. T.2. of Appendix A. Section 1 B
☒ For Information Only I
Subject To All Contractual Provisions
This review does not imply acceptance of any material or equipment not fulfilling all specification requirements.
REVIEWED BY DATE

LR-02H13-05.221, 2A
REV. 0

Om Manual 02-01 A56

02-02H13-05	221	9	2A
CVI NO	CVI SHT	REV	DWG SHT

REV	DATE	DESCRIPTION	DWN	CHK	APVD
9	8/4/05	REV PER 03372-208 (D-G/9-11), SCANNED DRAWING.	H.AL	HL	DRJ

DWG No. 133D9133 REV 9
SH No. 2A SHEET 3 OF 3
GENERAL ELECTRIC CI

133D9133 2A

D24